


SOUTHERN FIELD: BEAR VALLEY area
: SKIDMORE VEIN: Hegins Twp. Schuylkill COUNTY, PA.,
STUTZMAN & SCHNECK CO.; ... SUSQUEHANNA Collieries. 1"=100'

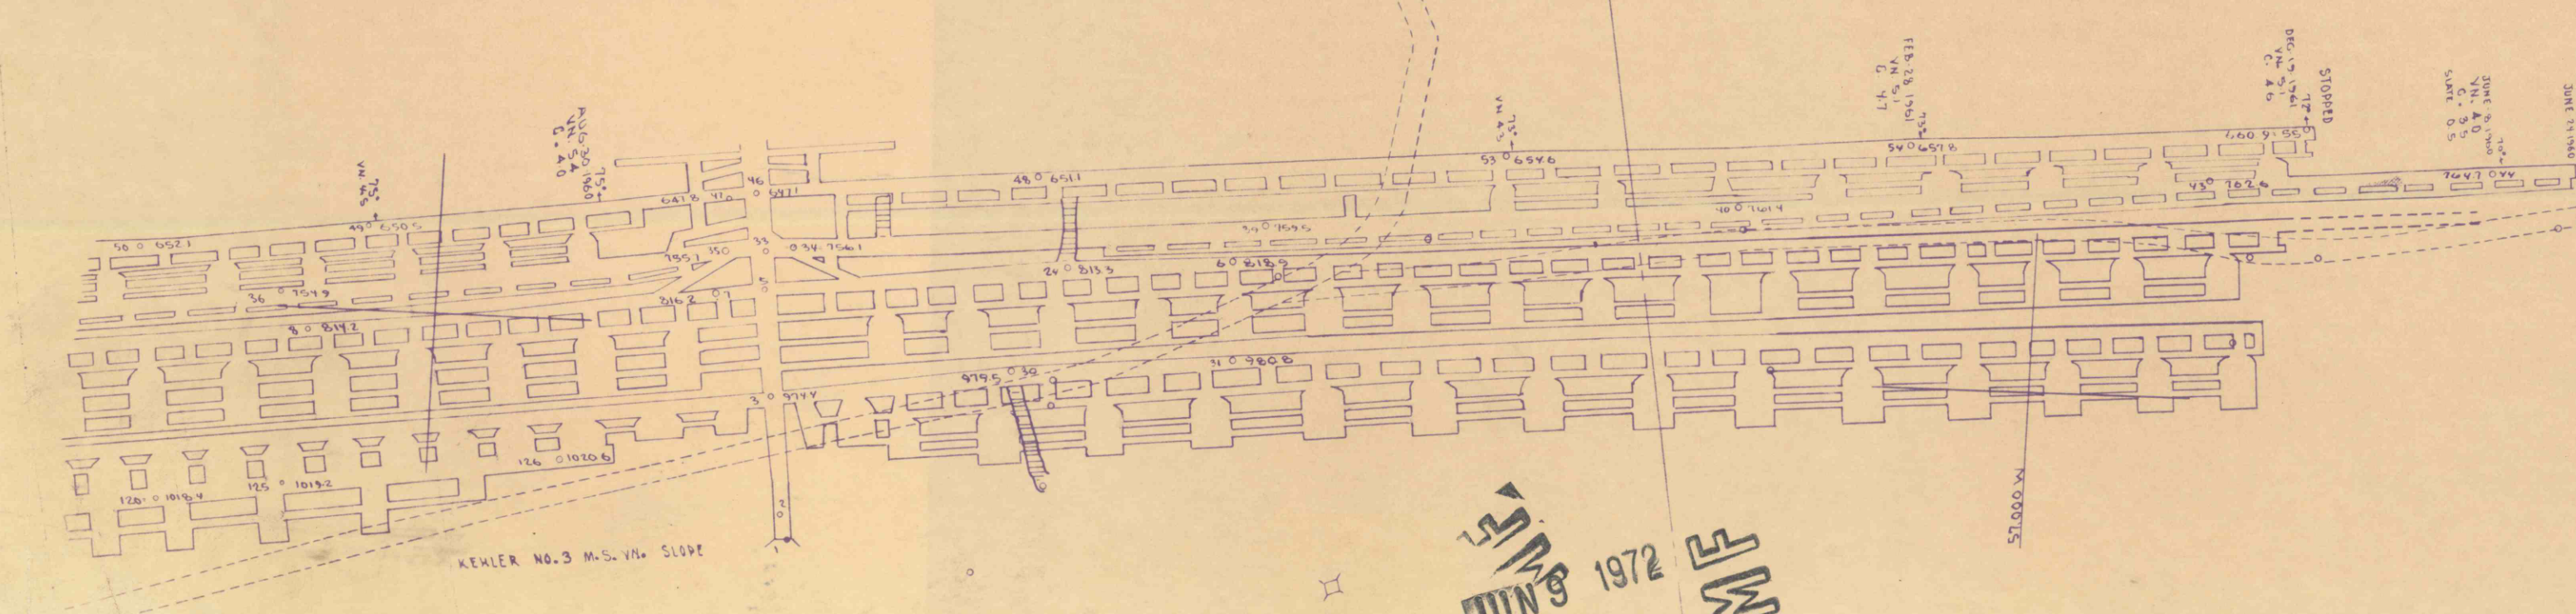

JUN 8 1972