


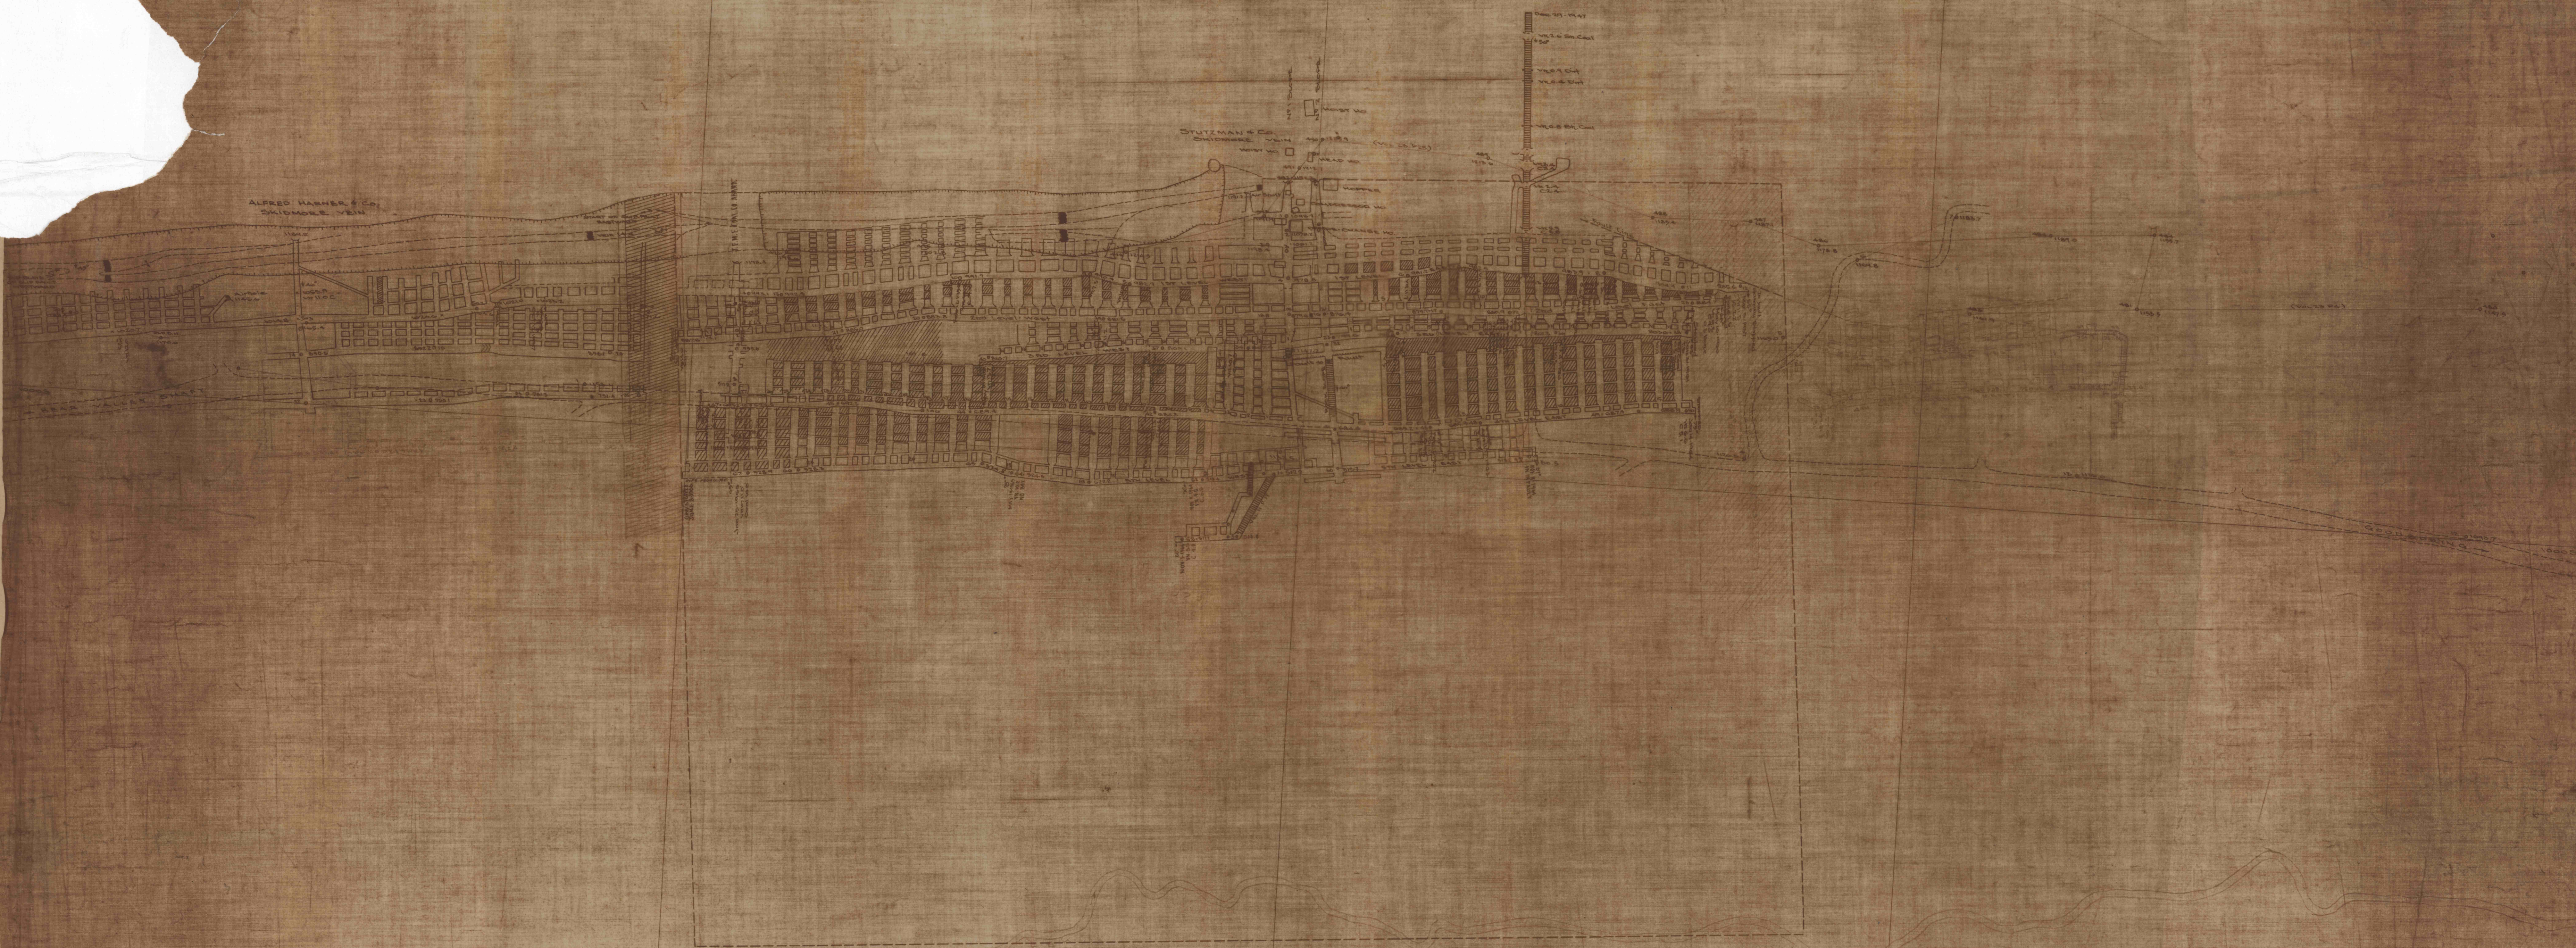

Southern Coal Field.
Bear Valley... AREA... SKIDMORE VEIN,
...HEGINSTUMP SCHUYL COUNTY, PA.,
• STUTZMAN & CO., • ALFRED HARNER & CO.,
SUSQUEHANNA COLLIERIES