


N

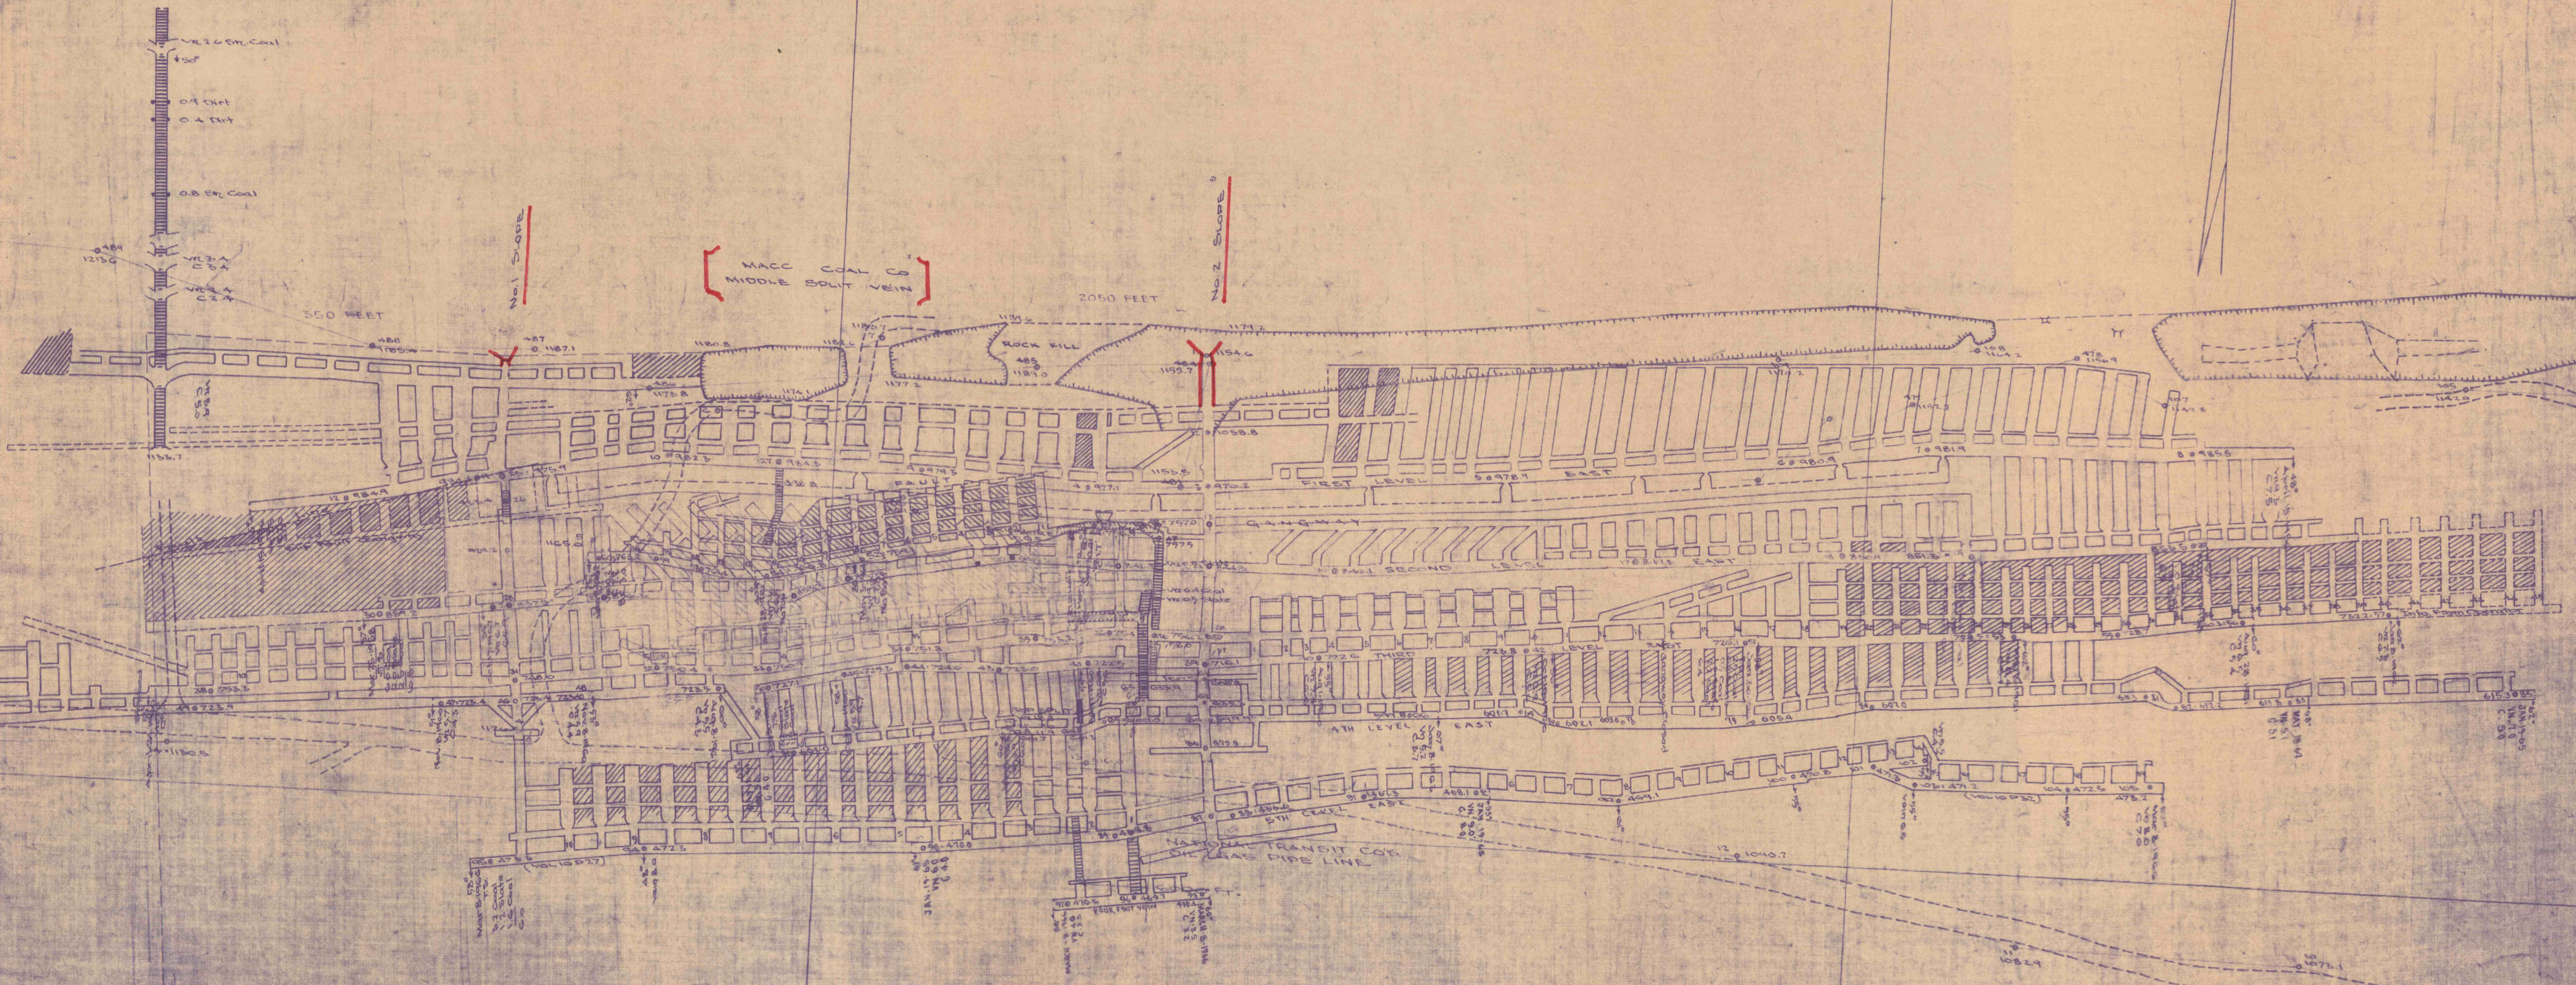

÷ SOUTHERN COAL FIELD ÷
M.A.C.C. COAL CO. MIDDLE-SPLIT & SKIDMORE VNS. 1"=100'
HEGINS TWP., SCHUYLKILL COUNTY, PA.,

50,000 WEST.