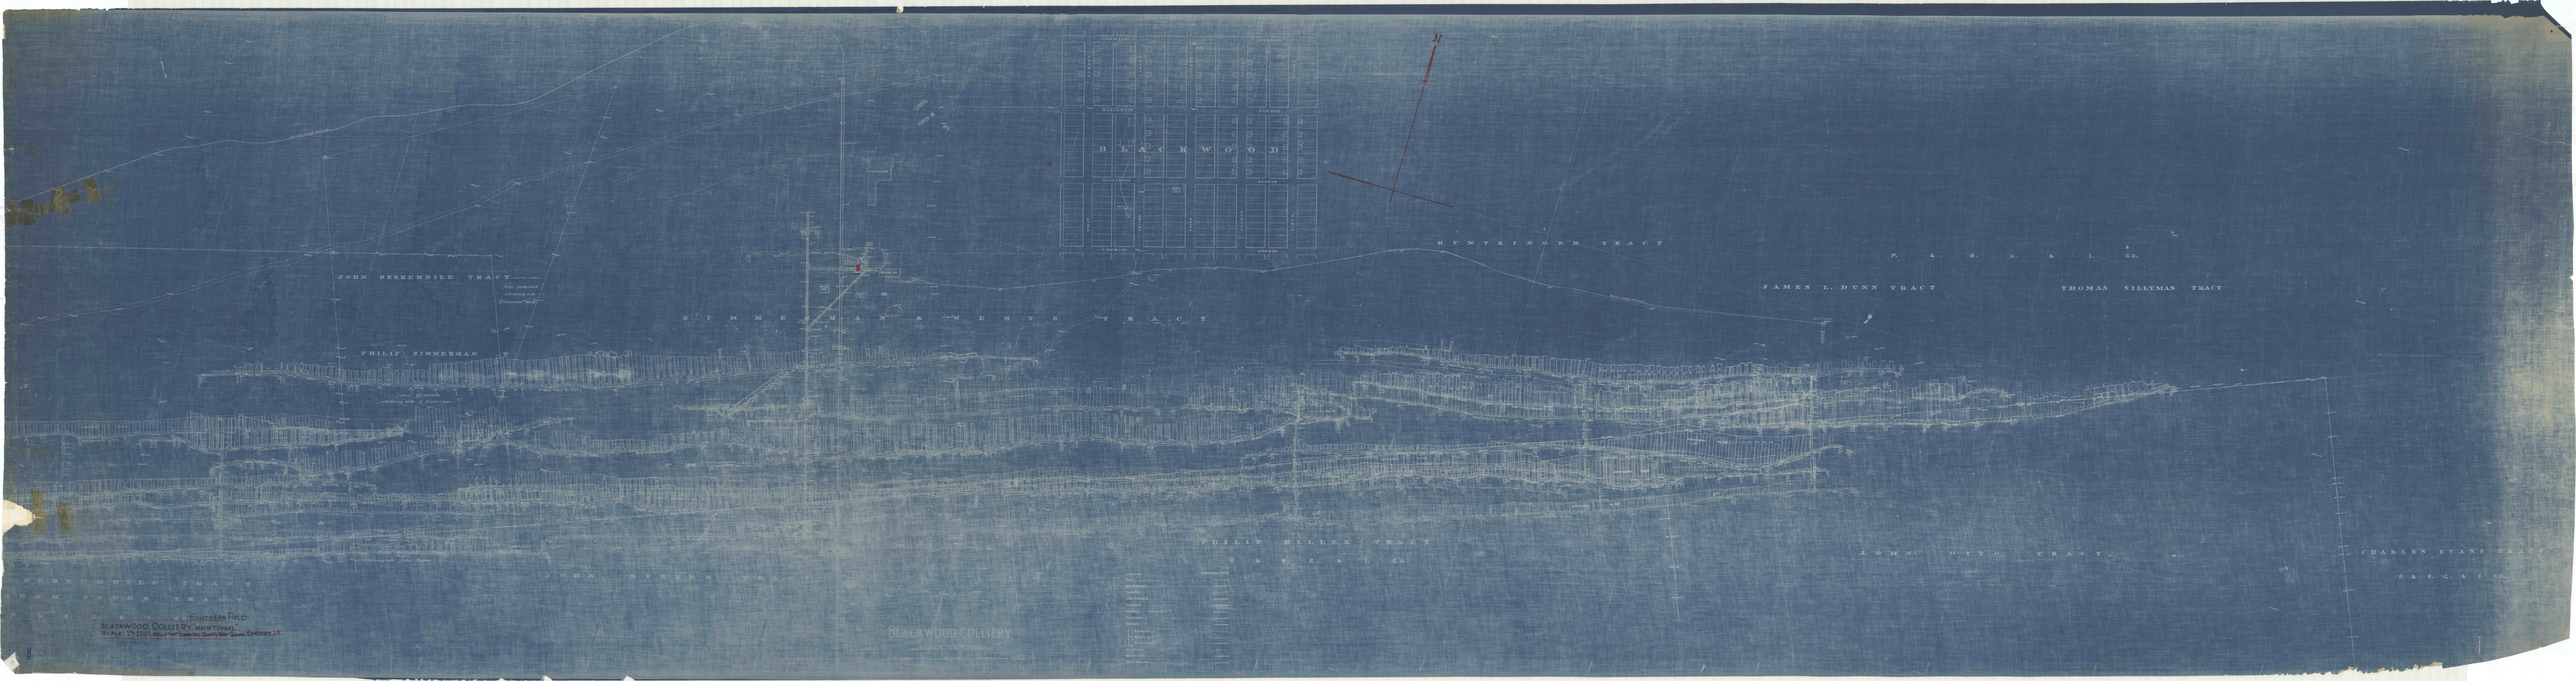

BLACKWOOD
JOHN BERENDILE TRACT
PHILIP ZIMMERMAN
ZIMMERMAN & WENTZ TRACT
HUNTZINGER TRACT
P. & R. C. & I. Co.
JAMES L. DUNN TRACT
THOMAS SILLYMAN TRACT
PHILIP MILLER TRACT
P. & R. C. & I. Co.
JOHN OTTO TRACT
CHARLES EVANS TRACT
P. & R. C. & I. Co.
JOHN SNYDER TRACT
HENRY SNYDER TRACT
JOHN SNYDER TRACT
Southern Field
Blackwood Colliery, Main Tunnel
Scale 1" = 100'
Blackwood Colliery