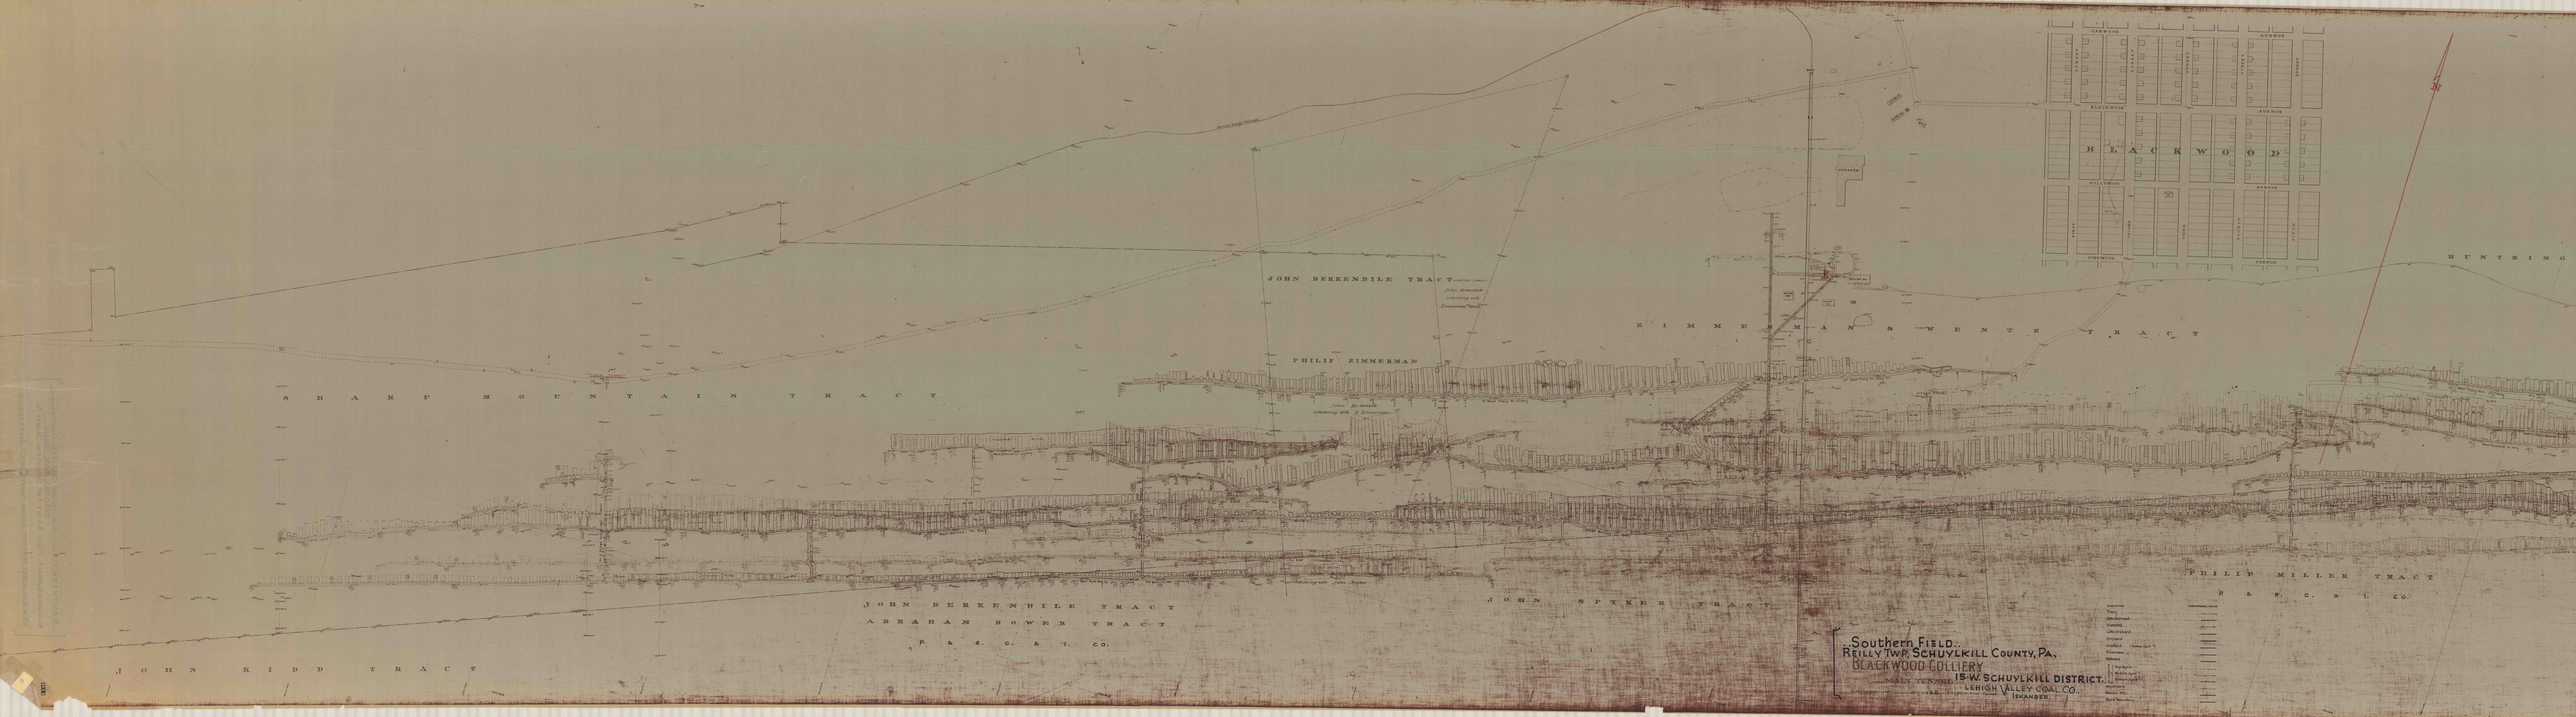

JOHN BERKENBILE TRACT
PHILIP ZIMMERMAN
SHARP MOUNTAIN TRACT
ZIMMERMAN & WENTZ TRACT
JOHN BERKENBILE TRACT
ABRAHAM BOWER TRACT
P. & R. C. & I. CO.
JOHN SPYKER TRACT
JOHN KIDD TRACT
PHILIP MILLER TRACT
P. & R. C. & I. CO.
BLACKWOOD
HUNTZING
Southern Field.
Reilly Twp. Schuylkill County, Pa.
Blackwood Colliery
15-W. Schuylkill District.
Lehigh Valley Coal Co.