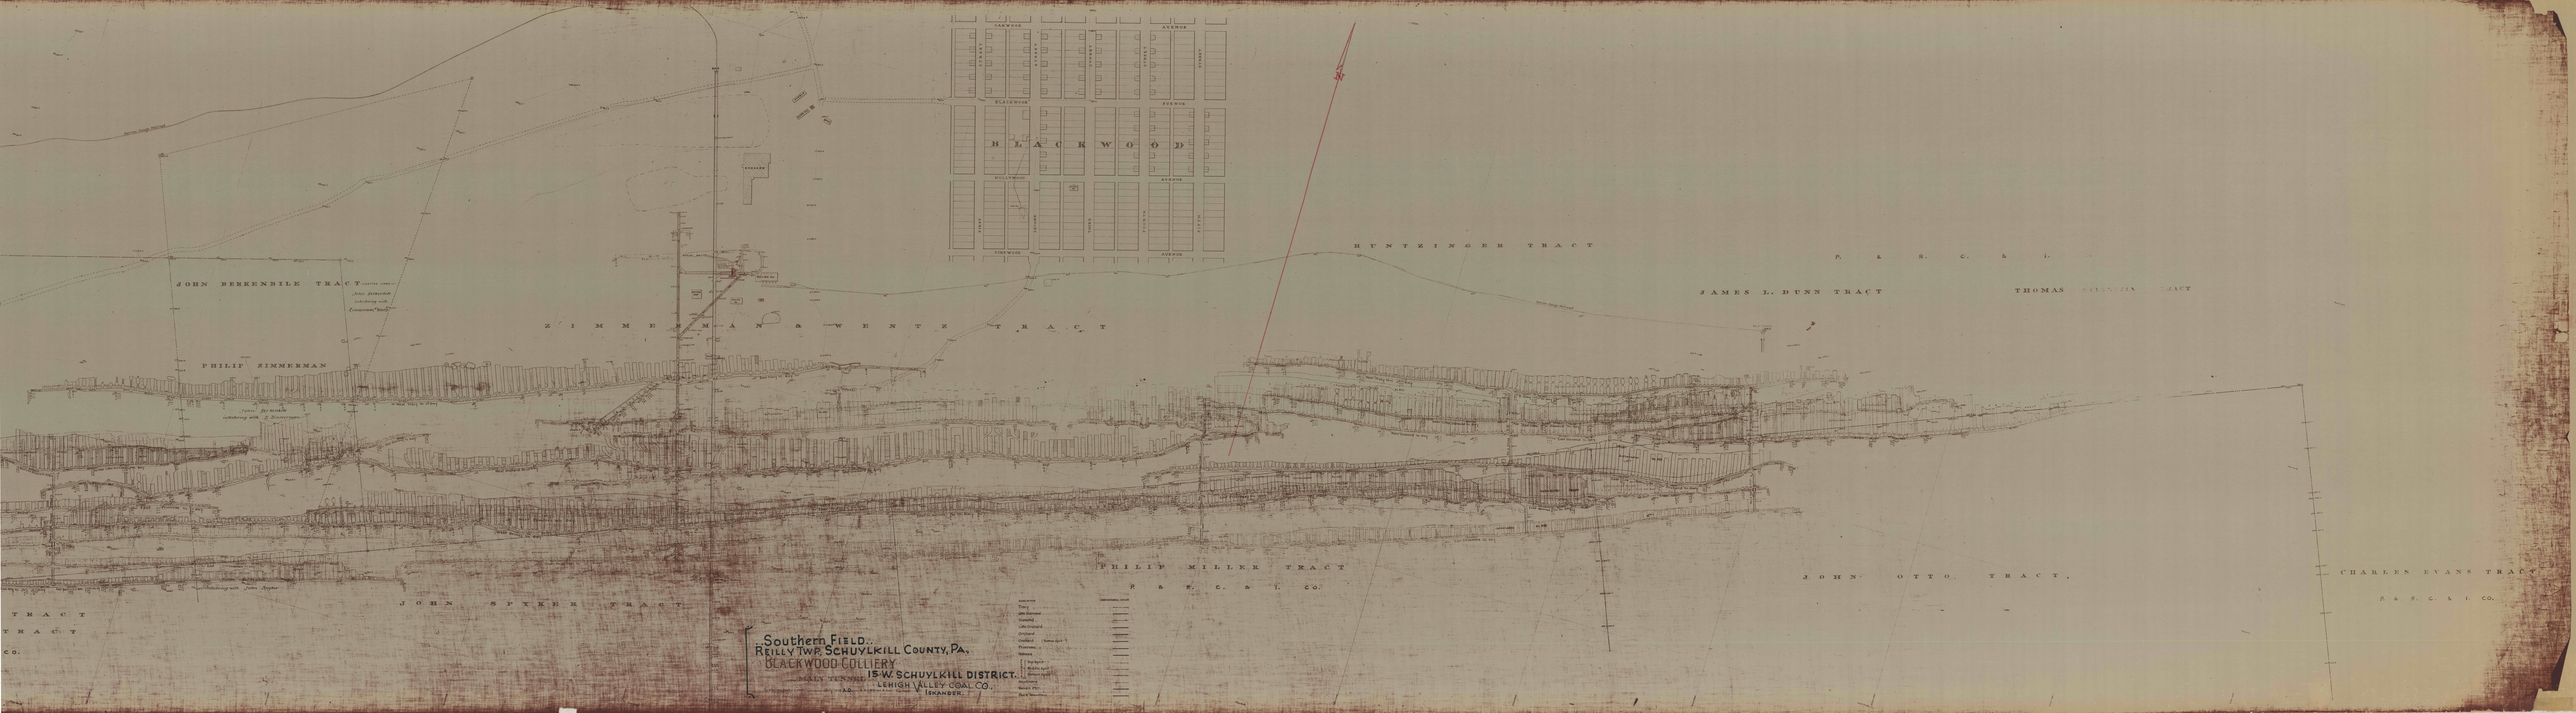
BLACKWOOD
JOHN BERKENBILE TRACT
PHILIP ZIMMERMAN
ZIMMERMAN & WENTZ TRACT
HUNTZINGER TRACT
JAMES L. DUNN TRACT
PHILIP MILLER TRACT
P. & R. C. & I. CO.
JOHN SPYKER TRACT
JOHN OTTO TRACT
CHARLES EVANS TRACT
Southern Field.
REILLY TWP. SCHUYLKILL COUNTY, PA.
BLACKWOOD COLLIERY
15 W. SCHUYLKILL DISTRICT.
LEHIGH VALLEY COAL CO.