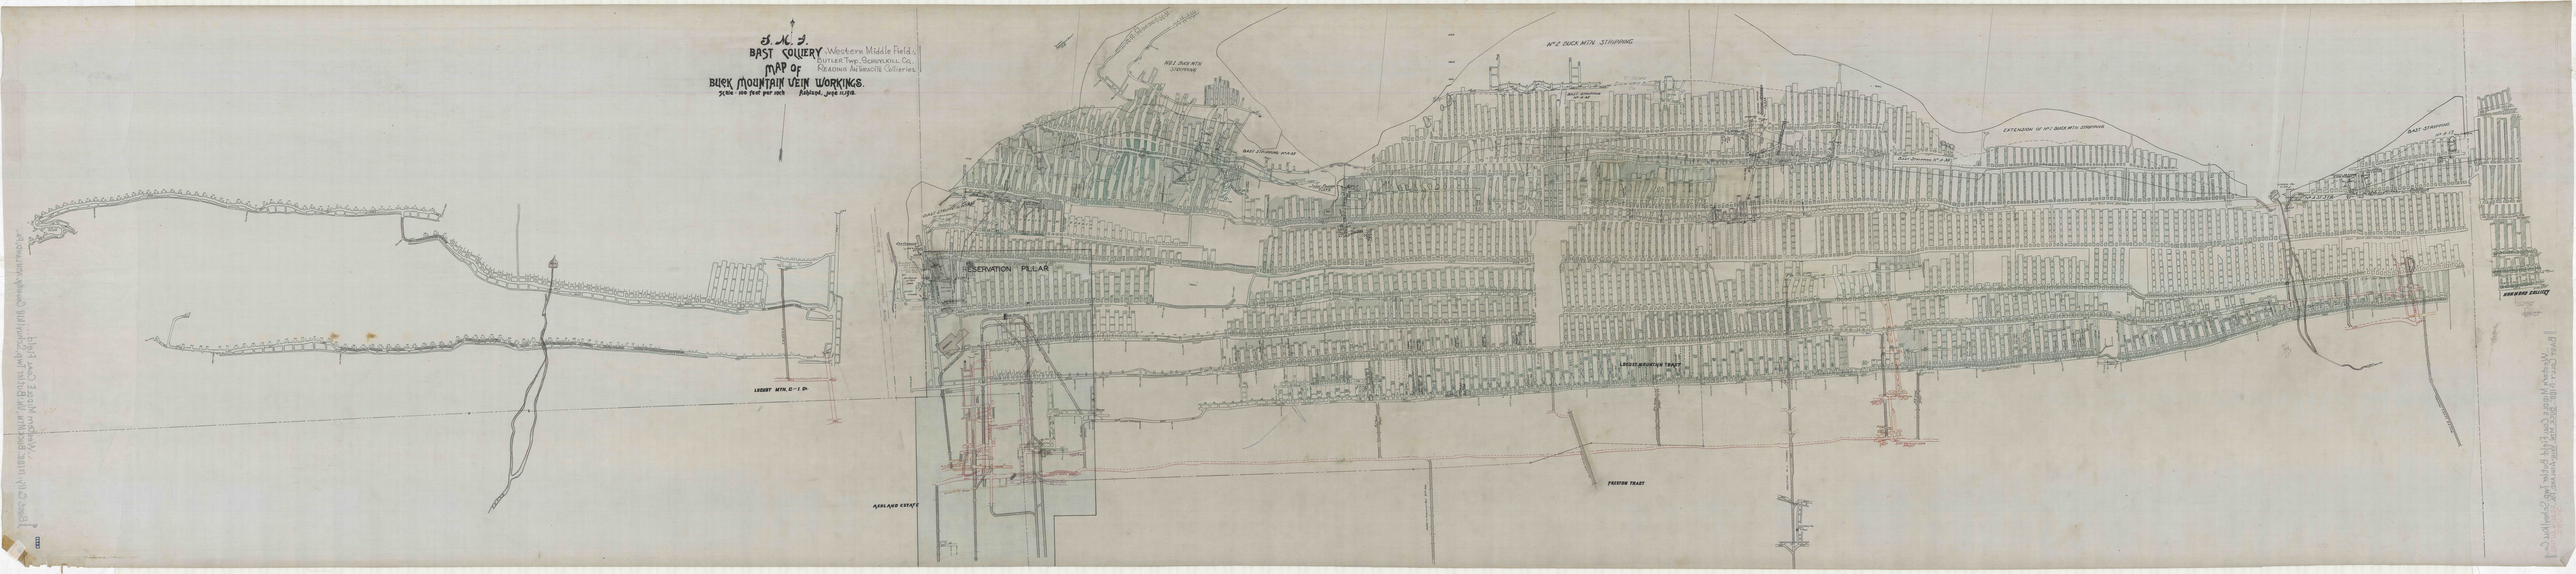
B. M. J.
BAST COLLIERY (Western Middle Field.)
BUTLER Twp. SCHUYLKILL Co.
READING ANTHRACITE Collieries.
MAP OF
BUCK MOUNTAIN VEIN WORKINGS.
Scale - 100 feet per inch
No 2 BUCK MTN. STRIPPING
No 1 BUCK MTN. STRIPPING
BAST STRIPPING No 1 & 2
No 2 BUCK MTN. STRIPPING
EXTENSION OF No 2 BUCK MTN. STRIPPING
BAST STRIPPING No 2 & No 3
BAST STRIPPING No 3 & 4
BREAKER
BREAKER CULM BANK
LOCUST MTN. COAL
LOCUST MOUNTAIN TRACT
