



BAST COLLIERY
 WESTERN MIDDLE COAL FIELD... BUTLER TWP, SCHUYLKILL COUNTY,
 MAP OF ASHLAND, PA.
HOLMES VEIN WORKINGS.
 Scale - 100 feet per inch. Ashland, Feb. 18, 1918.
 Office of Div. Eng'r.

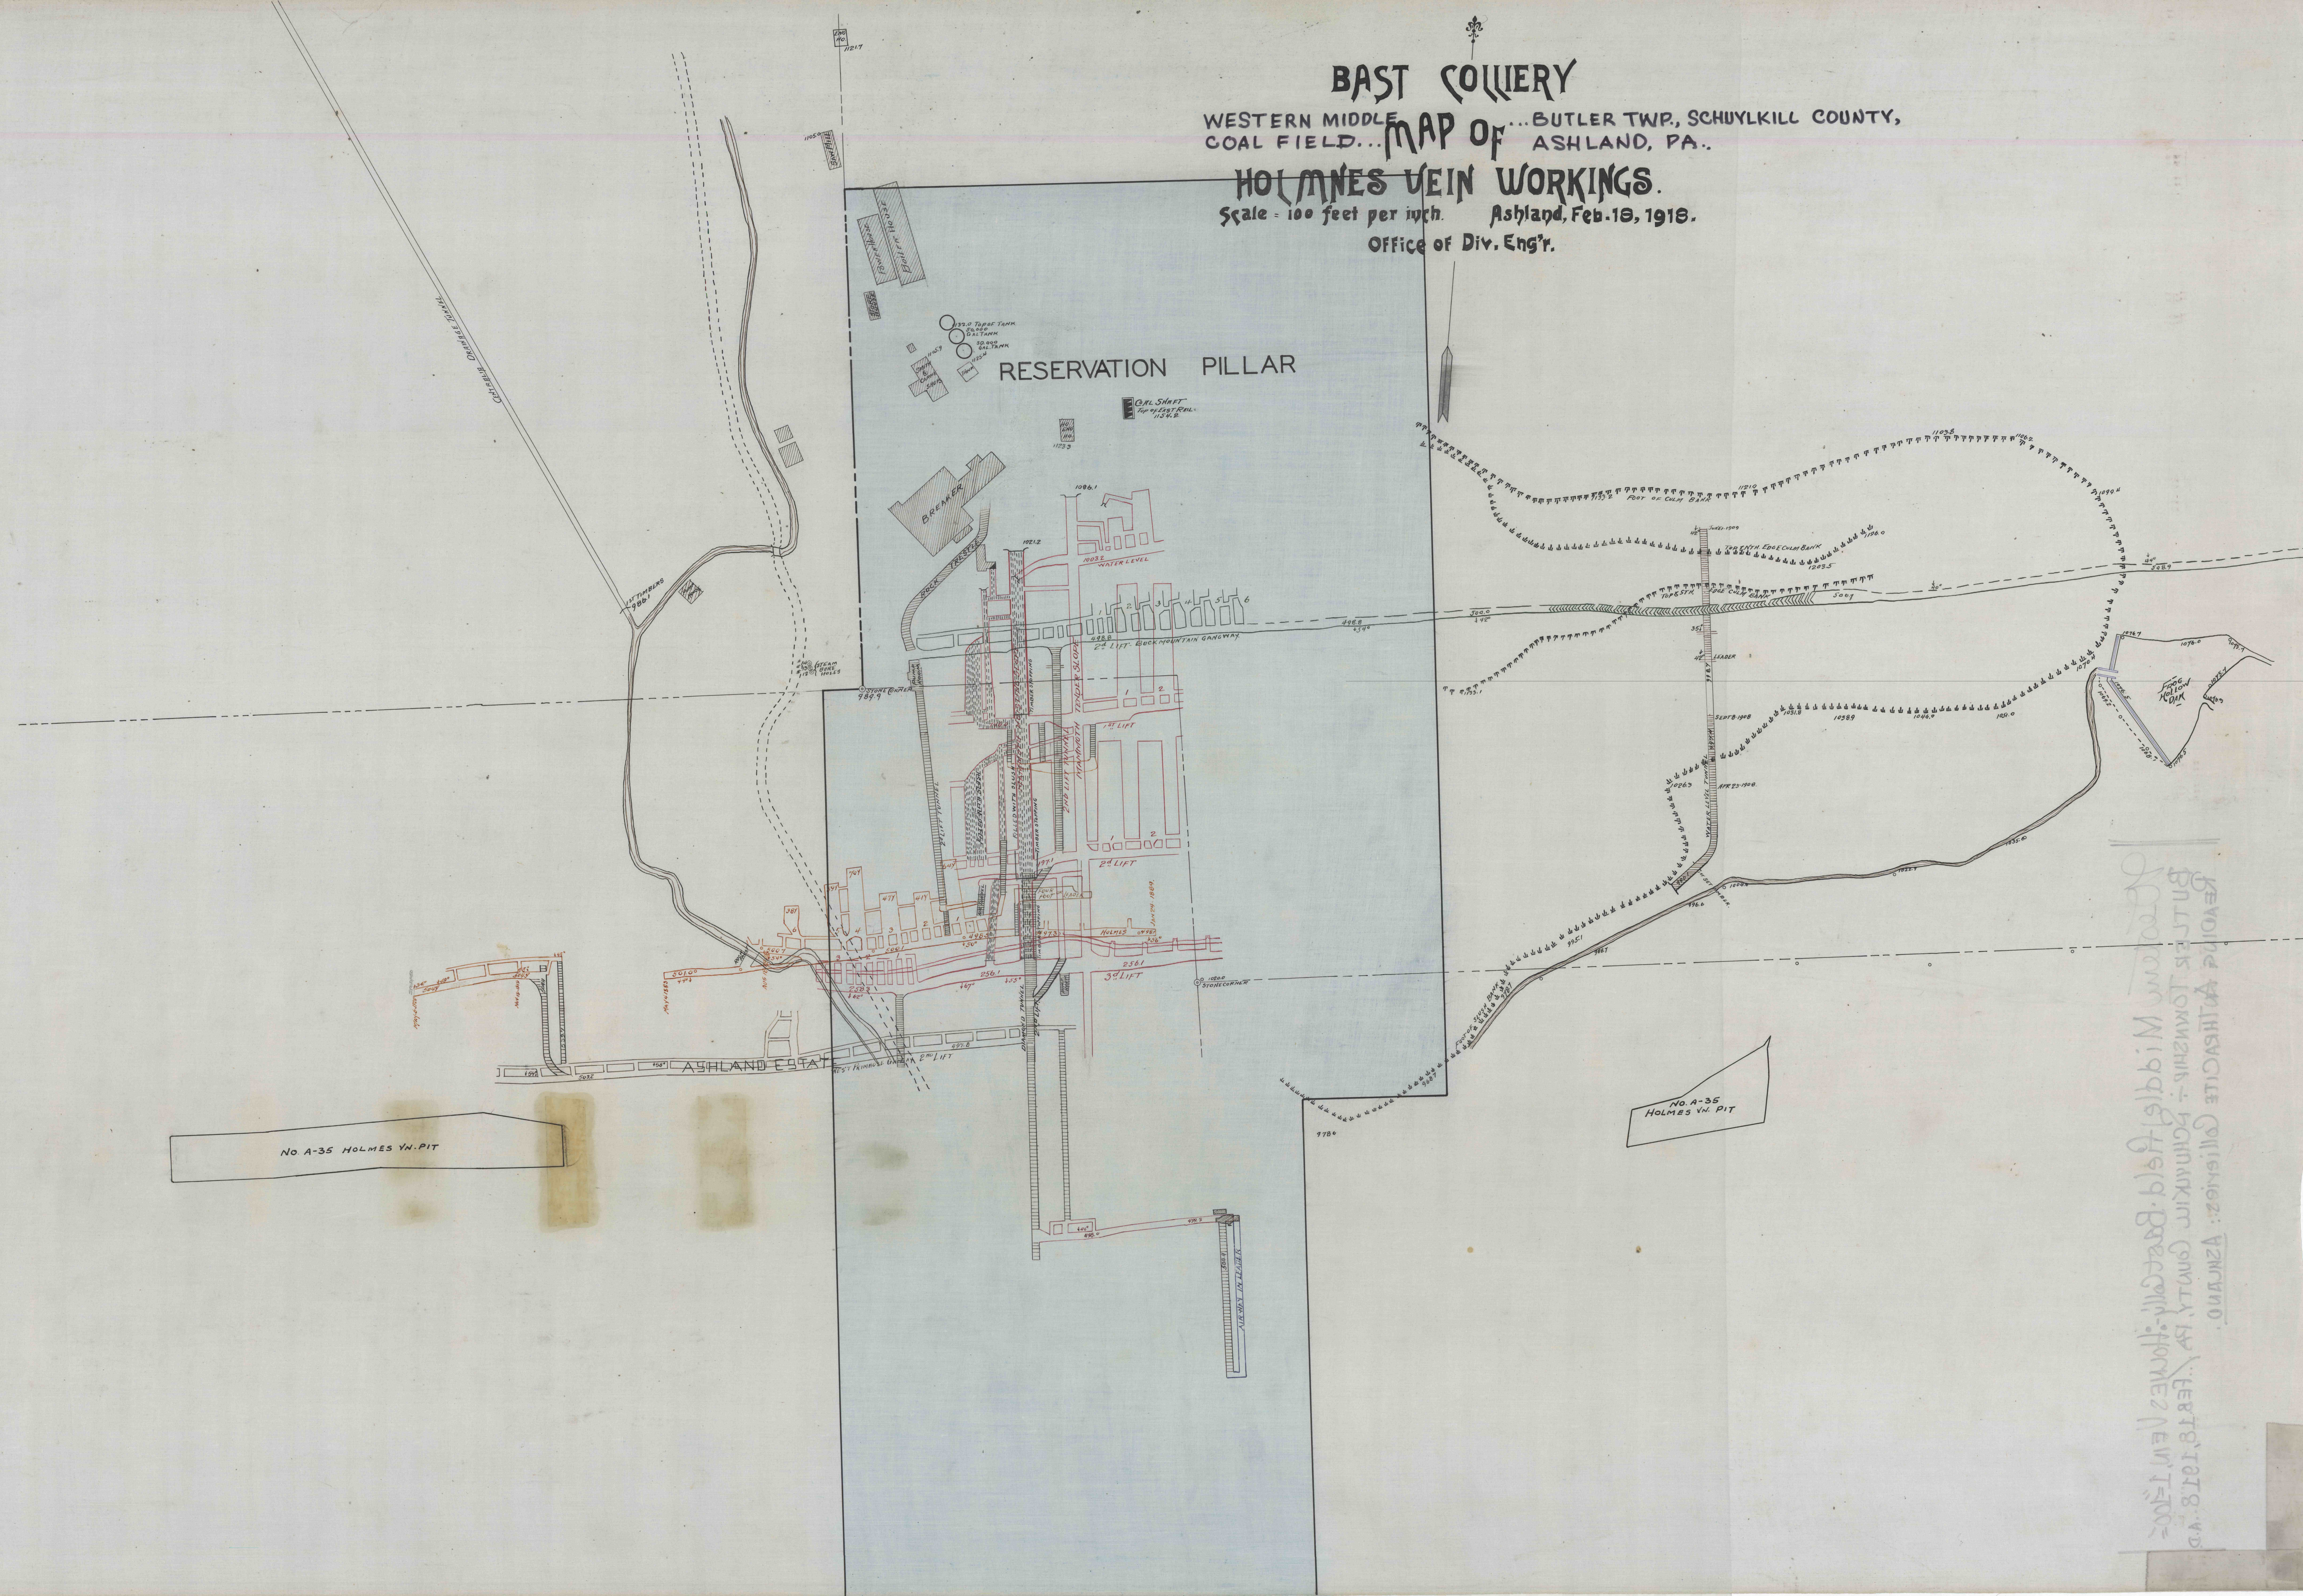




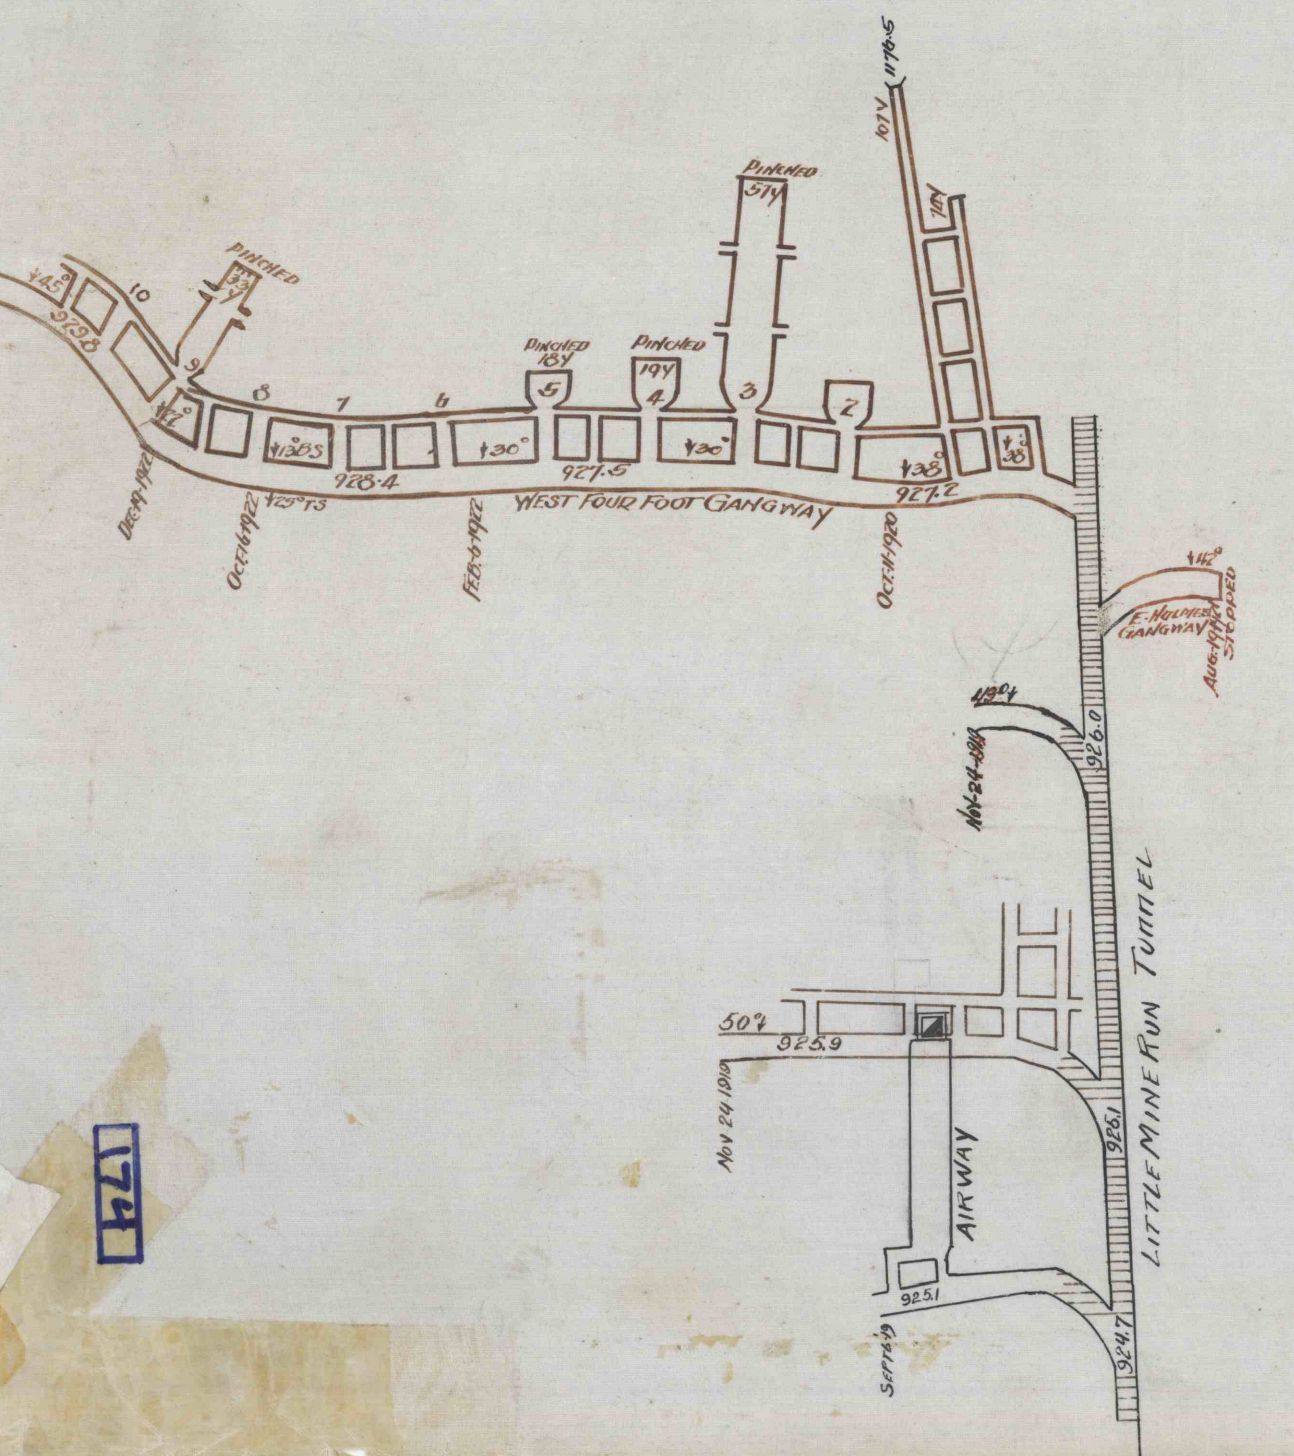

