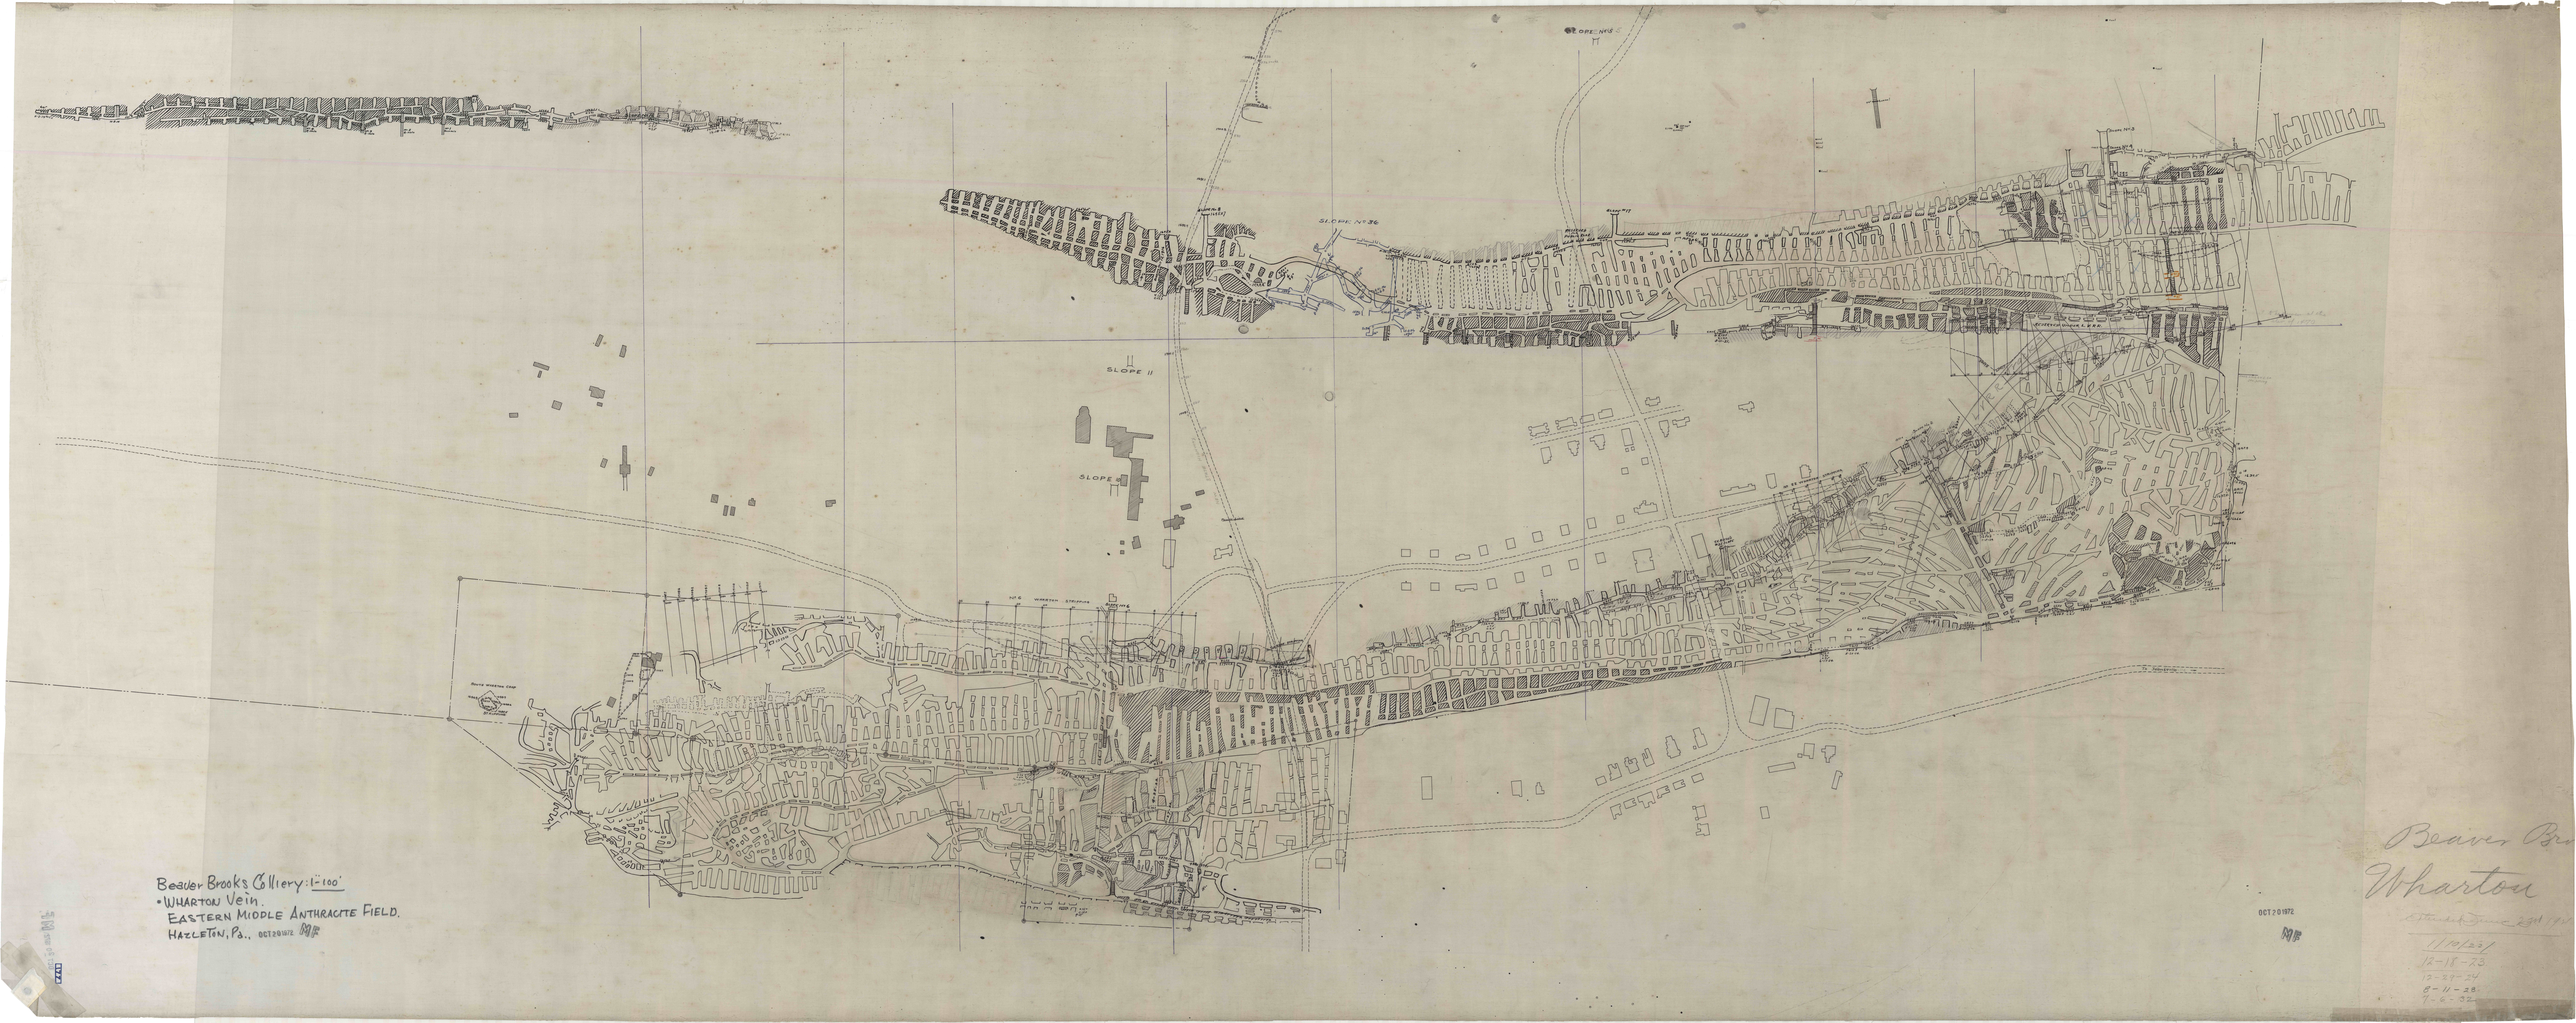
SLOPE Nº36
SLOPE 11
SLOPE 12
Beaver Brooks Colliery: 1"=100'
• WHARTON Vein.
EASTERN MIDDLE ANTHRACITE FIELD.
HAZLETON, PA., OCT 20 1972
OCT 20 1972
Beaver Br
Wharton
11/10/23
12-18-23
12-27-24
8-11-28
7-6-32