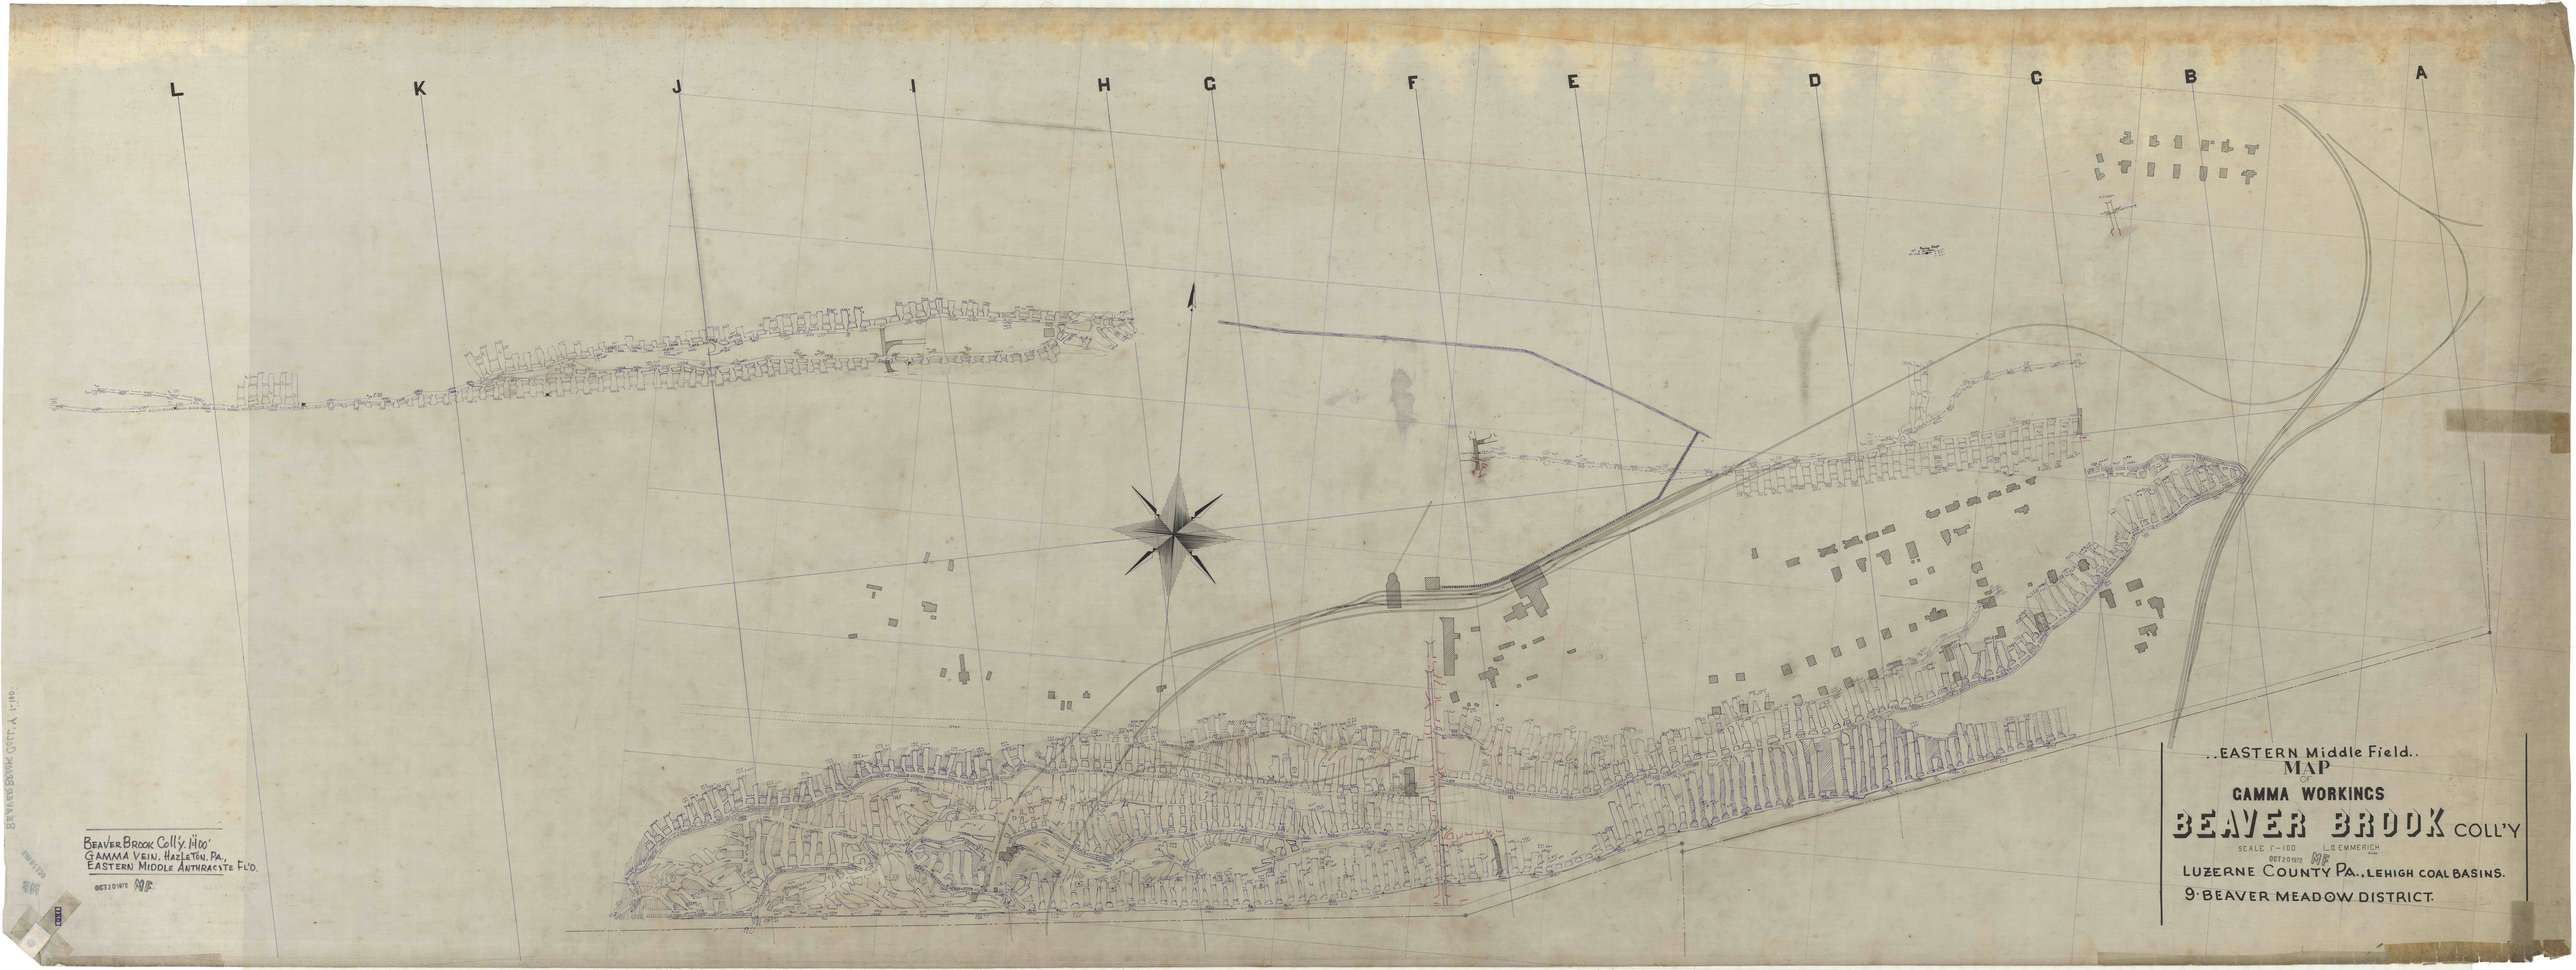
L
K
J
I
H
G
F
E
D
C
B
A
..EASTERN Middle Field..
MAP
OF
GAMMA WORKINGS
BEAVER BROOK COLL'Y
SCALE 1"=100'
L.G. EMMERICH
OCT 20 1972
LUZERNE COUNTY PA., LEHIGH COAL BASINS.
9 BEAVER MEADOW DISTRICT.
BEAVER BROOK COLL'Y. 1100'
GAMMA VEIN, HAZLETON, PA.,
EASTERN MIDDLE ANTHRACITE FLD.
OCT 20 1972
BEAVER BROOK COLL'Y. 1100'