


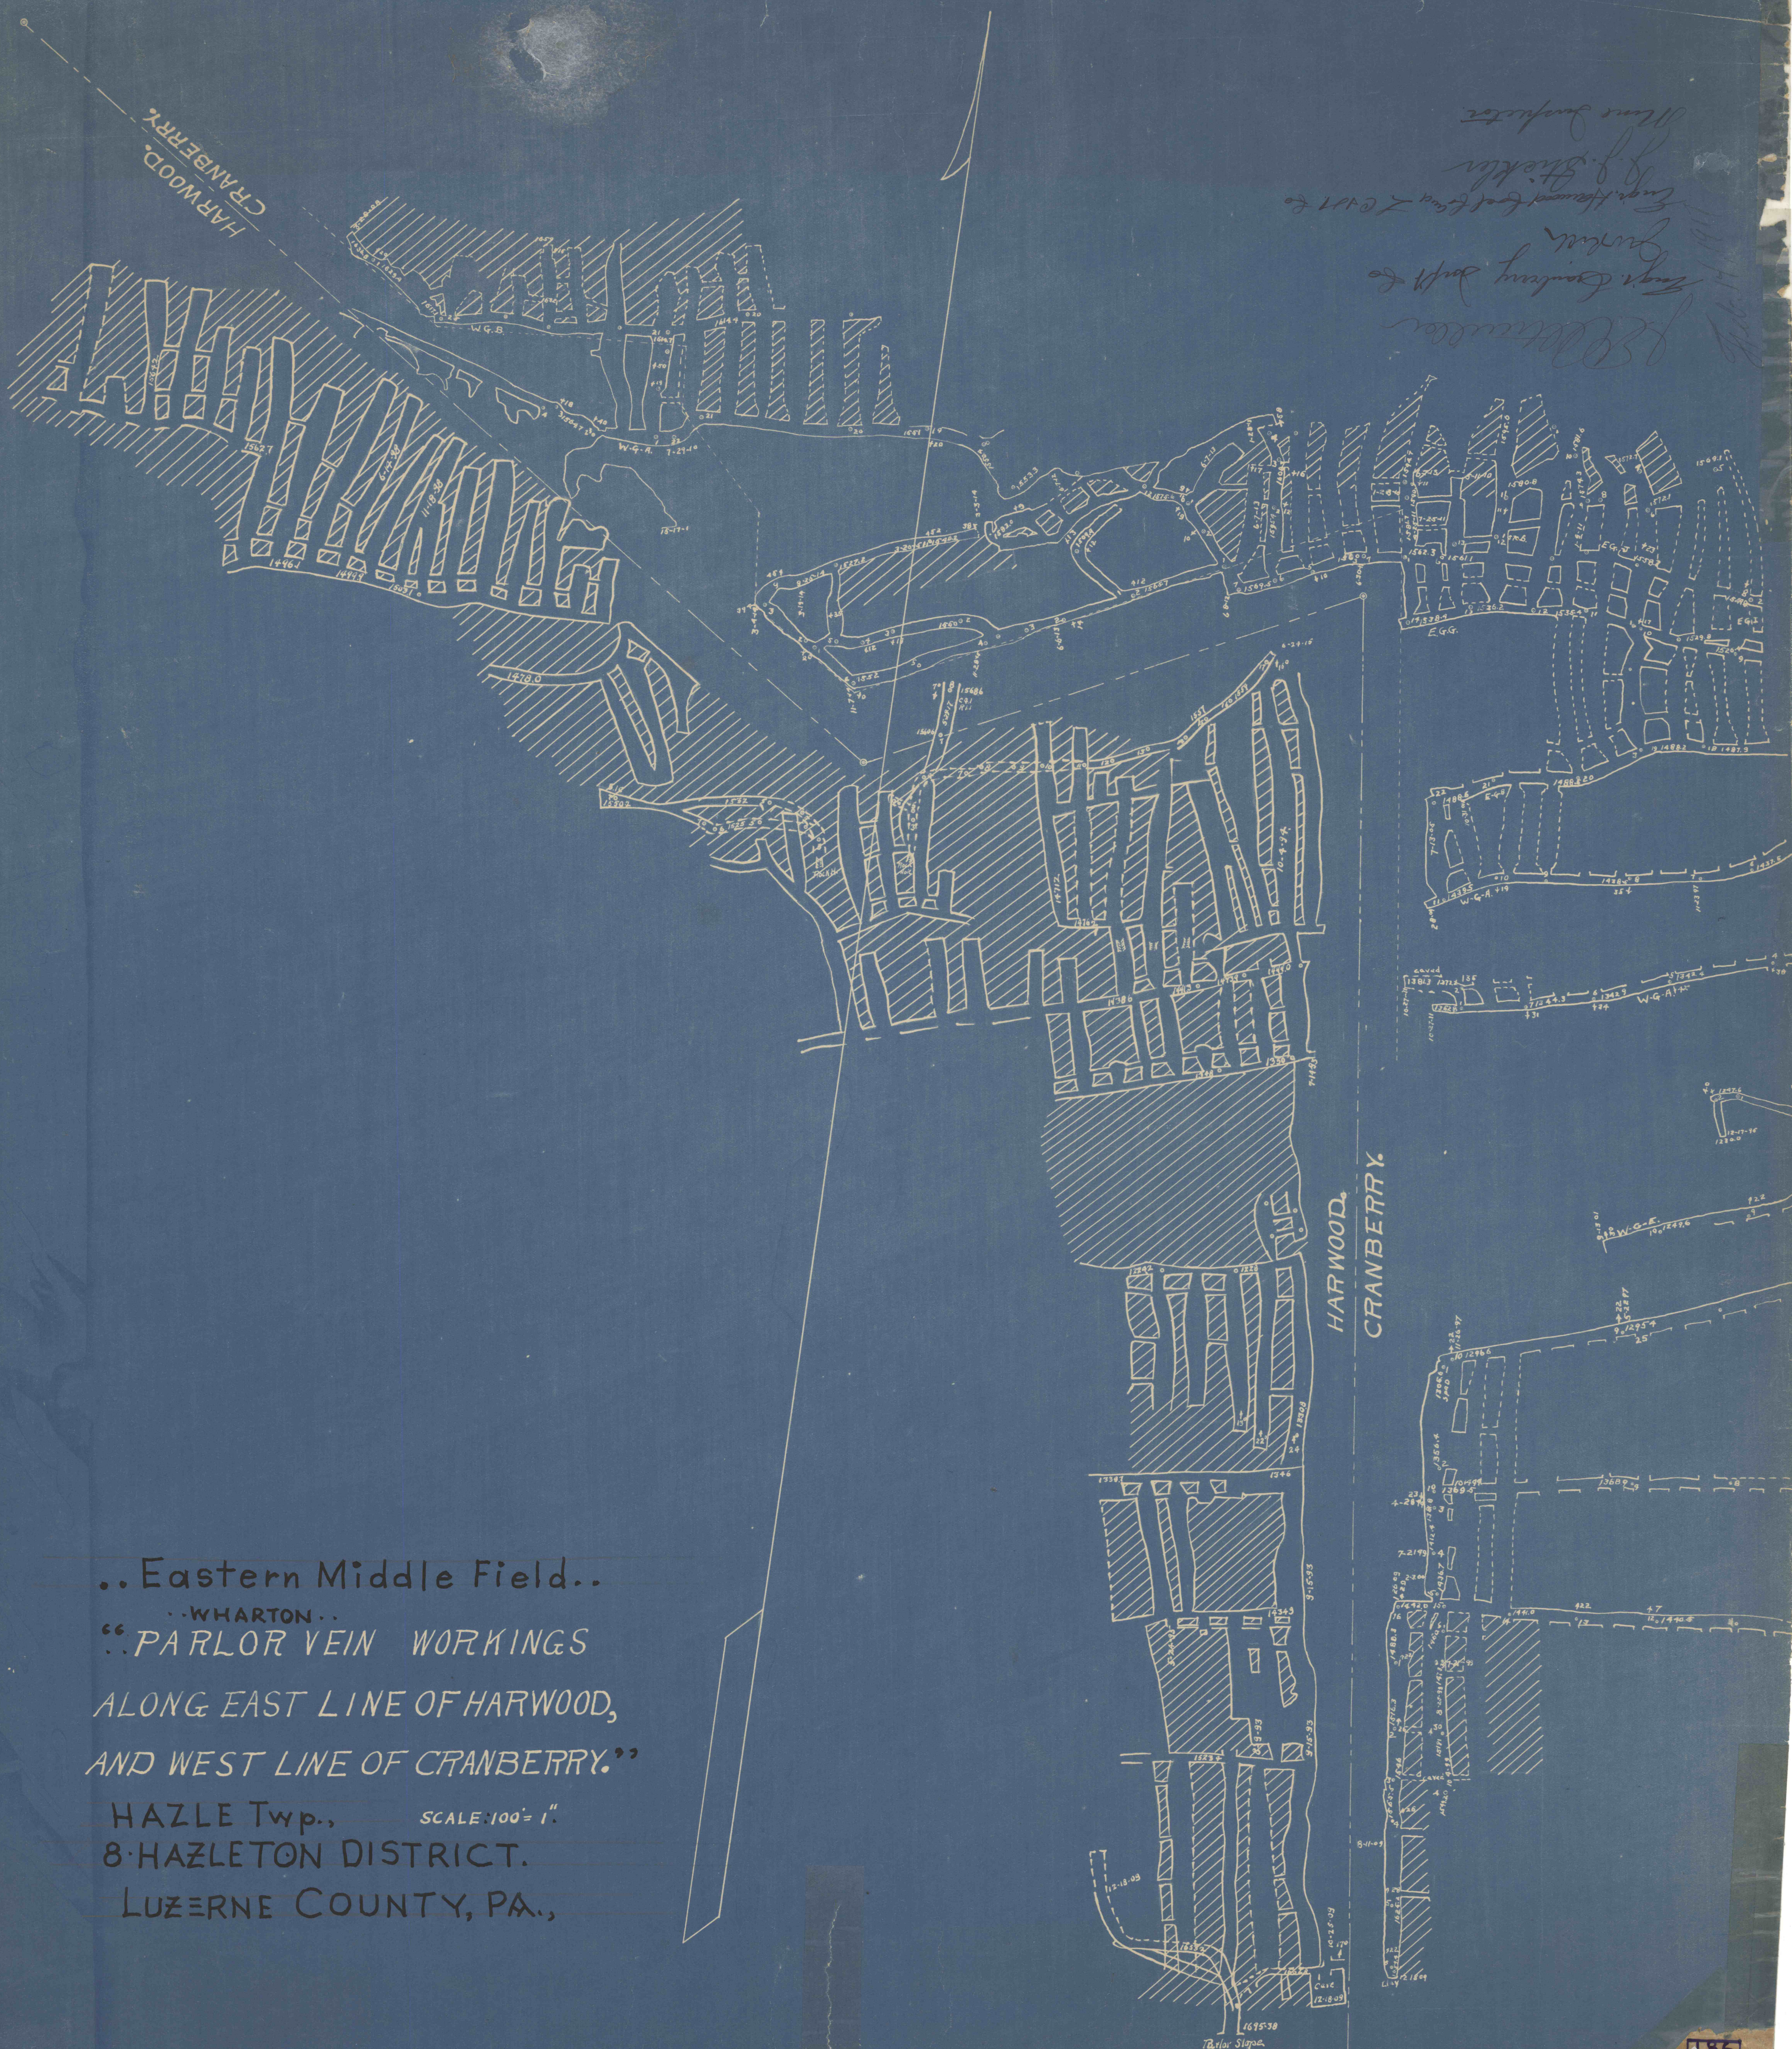

Wm. J. Stetson
J. J. Stetson
Eng. Howard Frost & Co. 7041 E
Survey
Eng. & Surveying Dept. &

.. Eastern Middle Field..
.. WHARTON..
"PARLOR VEIN WORKINGS
ALONG EAST LINE OF HARWOOD,
AND WEST LINE OF CRANBERRY."
HAZLE Twp., SCALE: 100' = 1"
8 HAZLETON DISTRICT.
LUZERNE COUNTY, PA.,