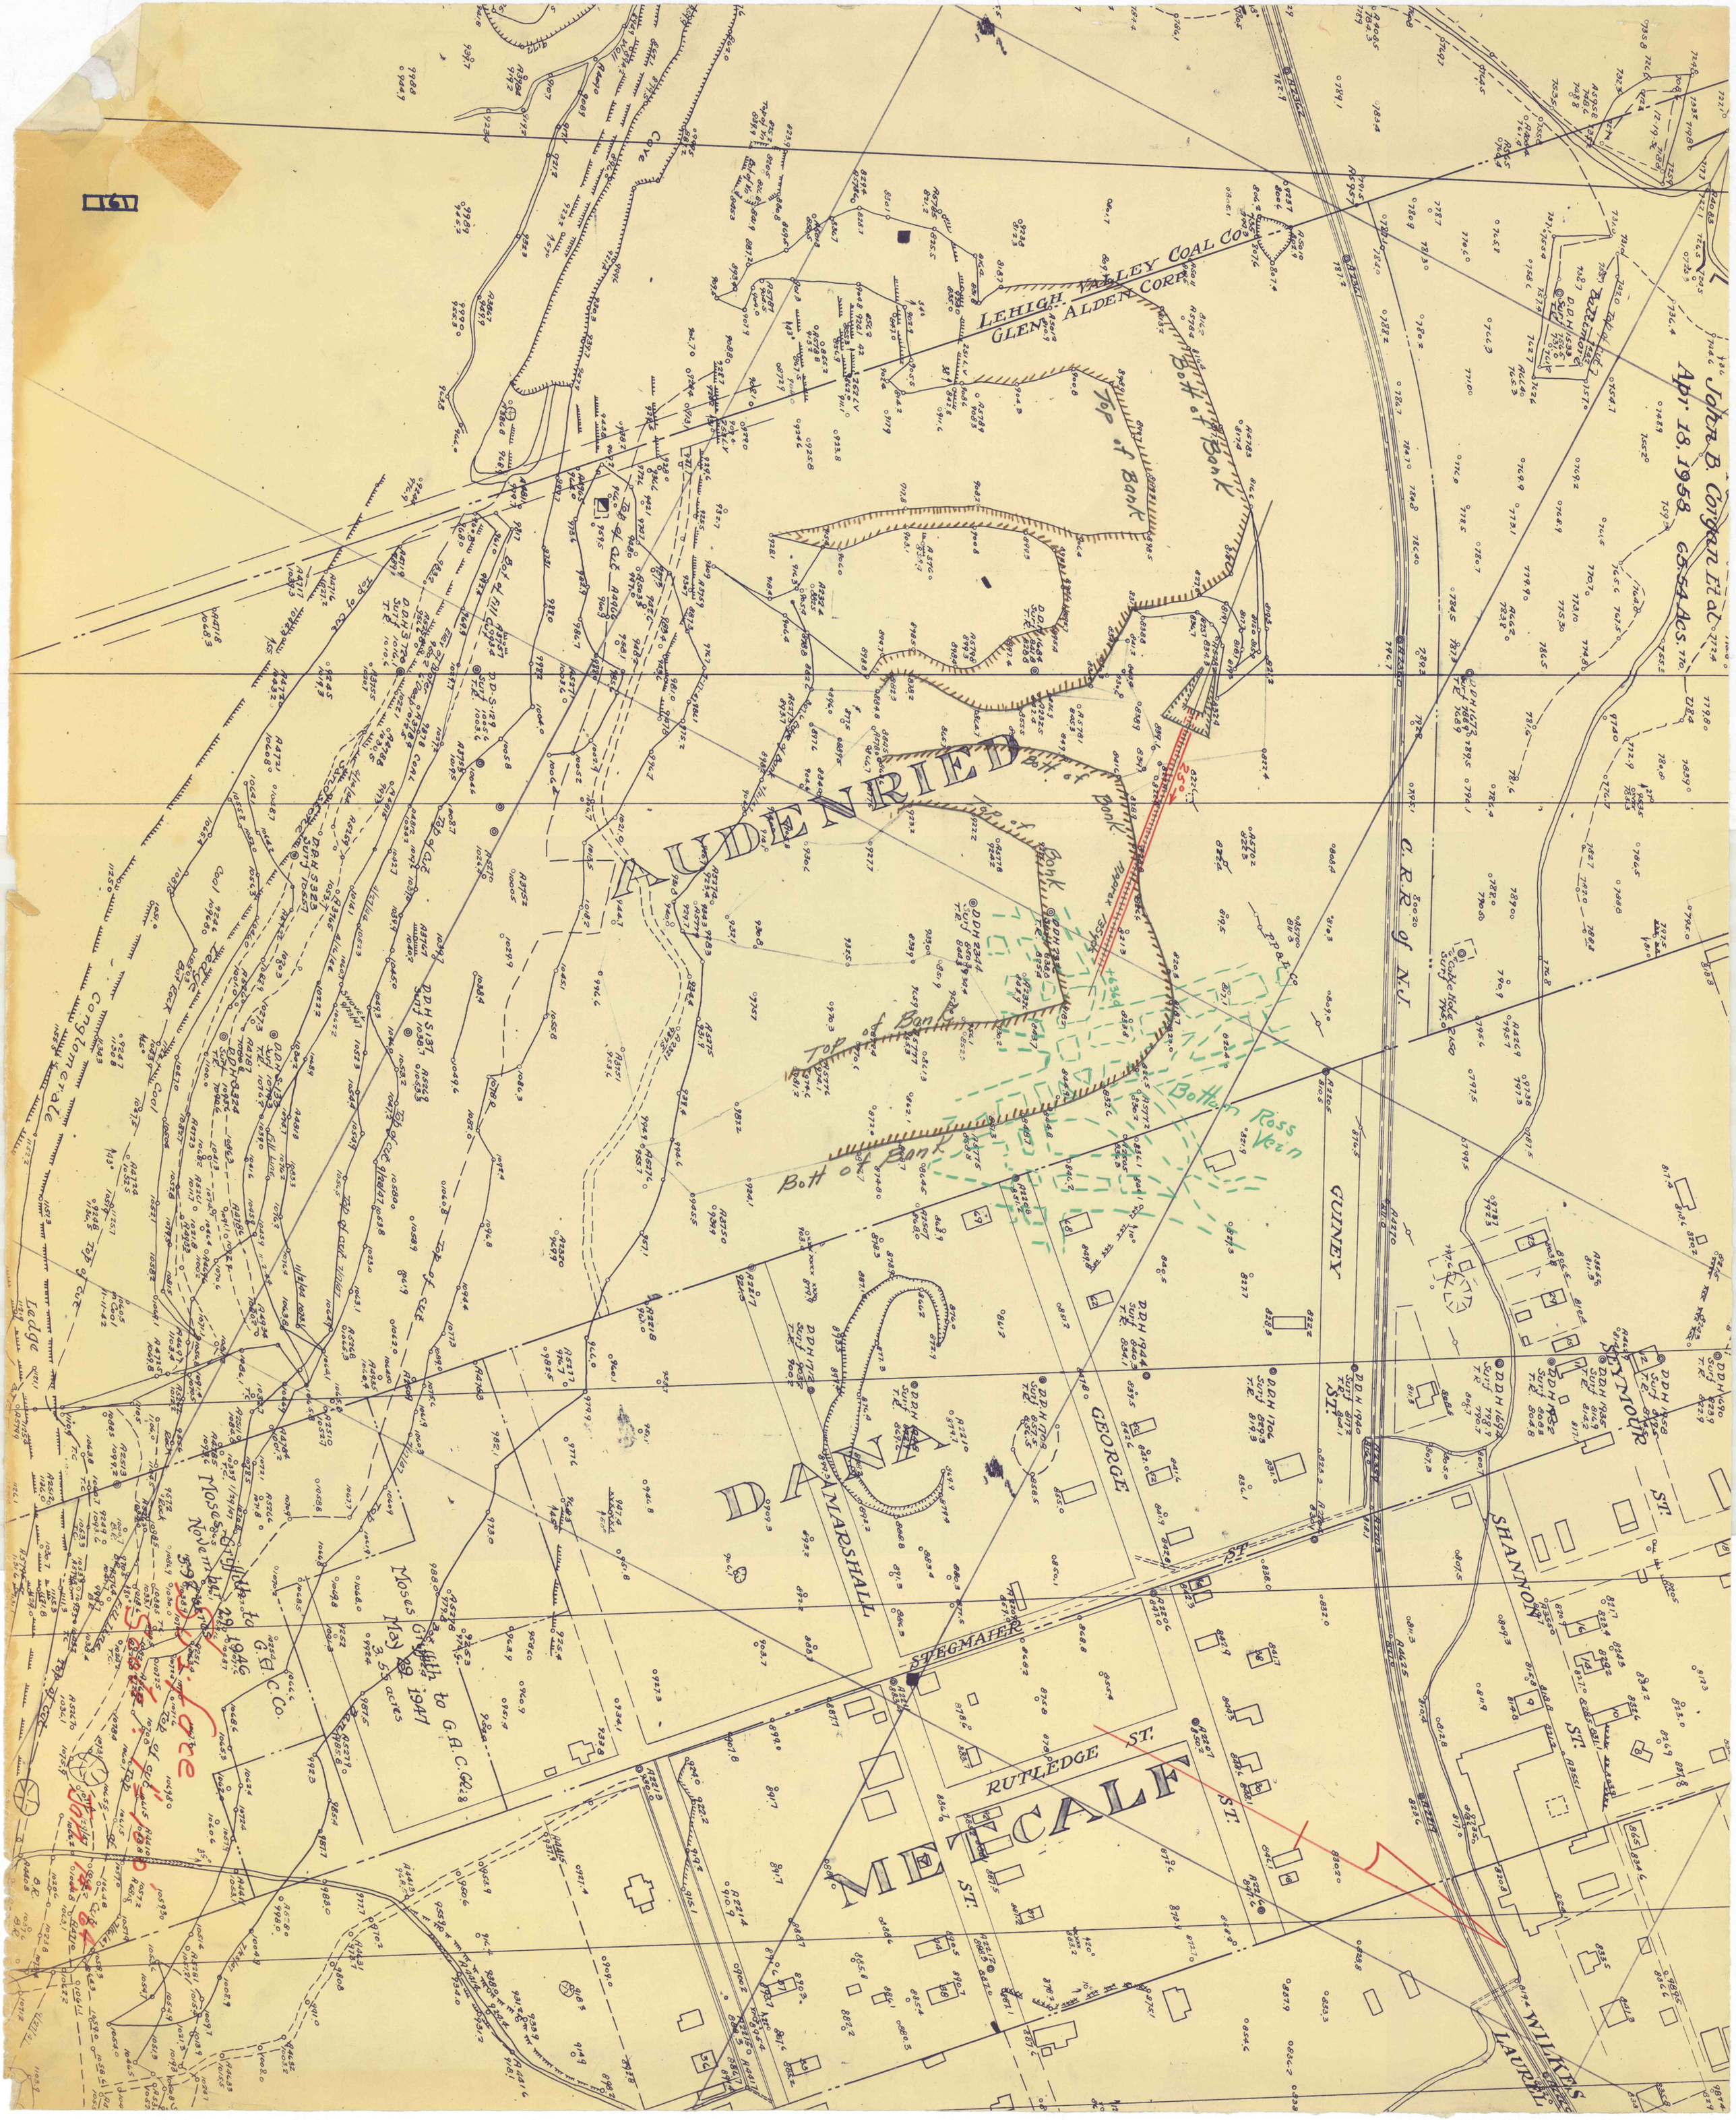
LEHIGH VALLEY COAL CO.
GLEN ALDEN CORP.
Top of Bank
Bott of Bank
Bottom Ross Vein
DAUDENRIED
DAMARSHALL
METCALF
STEGMAIER
RUTLEDGE ST.
GUINEY
GEORGE ST.
SHANNON ST.
SEYMOUR ST.
WILKES
LAUREL
C.R.R. of N.J.
Congtomerate
Ledge
Moses Griffith to G.A.C. Co.
May 29 1941
3.53 acres
Moses Griffith to G.A.C. Co.
Nov 11 1941
John B. Coyan et al
Apr. 18, 1958
65.54 Acs.
Approx 1350'
Scale Hole
Surf
T.R.
D.D.H.