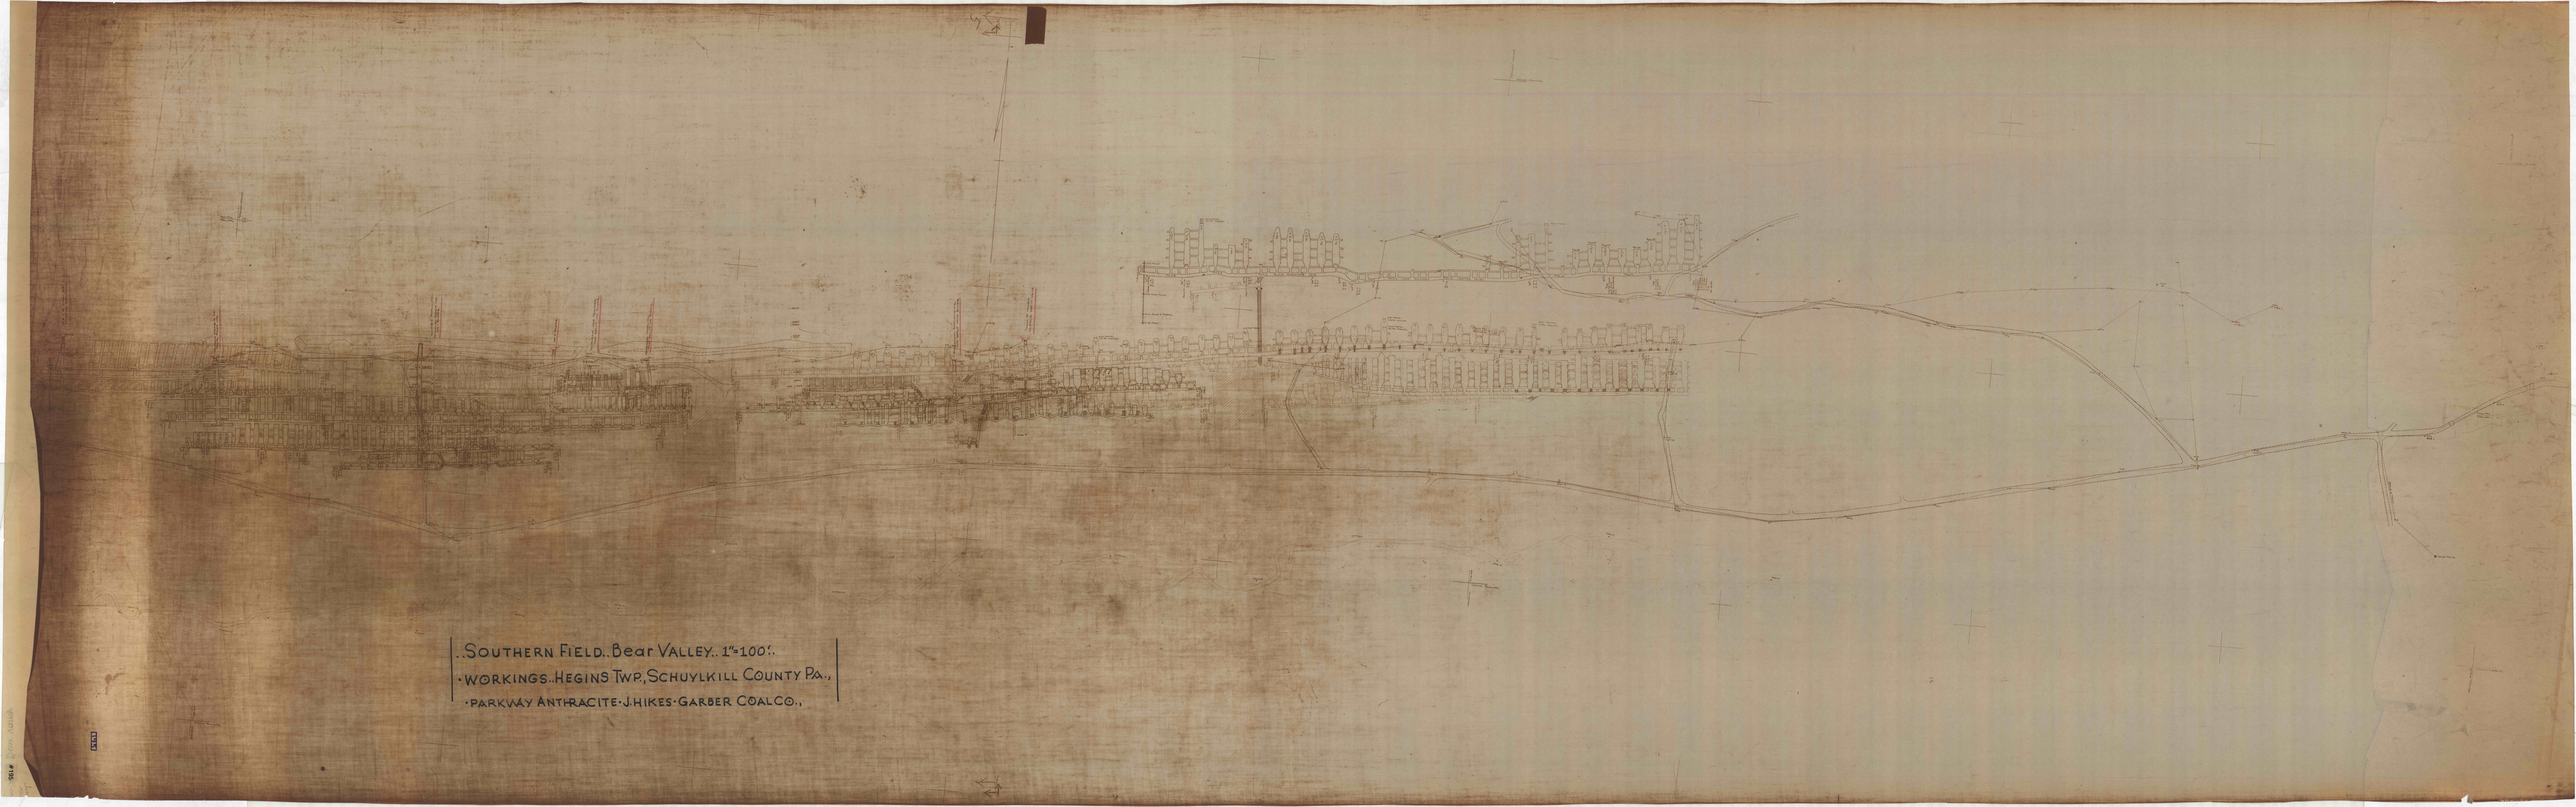
..SOUTHERN FIELD..Bear VALLEY..1"=100'.
·WORKINGS..HEGINS TWP., SCHUYLKILL COUNTY PA.,
·PARKWAY ANTHRACITE·J.HIKES·GARBER COAL CO.,