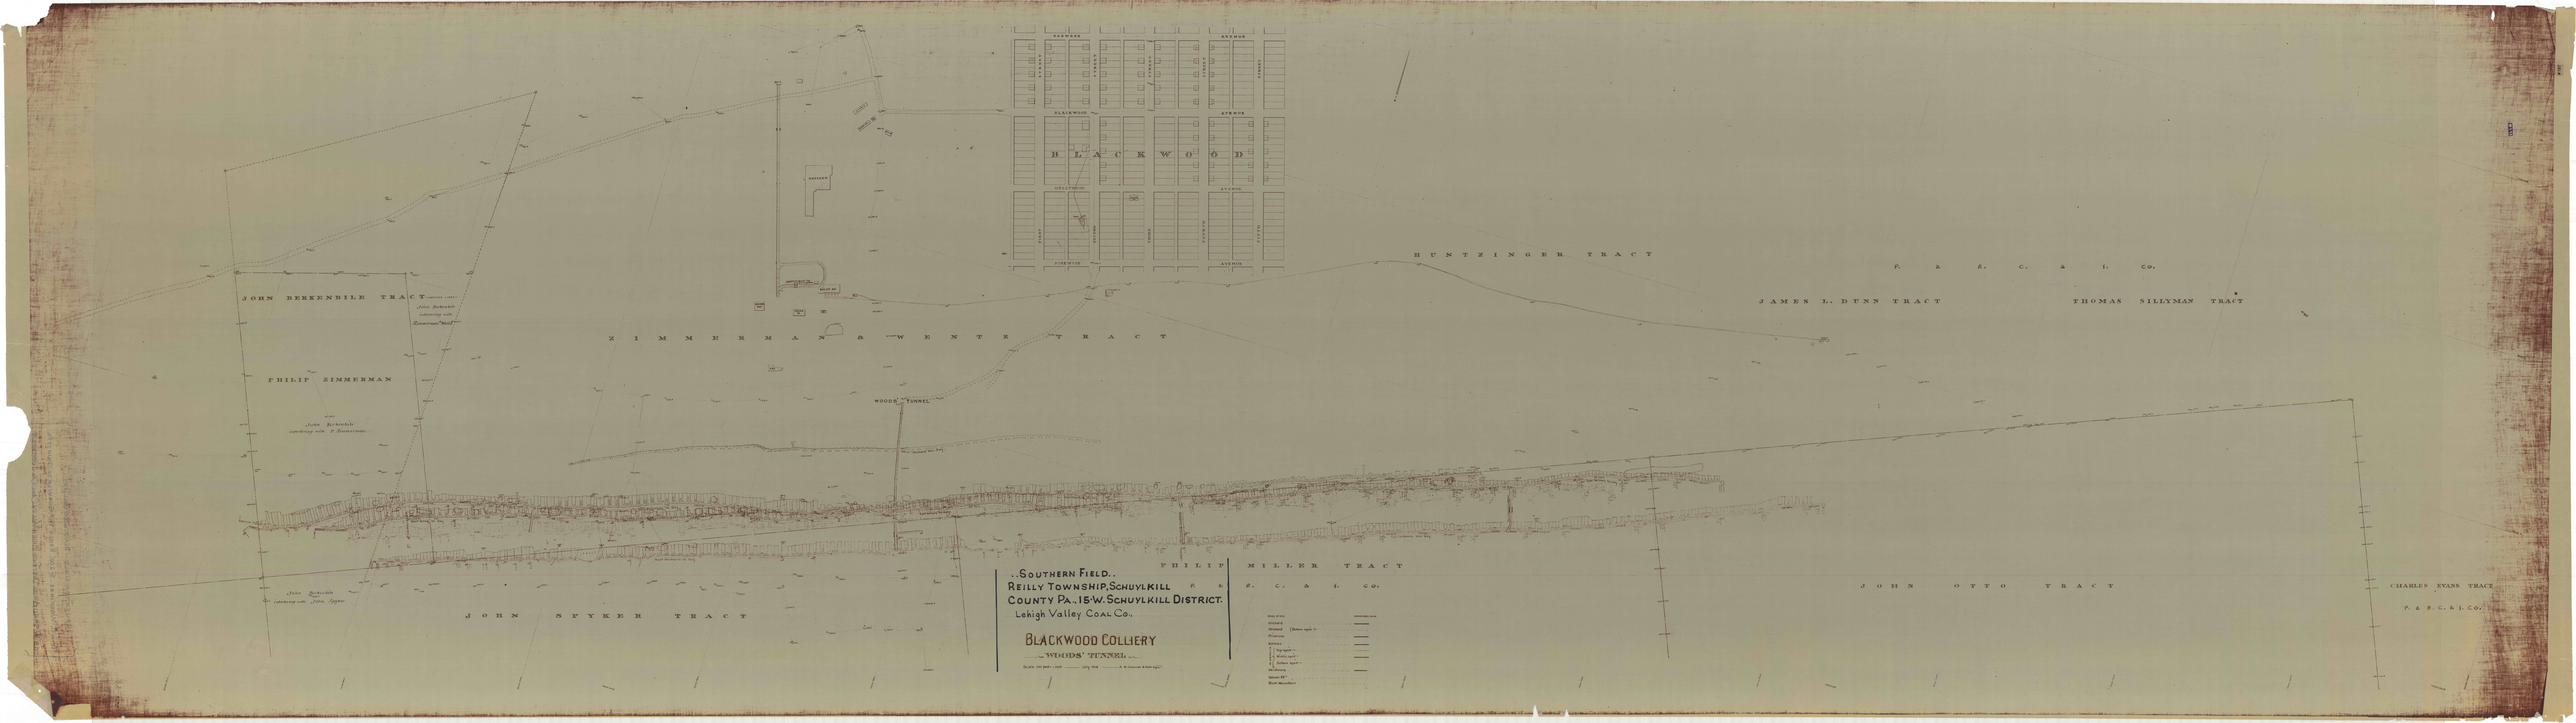

HAZLEWOOD AVENUE
BLACKWOOD
FLICKWOOD AVENUE
GREENWOOD AVENUE
PINEWOOD AVENUE
JOHN BERKENBILE TRACT
PHILIP ZIMMERMAN
ZIMMERMAN & WENTZ TRACT
HUNTZINGER TRACT
P. & R. C. & I. CO.
JAMES L. DUNN TRACT
THOMAS SILLYMAN TRACT
WOODS' TUNNEL
JOHN STYKER TRACT
PHILIP MILLER TRACT
P. C. & I. CO.
JOHN OTTO TRACT
CHARLES EVANS TRACT
P. & R. C. & I. CO.
..SOUTHERN FIELD..
REILLY TOWNSHIP, SCHUYLKILL
COUNTY PA. 15 W. SCHUYLKILL DISTRICT.
Lehigh Valley Coal Co.
BLACKWOOD COLLIERY
WOODS' TUNNEL