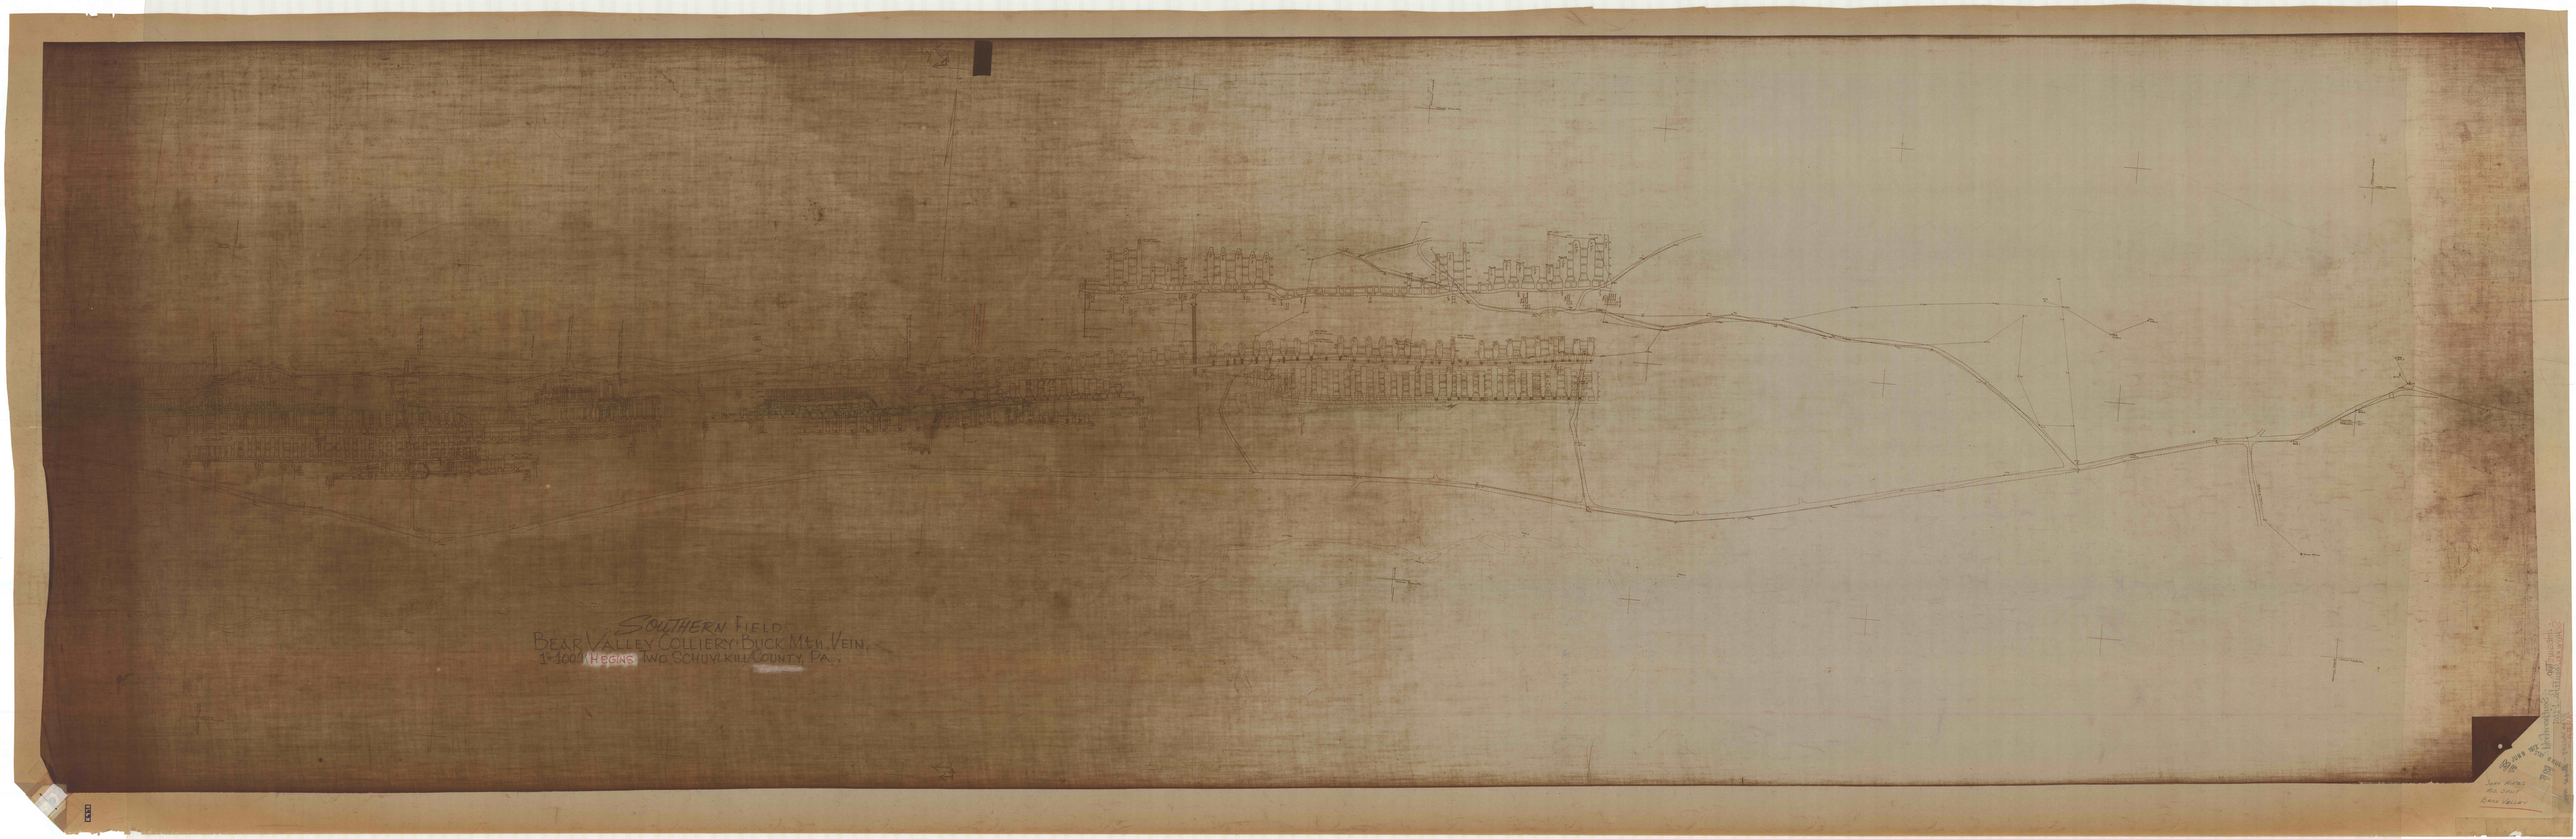
SOUTHERN FIELD.
BEAR VALLEY COLLIERY BUCK MTN. VEIN.
1"=100'
HIGGINS
Twp. SCHUYLKILL COUNTY, PA.