


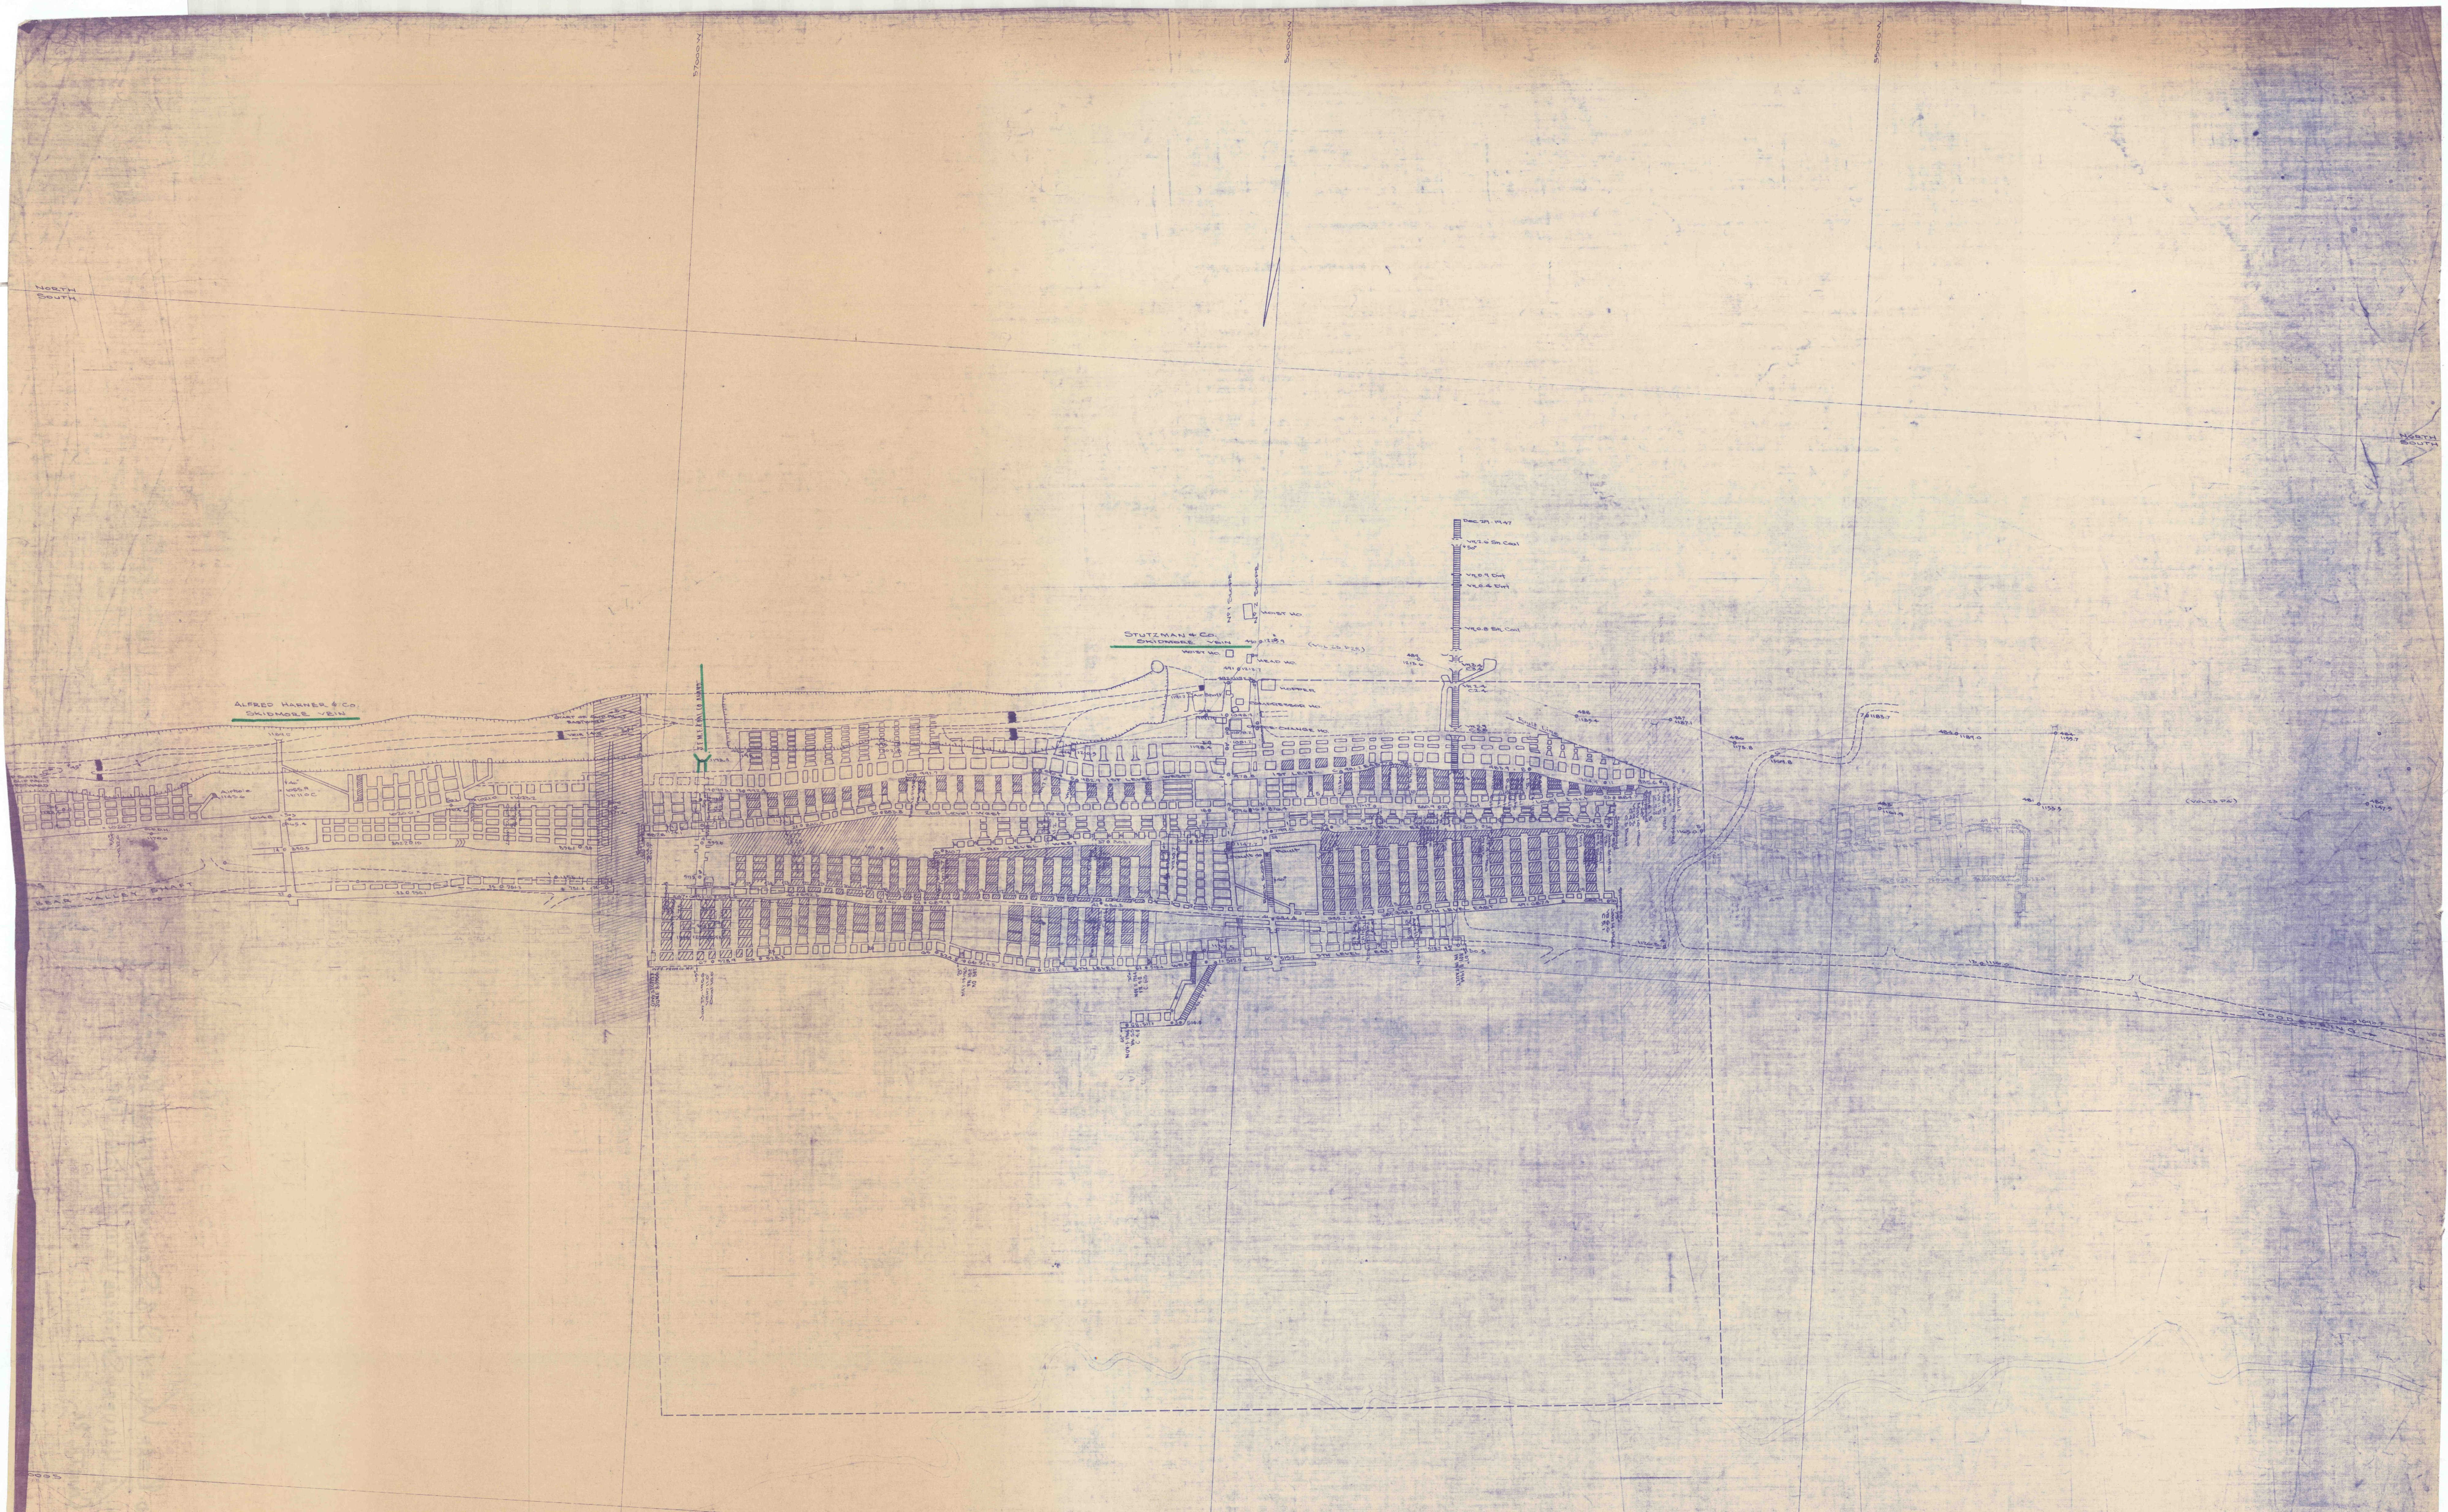

SOUTHERN FIELD: BEAR VALLEY. S. & S. COAL CO. SKIDMORE Slope 1:100. STUTZMAN & CO. SKIDMORE V. N. / ALFRED HARNER SKIDMORE V. N.