


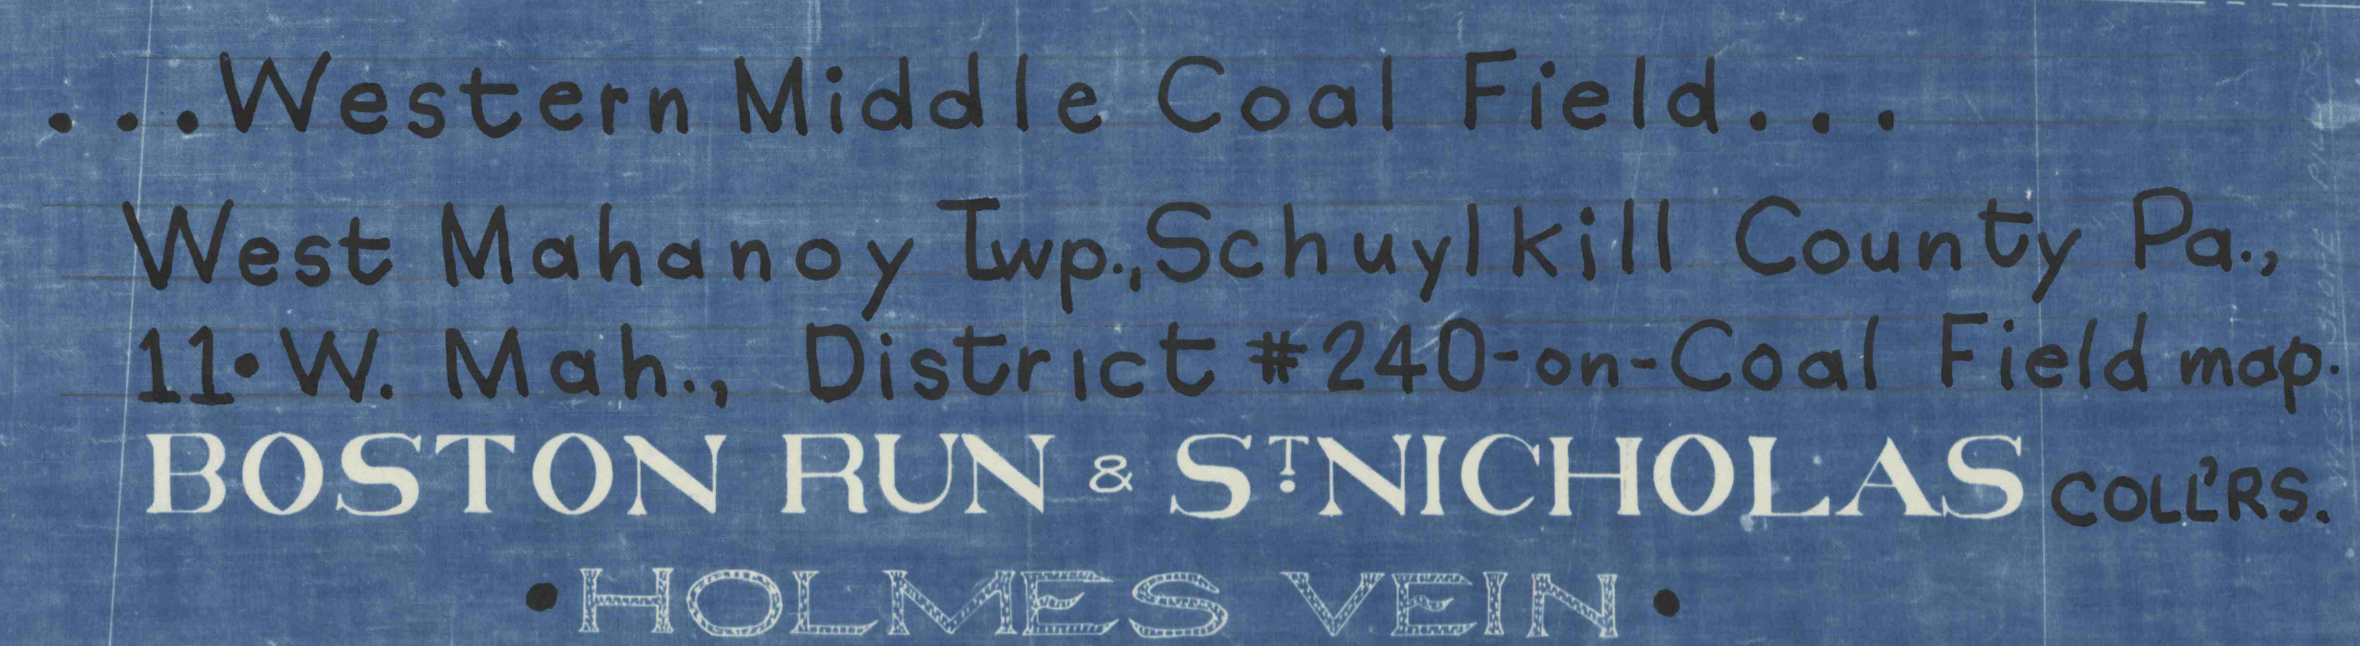

BOSTON RUN & ST NICHOLAS COLL'RS.

HOLMES VEIN