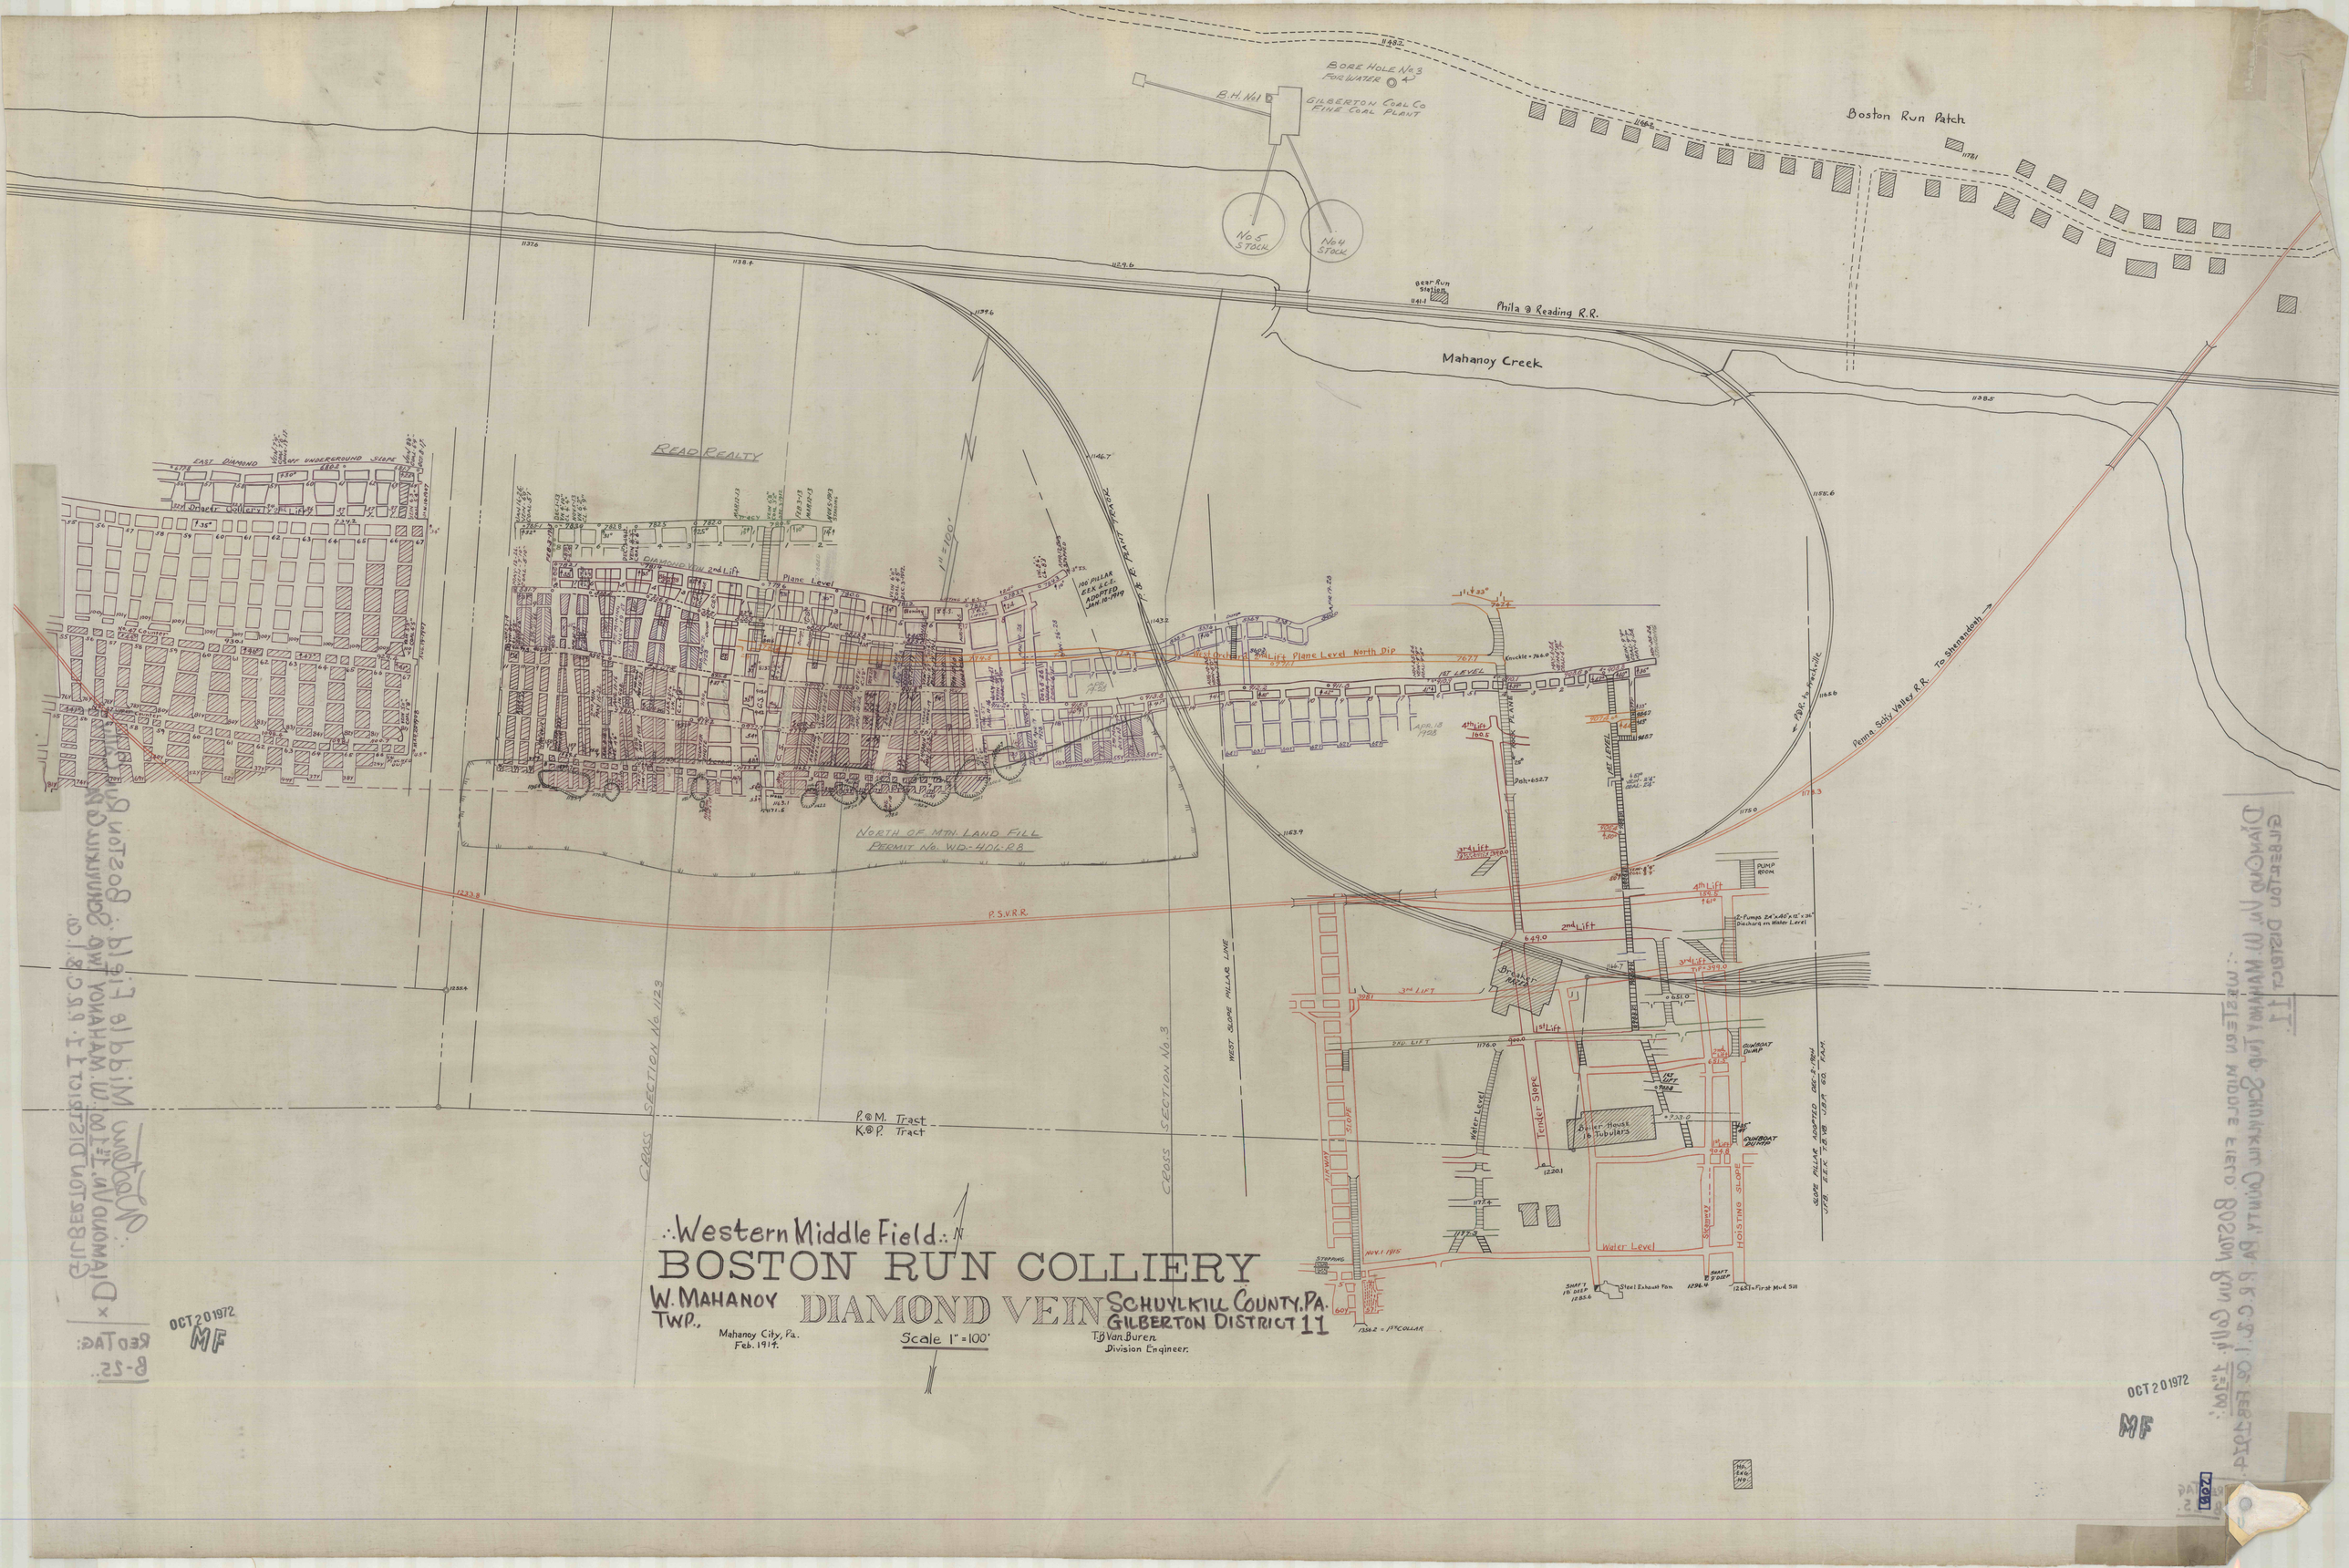
Western Middle Field
BOSTON RUN COLLIERY
DIAMOND VEIN
W. MAHANOY TWP.
Mahanoy City, Pa.
Feb. 1914.
Scale 1" = 100'
T. B. Van Buren
Division Engineer.
SCHUYLKILL COUNTY, PA.
GILBERTON DISTRICT 11
Boston Run Patch
Bore Hole No. 3 For Water
B.H. No. 1
Gilberton Coal Co Fine Coal Plant
No. 5 Stock
No. 4 Stock
Boston Run Station
Phila & Reading R.R.
Mahanoy Creek
Penna Schy Valley R.R.
To Shenandoah
P.R.R. to Pottsville
P.S.V.R.R.
Read Realty
North of Mtn. Land Fill
Permit No. WD-406-R8
Cross Section No. 1123
Cross Section No. 3
West Slope Pillar Line
P. & M. Tract
K. & P. Tract
East Diamond
Off Underground Slope
Drager Colliery
Diamond Vein 2nd Lift
Plane Level
100' Pillar
E.E.K. & C.E.
Adopted
Jan. 18, 1919
Plane Level North Dip
1st Level
2nd Lift
3rd Lift
4th Lift
Pump Room
Tender Slope
Boiler House & Tubulars
Gunboat Dump
Water Level
Hoisting Slope
Stepping
Steel Exhaust Fan
Shaft 12 deep
Shaft 2 deep
1286.2 = 1st Collar
1268.7 = First Mud Sill
Slope Pillar Adopted Dec. 2, 1914
J.B.E.C. & E.E.K. & C.E.
Plan
Gilberton District 11
Diamond Vein
Boston Run Colliery
Western Middle Field
Mahanoy City, Pa.
Scale 1" = 100'
Division Engineer
Schuylkill County, Pa.
Mahanoy Twp.
Middle Field
Boston Run Colliery
Diamond Vein
Gilberton District 11
Schuylkill Co. Pa.
Reg. Tag:
B-25
OCT 20 1972
MF