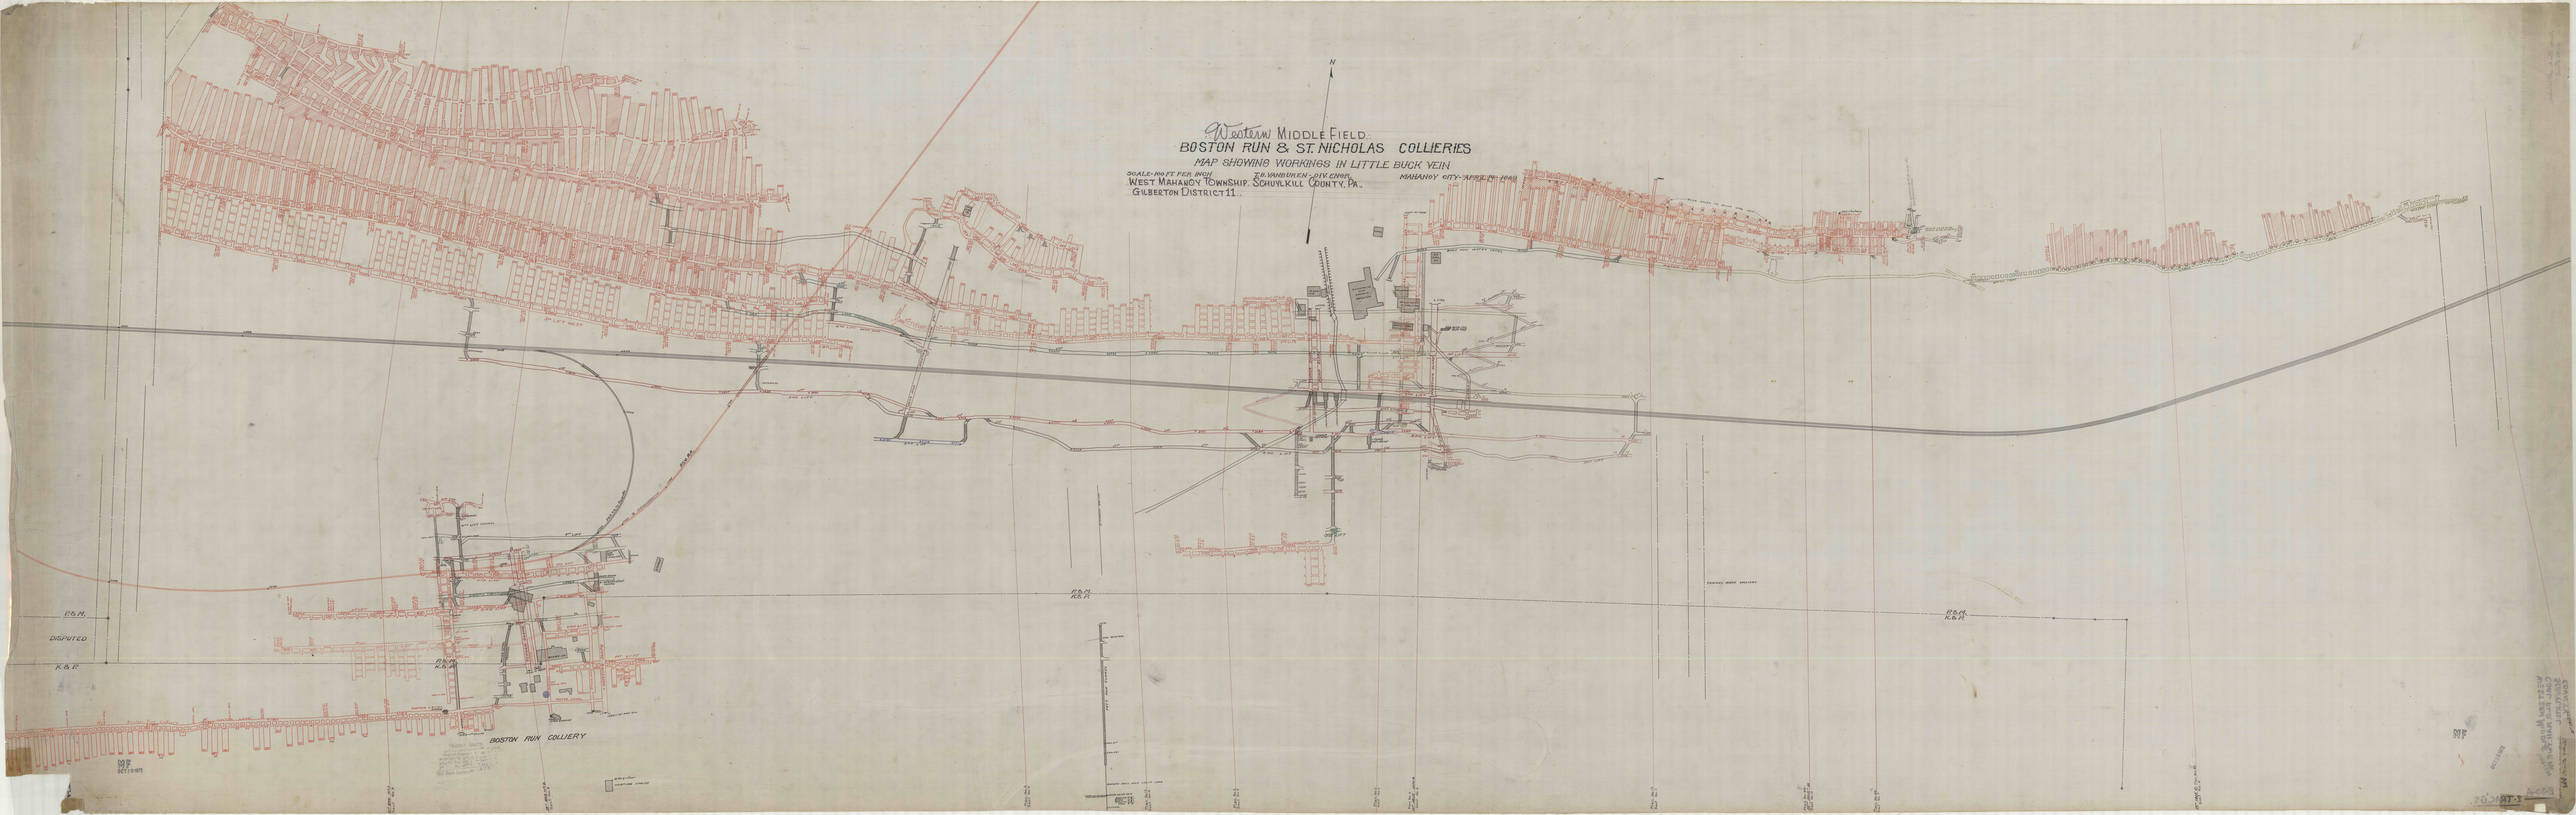
Western Middle Field
BOSTON RUN & ST. NICHOLAS COLLIERIES
MAP SHOWING WORKINGS IN LITTLE BUCK VEIN
SCALE-100 FT. PER INCH
WEST MAHANOY TOWNSHIP. SCHUYLKILL COUNTY. PA.
GILBERTON DISTRICT 11
F.B. VANBUREN - DIV. ENGR.
MAHANOY CITY - APRIL 7th 1920
N
R.B.M.
DISPUTED
K.B.P.
R.B.M.
K.B.P.
R.B.M.
K.B.P.
R.B.M.
K.B.P.
BOSTON RUN COLLIERY