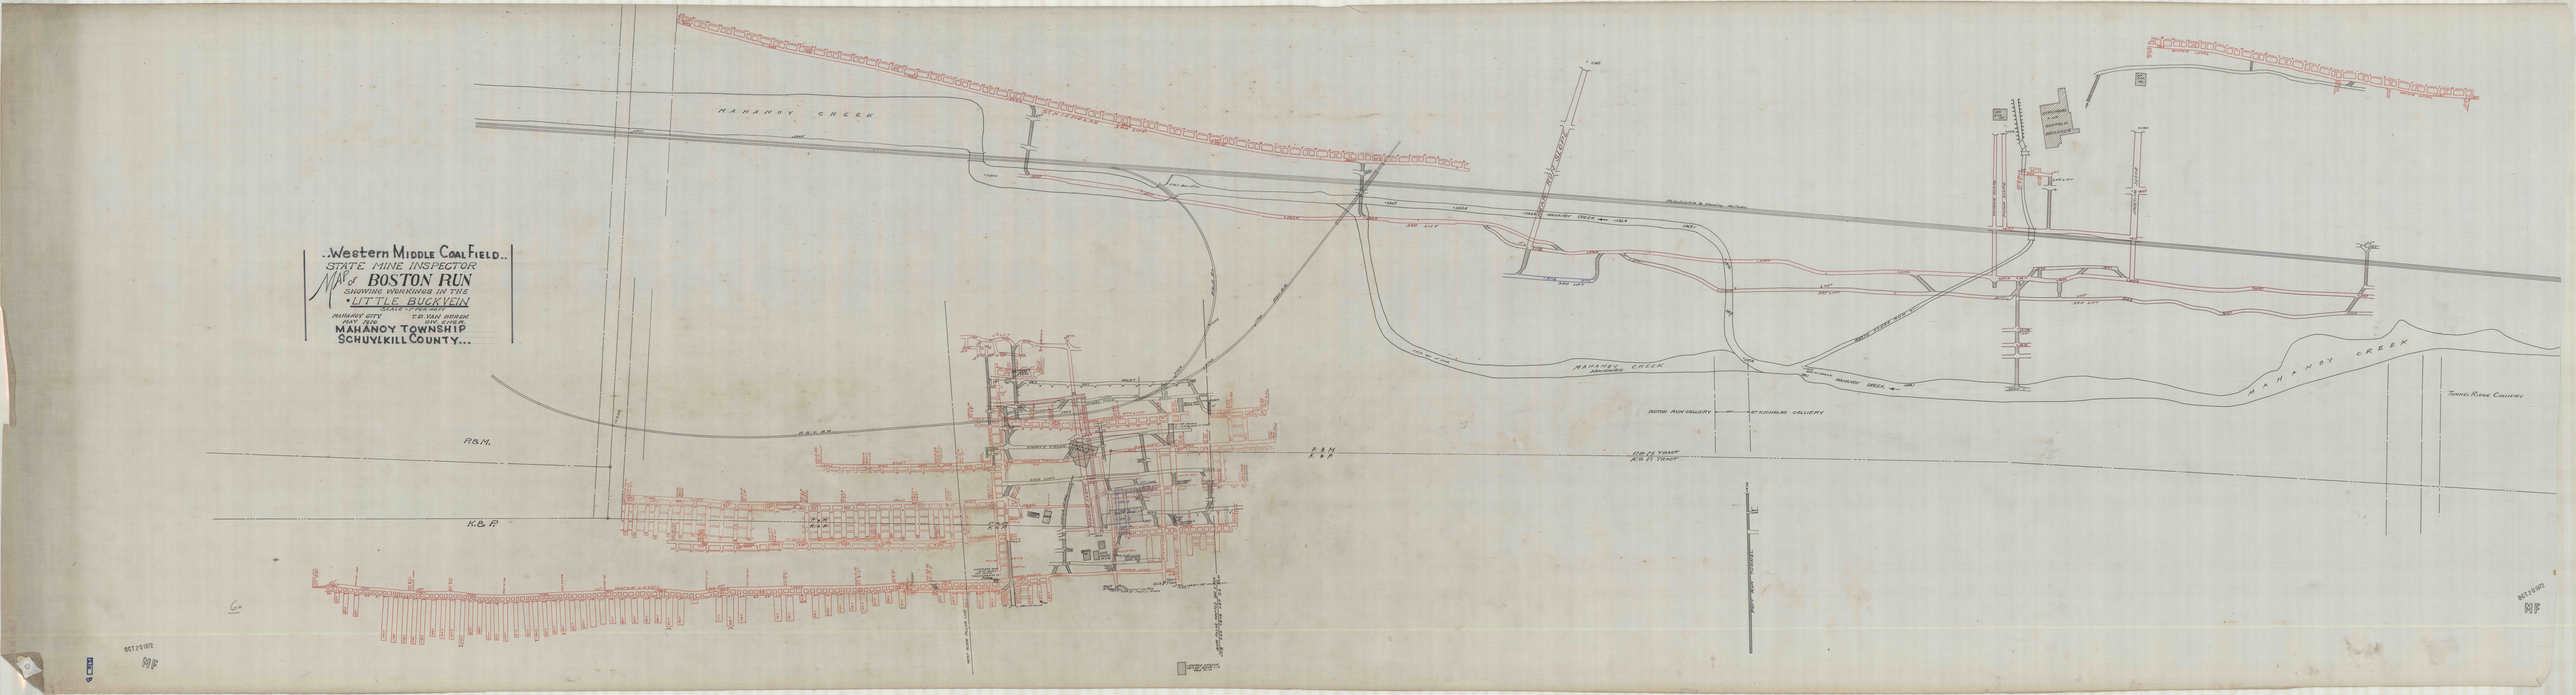

..Western Middle Coal Field..
STATE MINE INSPECTOR
Map of BOSTON RUN
SHOWING WORKINGS IN THE
LITTLE BUCKVEIN
SCALE 1 INCH = 200 FEET
MAHANOY CITY T.B. VAN BUREN
MAY 1906 SURVEYED
MAHANOY TOWNSHIP
SCHUYLKILL COUNTY...
MAHANOY CREEK
R & M.
K. & P.
BOSTON RUN COLLIERY
ST NICHOLAS COLLIERY
TUNNEL RIDGE COLLIERY
Philadelphia & Reading Railway
OCT 29 1912
RF