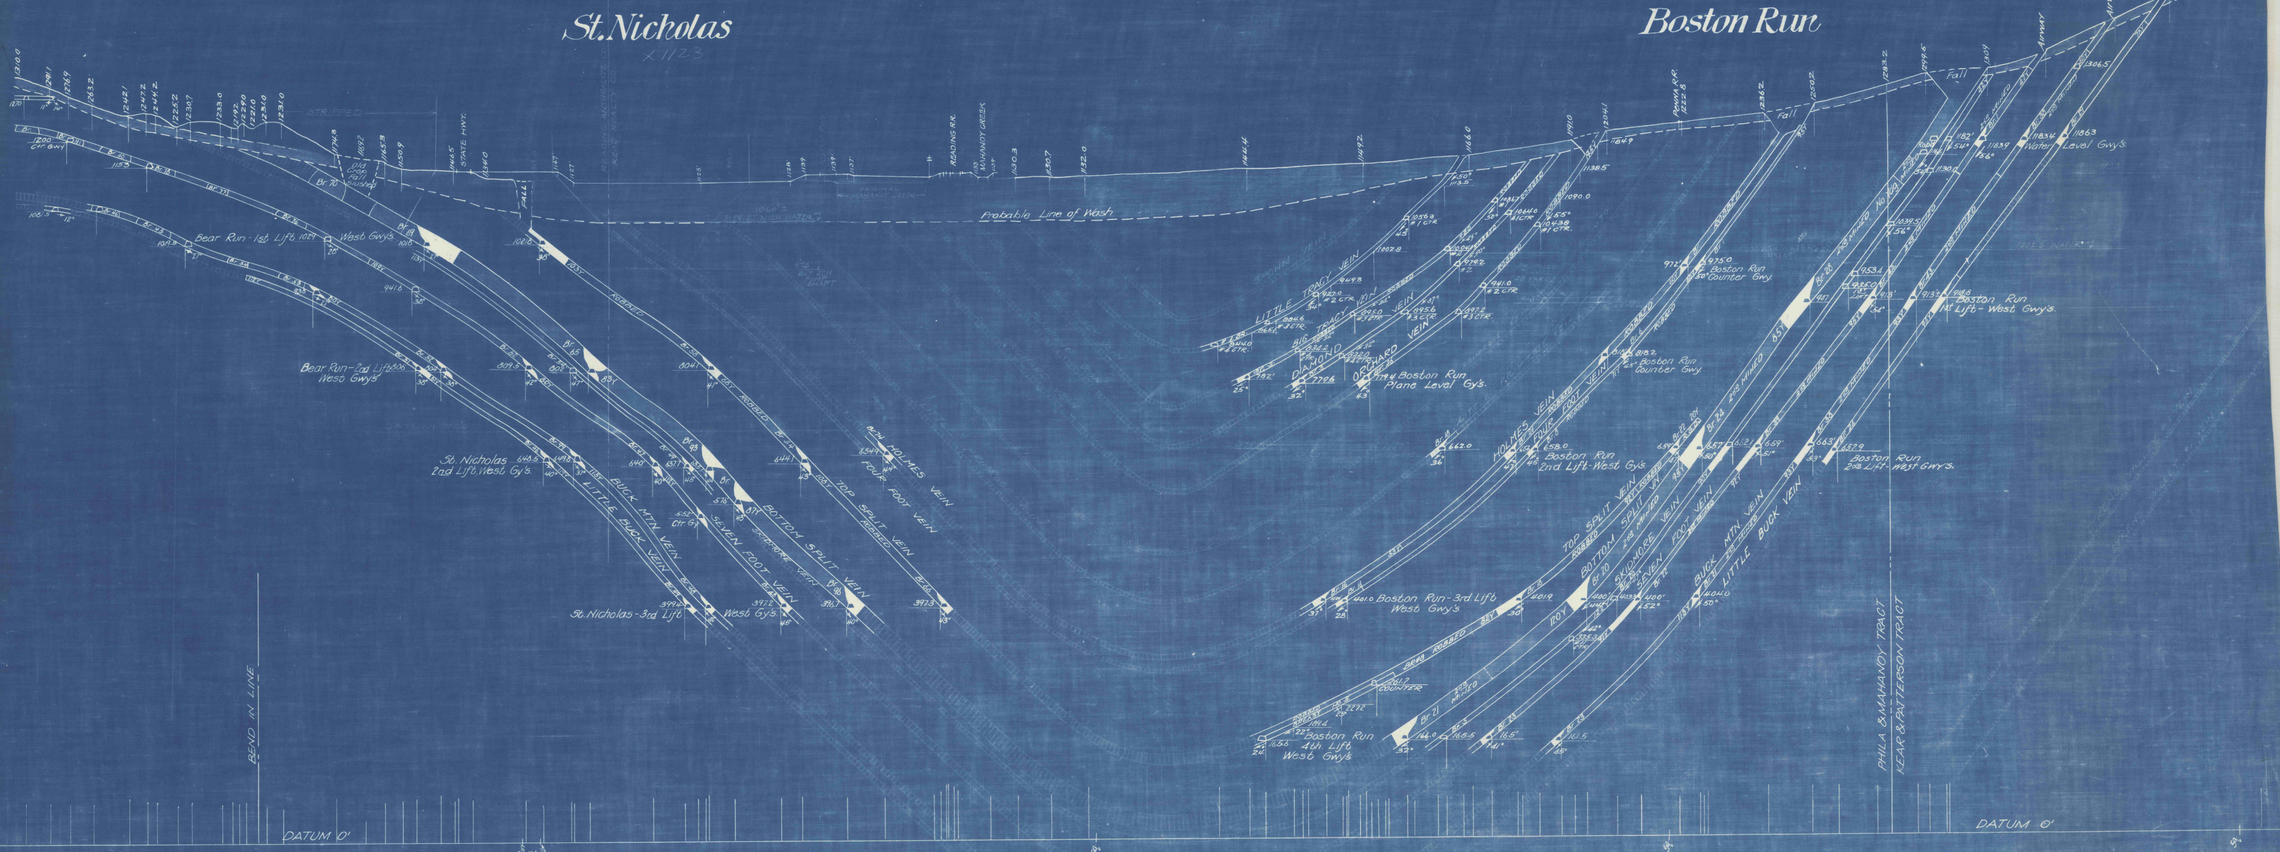

Western MIDDLE COAL FIELD.

BOSTON RUN COLLIERY. 1"=100'.

"X" section..

St. Nicholas Coll'y. "X" section - 1123: W. Mahanoy Twp.,

Schuylkill County Pa., 11 W. Mah., District. P. R. C. & I. Co.,

BOSTON RUN COLL'Y. 1-100
MAHANOY CITY, PA. MAHANOY TWP,
SCHUYLKILL COUNTY.

"5 OF 11"