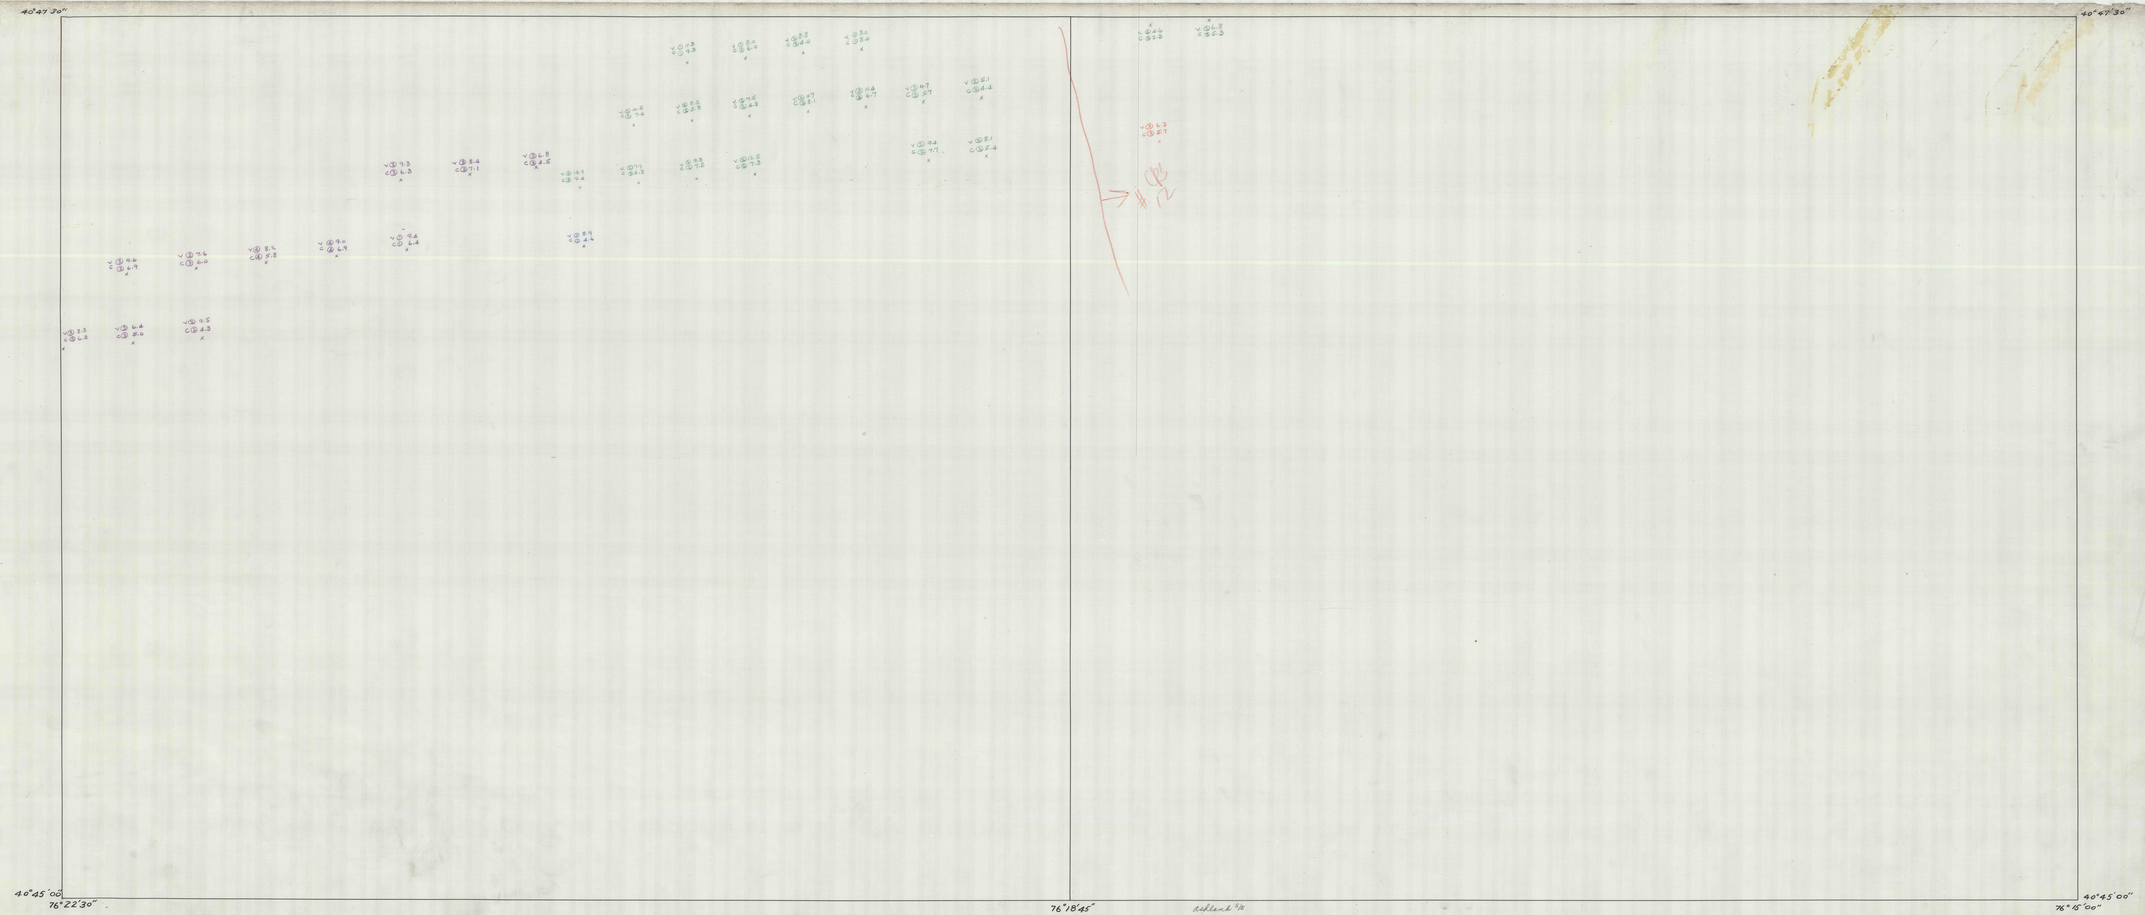

RECAPITULATION

COLLIERY NAME	U.S.G.S. DESIGNATION	COAL CO. DESIGNATION	VEIN RANGE (MIN.-MAX.)	COAL RANGE (MIN.-MAX.)
BANCROFT	14	DIAMOND	8.9 - 8.9	4.6 - 4.6
BAST	14	DIAMOND	8.1 - 13.9	4.0 - 9.4
POTTS	14	DIAMOND	6.8 - 9.6	4.8 - 7.1

No. OF READINGS	AVG. VEIN THICKNESS	AVG. COAL THICKNESS	VEIN RANGE	COAL RANGE
17	9.1	6.3	5.1 - 13.9	4.0 - 9.4

Ashland 9A

RECAPITULATION

COLLIERY NAME	U.S.G.S. DESIGNATION	COAL CO. DESIGNATION	VEIN RANGE (MIN.-MAX.)	COAL RANGE (MIN.-MAX.)
BAST	14	DIAMOND	4.4 - 6.3	2.3 - 5.3
PRESTON No. 3	14	DIAMOND	6.3 - 6.3	5.7 - 5.7

No. OF READINGS	AVG. VEIN THICKNESS	AVG. COAL THICKNESS	VEIN RANGE	COAL RANGE
7	5.7	4.4	4.6 - 6.8	2.3 - 5.7

COAL THICKNESS SHEET FOR DIAMOND VEIN
ASHLAND QUADRANGLE (S.W. & S.E. PARTS)

BANCROFT COLLIERY
BAST COLLIERY
POTTS COLLIERY
PRESTON No. 3 (TUNNEL)

MAP 218
TUBE 44