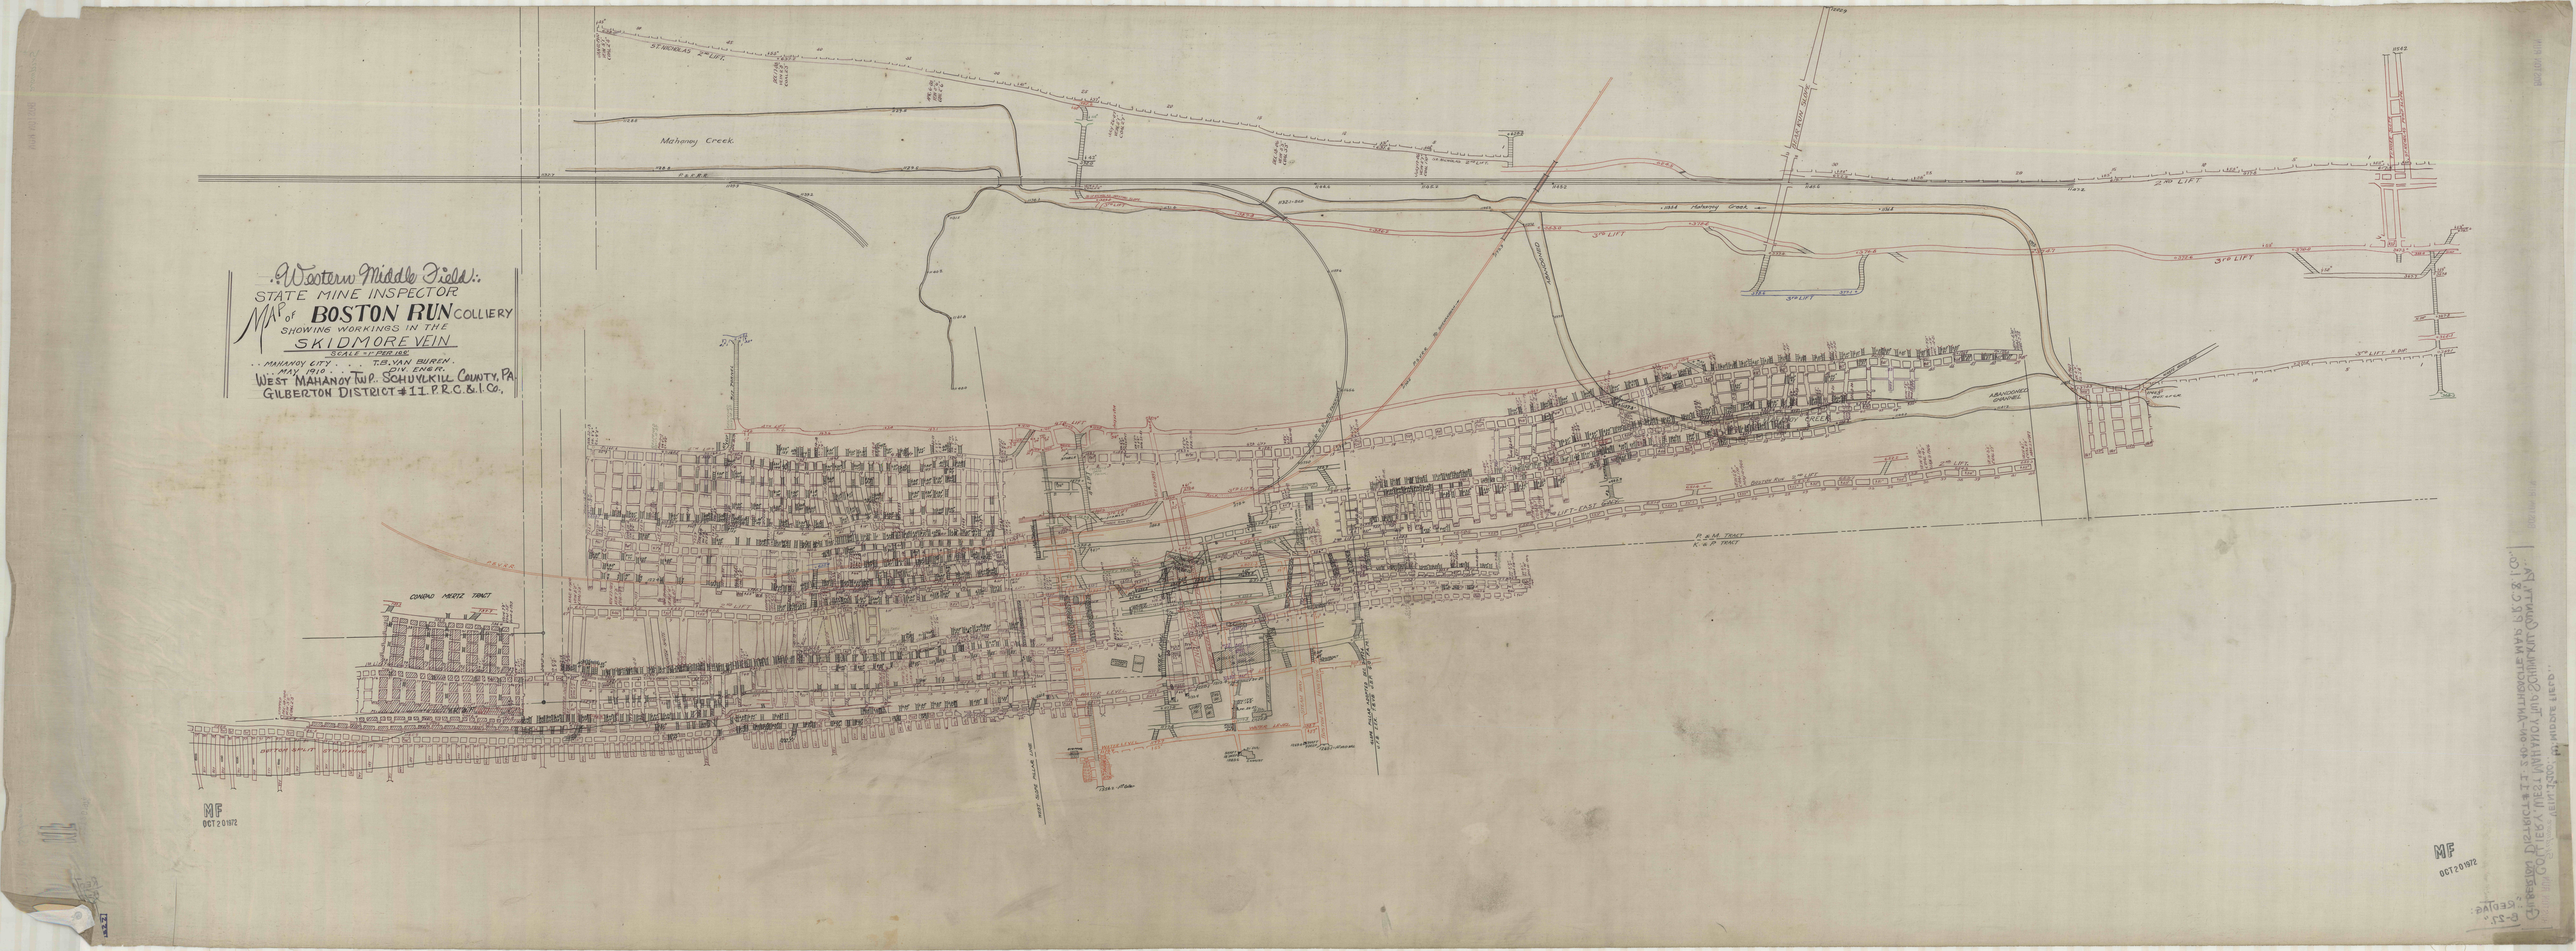
Western Middle Field
STATE MINE INSPECTOR
MAP of BOSTON RUN COLLIERY
SHOWING WORKINGS IN THE
SKIDMORE VEIN
SCALE = 1" PER 100'
MAHANOY CITY . . . T.B. VAN BUREN.
MAY 1910 . . . DIV. ENGR.
WEST MAHANOY TWP. SCHUYLKILL COUNTY, PA.
GILBERTON DISTRICT #11. P.R.C.&I.Co.
Mahanoy Creek
ST. NICHOLAS 2ND LIFT
2ND LIFT
3RD LIFT
CONRAD MERTZ TRACT
P. & M. TRACT
K. & P. TRACT
MF
OCT 20 1972