


Boston

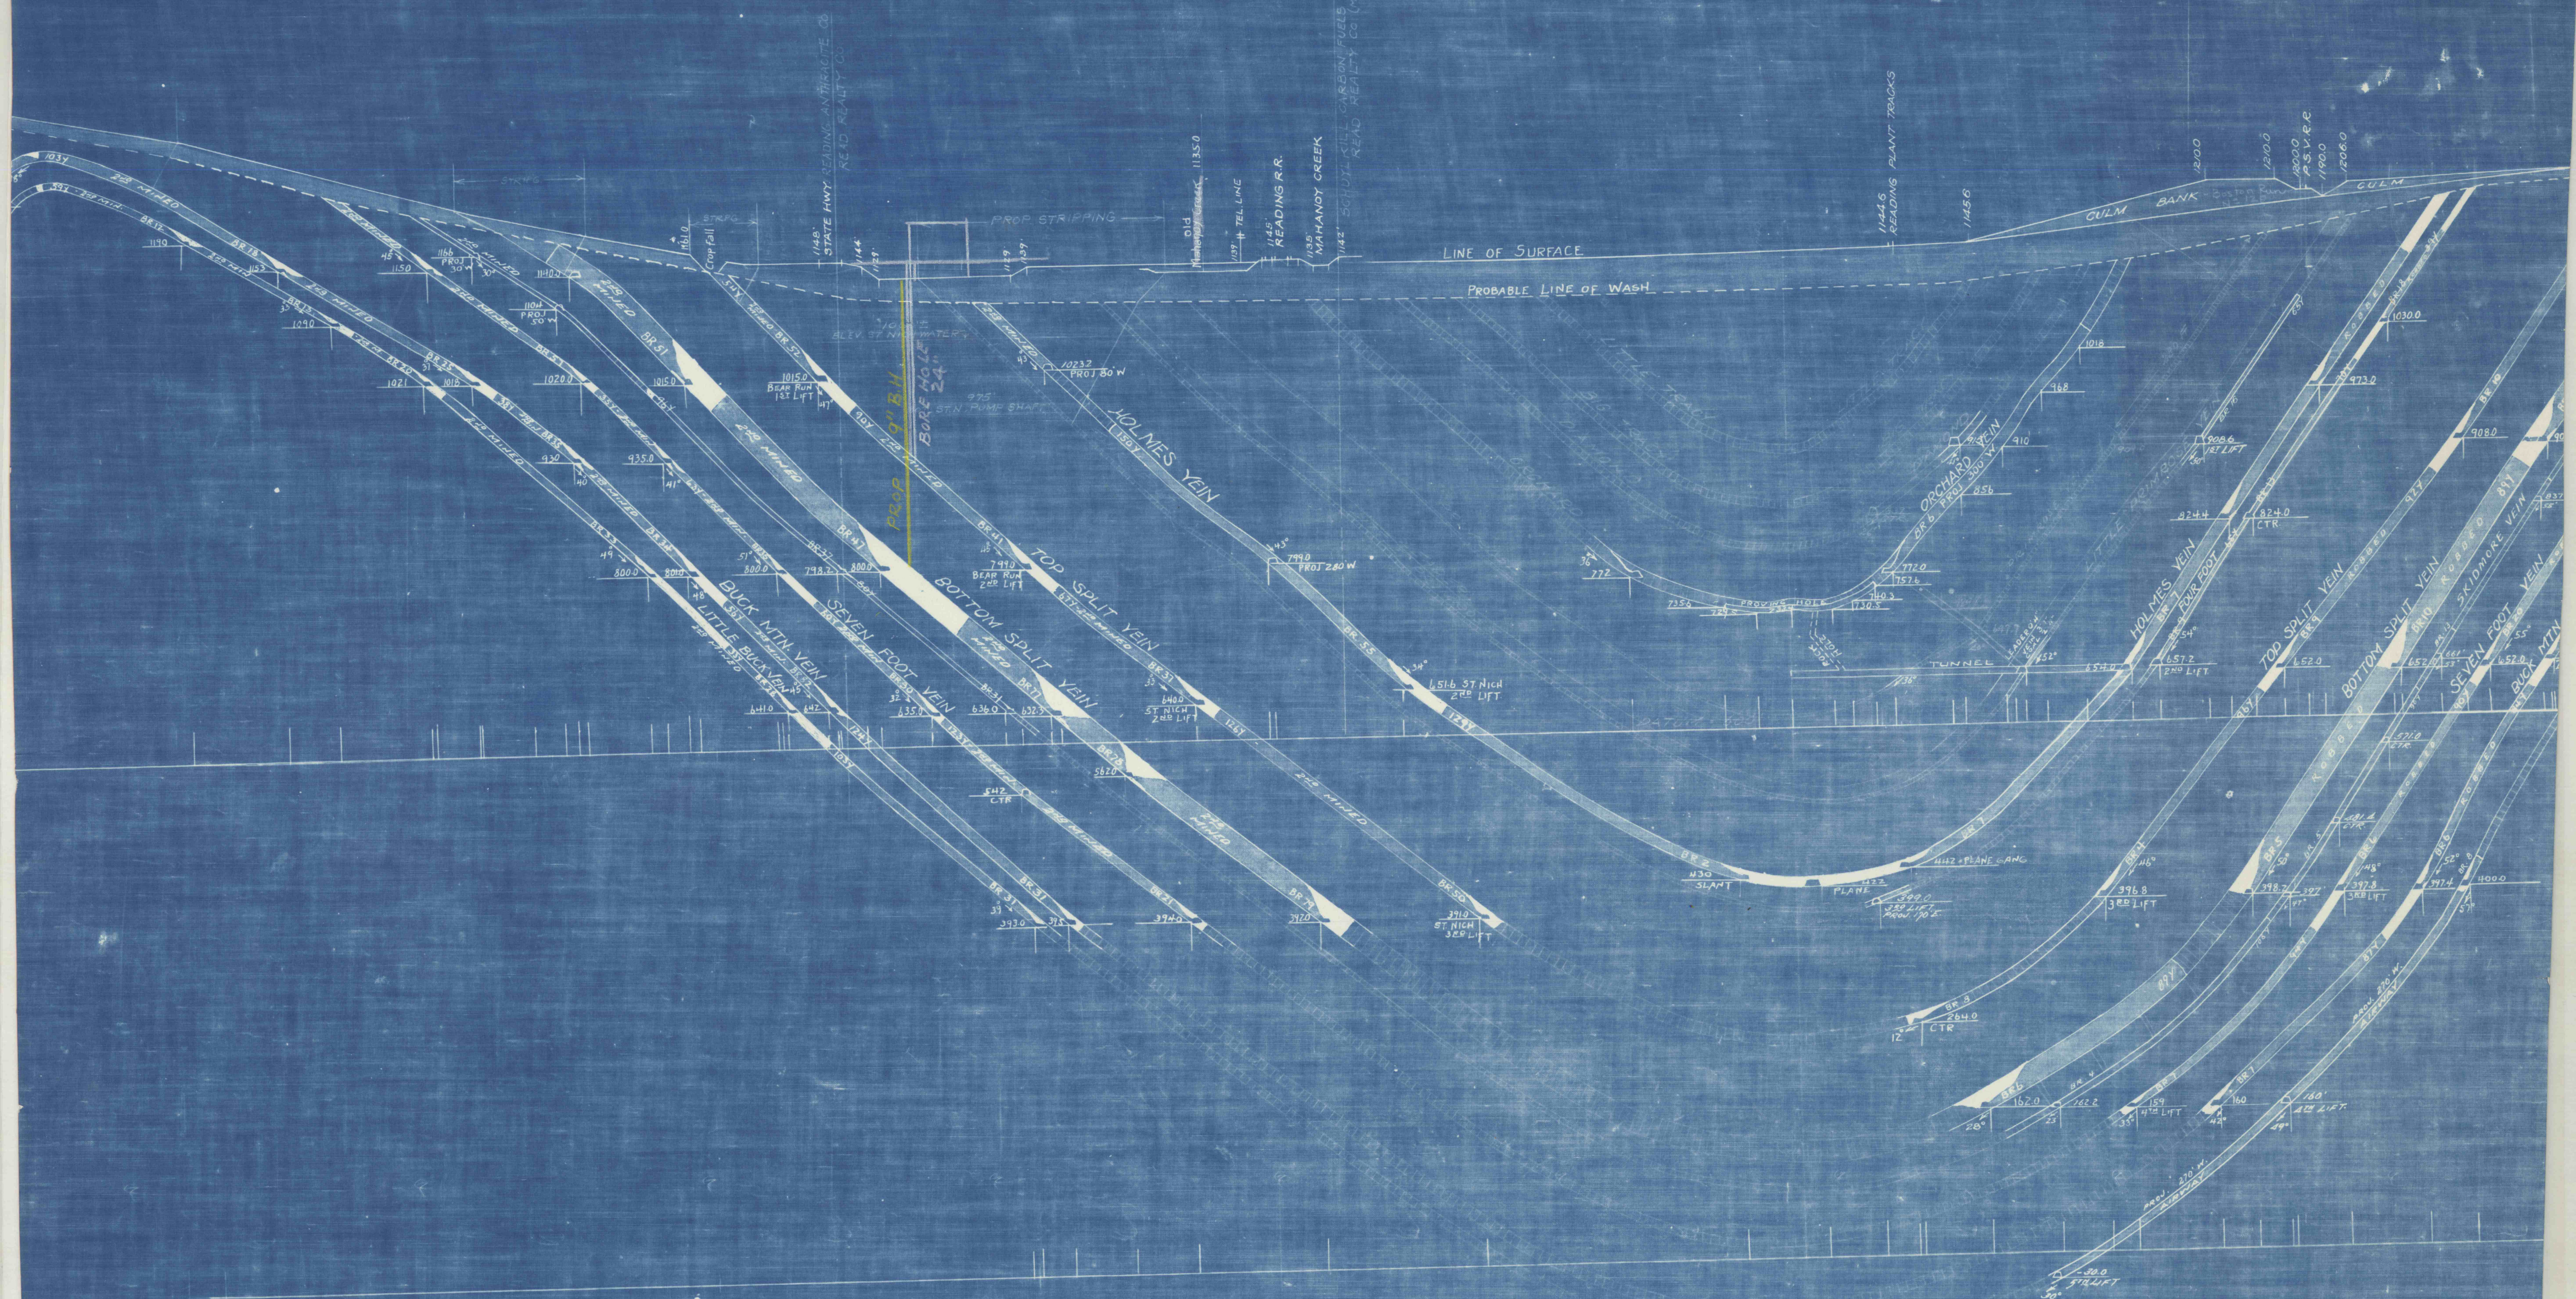

BOSTON RUN Coll'y / ST. NICHOLAS Coll'y;
MAHANOEY CITY, PA
"MAHANOEY TWP, SCHUY. COUNTY. P. R. C. & I. CO..
110 F 11"