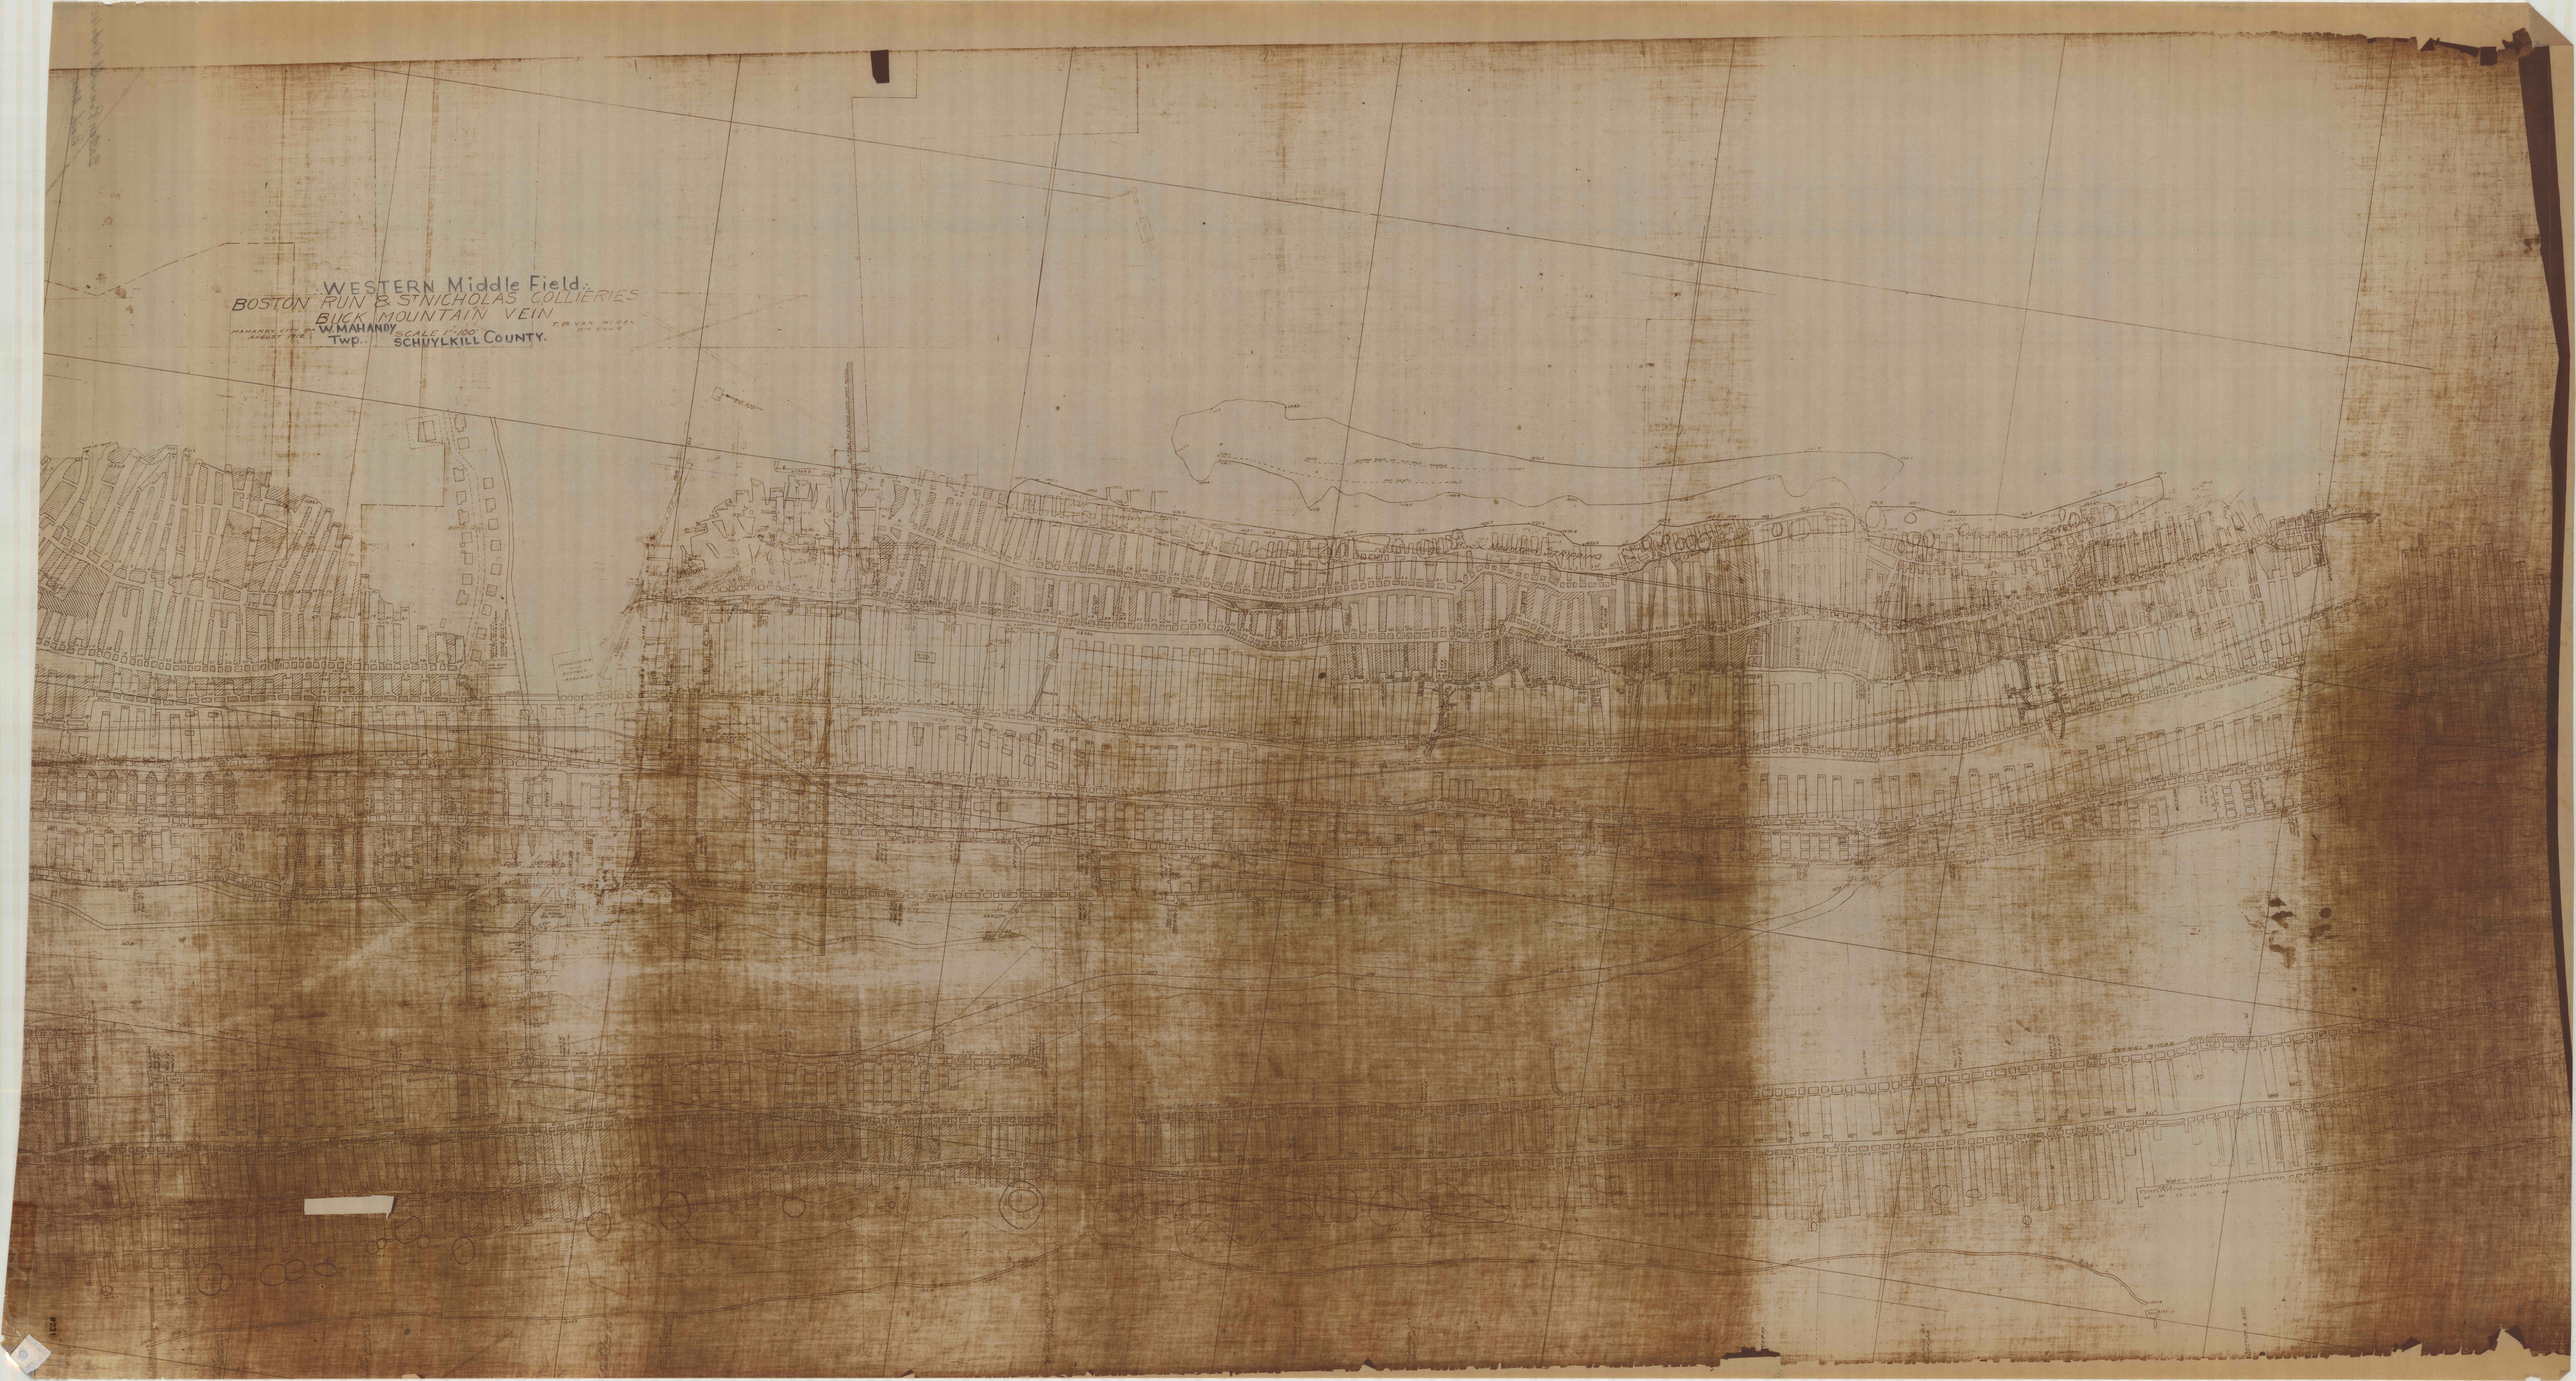

WESTERN Middle Field.
BOSTON RUN & St NICHOLAS COLLIERIES
BUCK MOUNTAIN VEIN
MAHANOY CITY P.O.
AUGUST 1871
W. MAHANDY
Twp.
SCALE 1:100
SCHUYLKILL County.