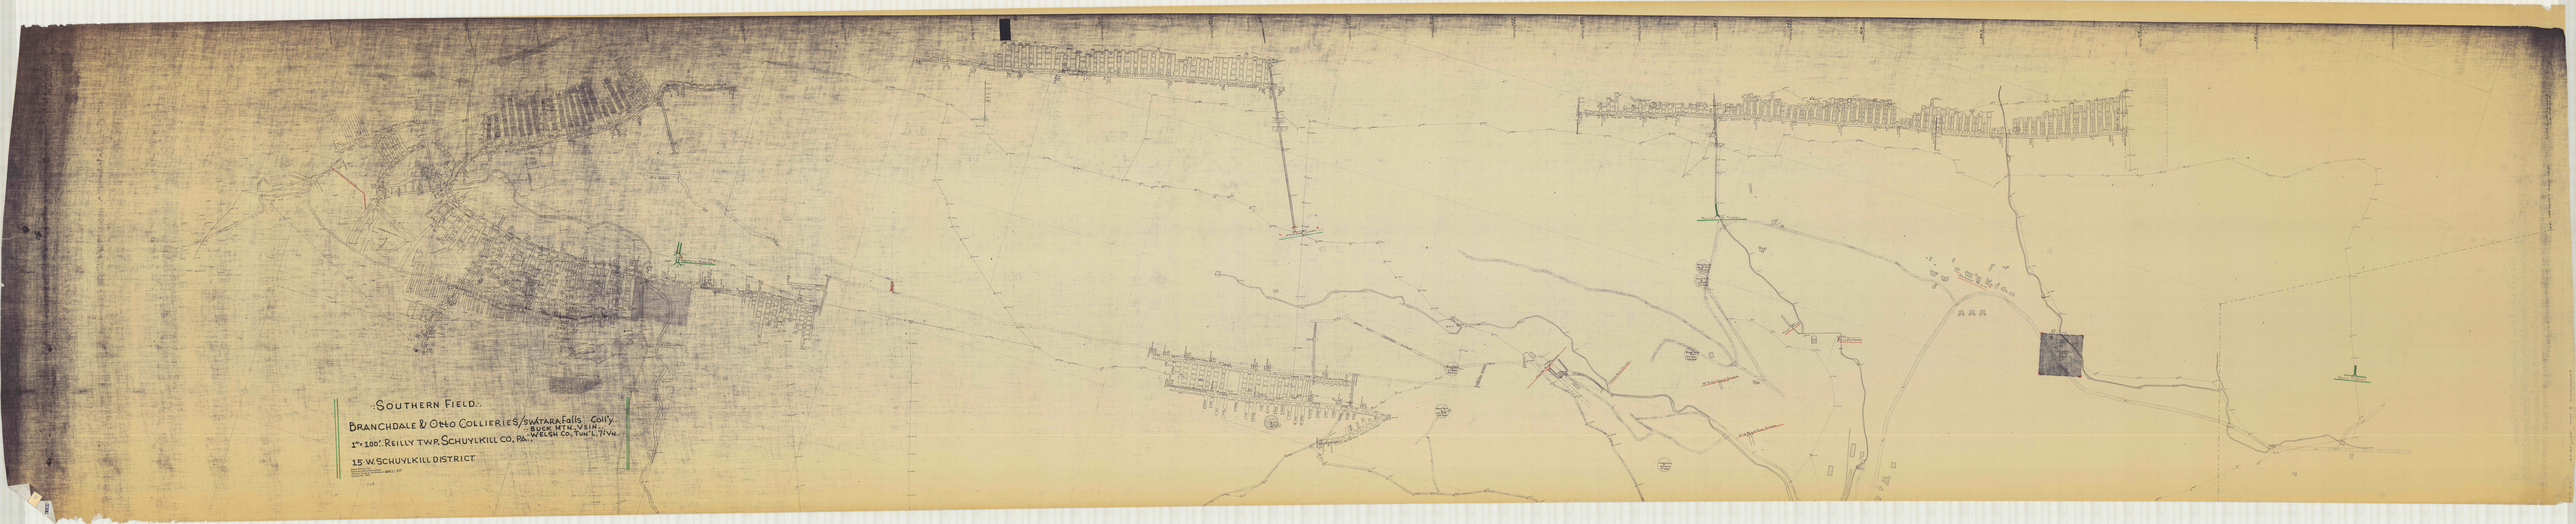
·SOUTHERN FIELD·
BRANCHDALE & OTTO COLLIERIES/SWATARA Falls Colly.
BUCK MTN. VEIN
1"=100'. REILLY TWP. SCHUYLKILL CO. PA. WELSH CO. TUN L. TVW.
15 W. SCHUYLKILL DISTRICT