


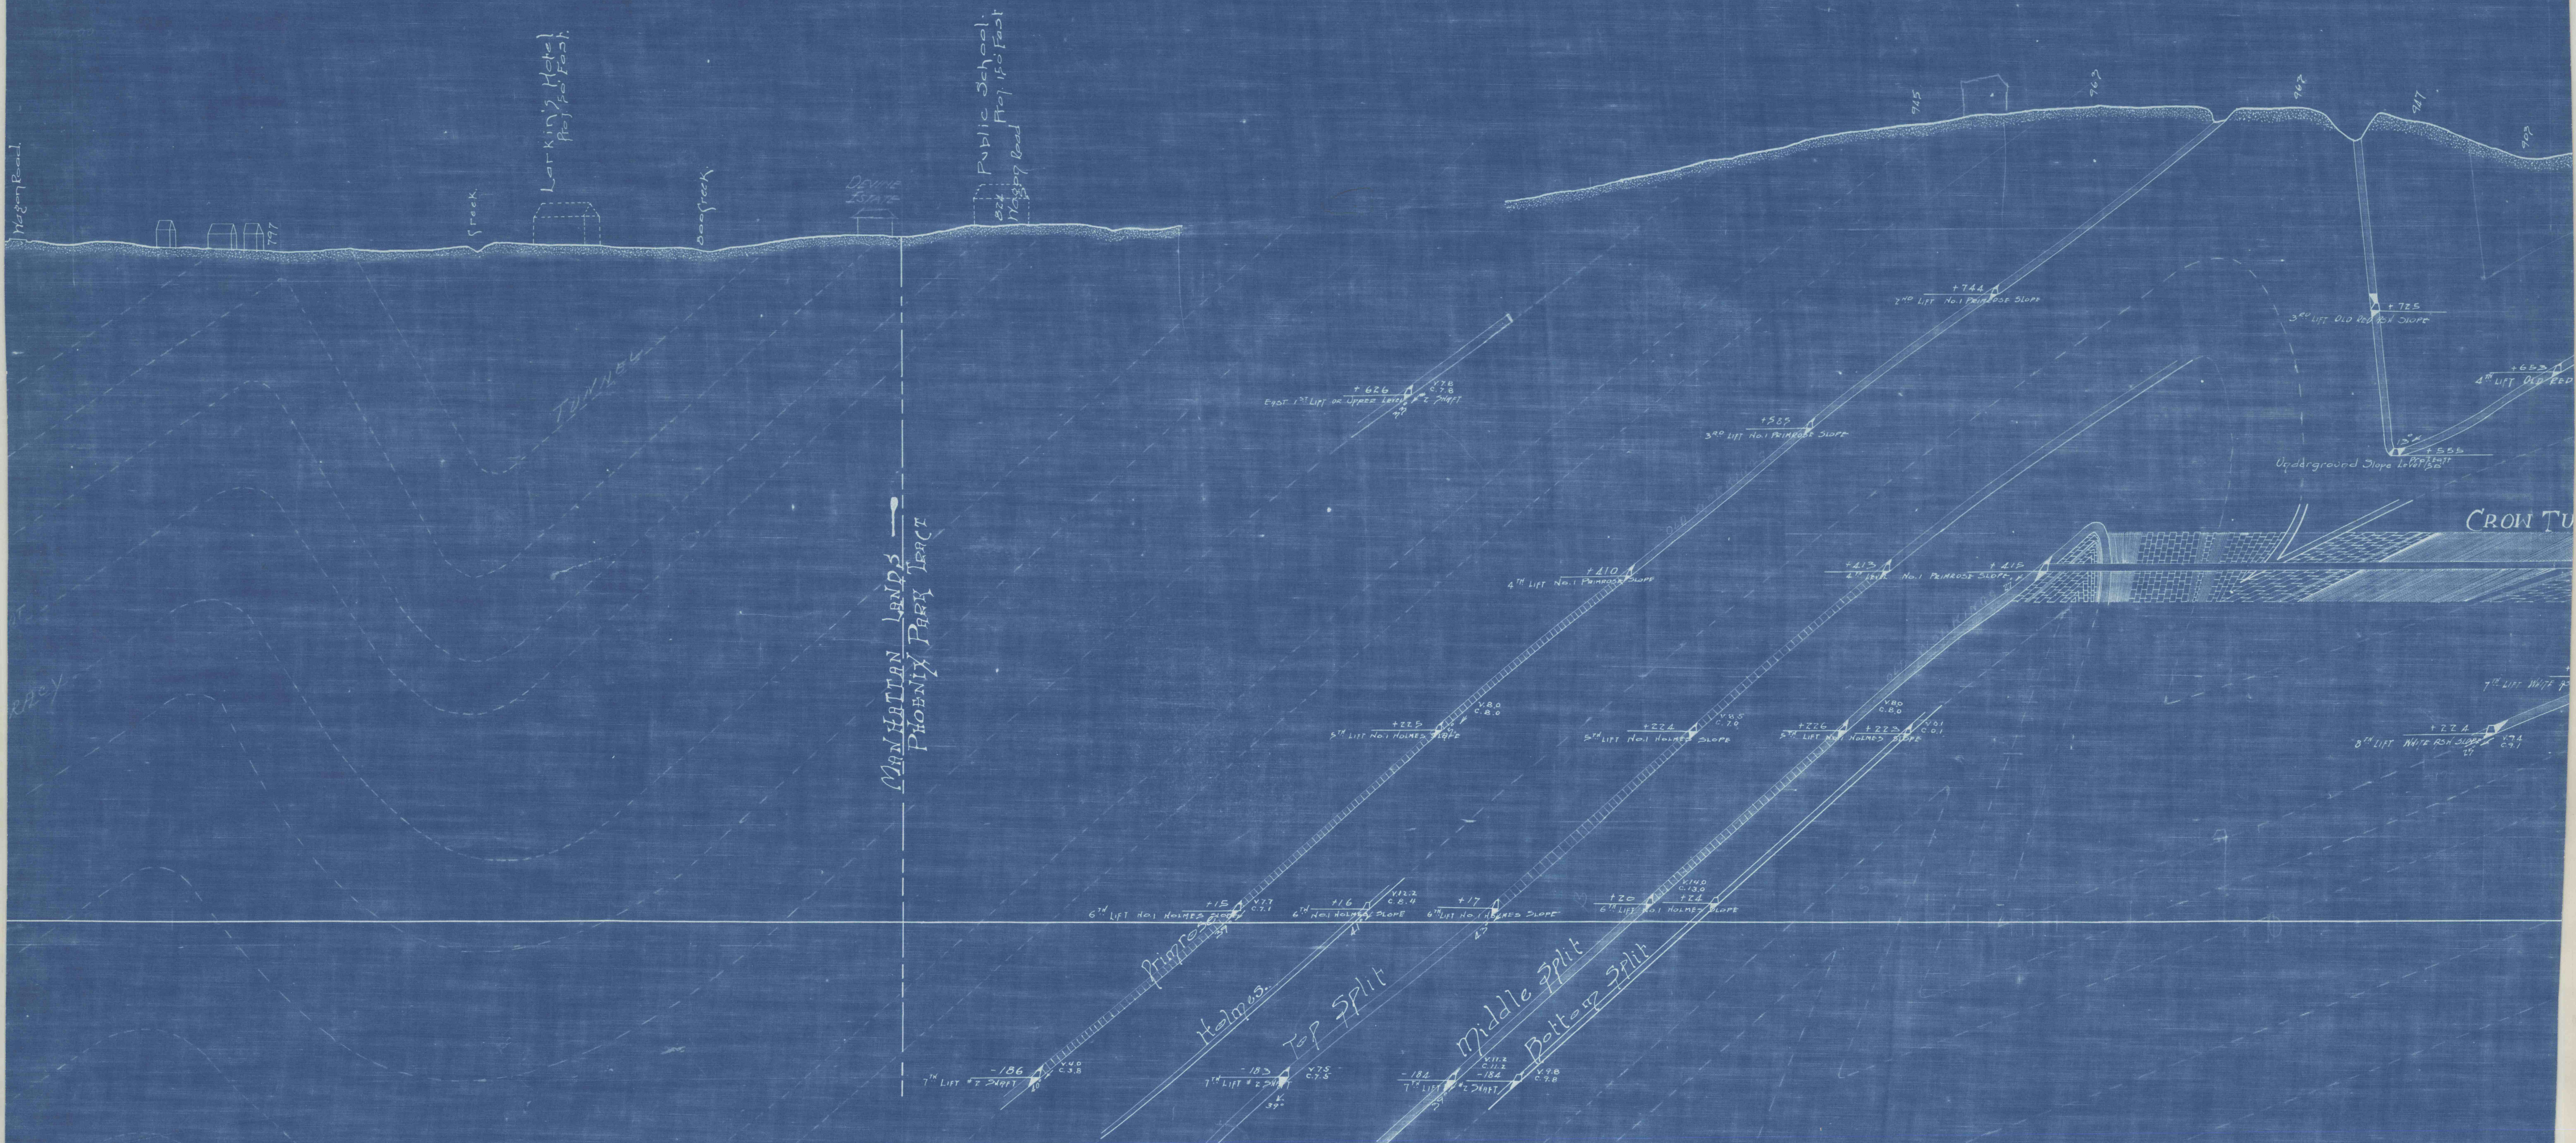

MAR 7 1975
 MF
 SOUTHERN FLD.
 BRANCHDALE Colliery. 13100'
 PHOENIX PARK TRACT. SECTION,
 MANHATTAN LANDS.
 4 OF 6. SCHUYLKILL COUNTY, PA.