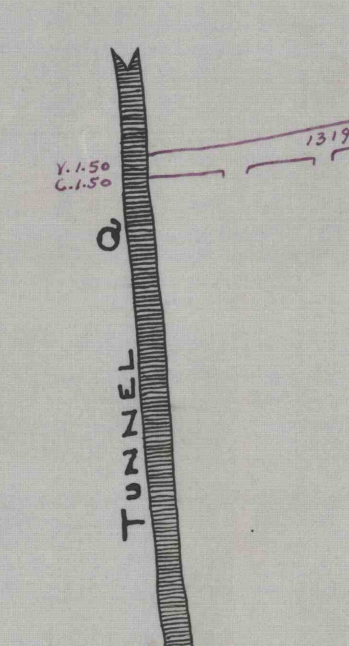
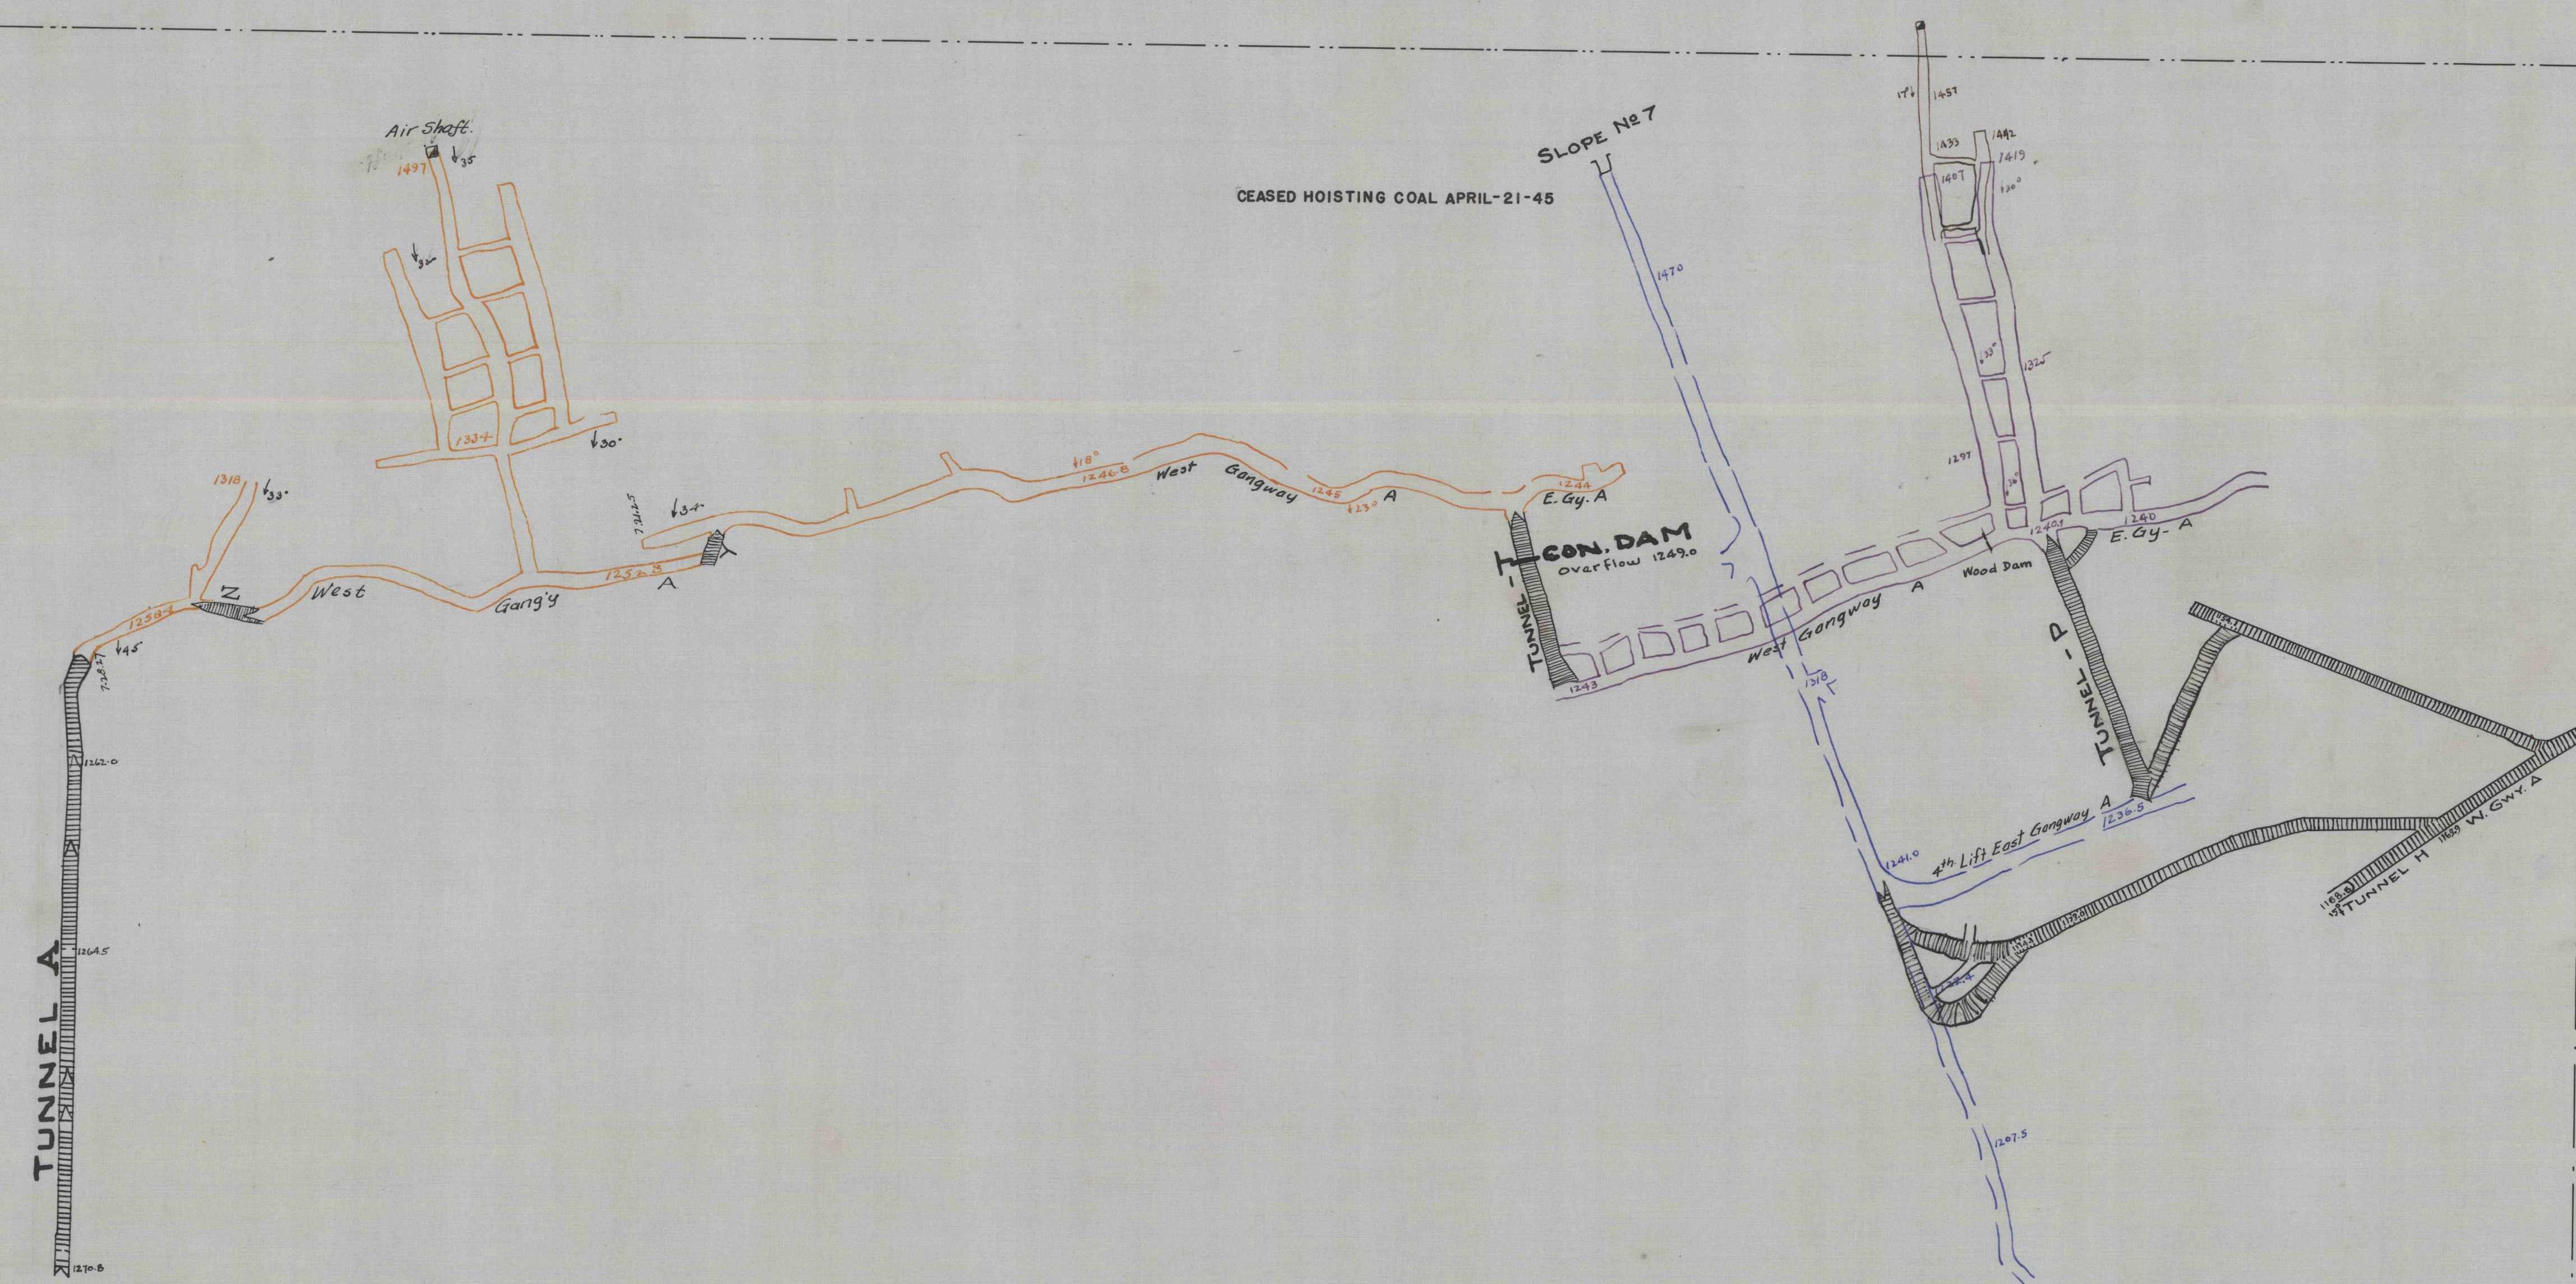


[illegible]

..EASTERN MIDDLE COAL FIELD..HAZLE TWP.
LUZERNE COUNTY, PA.,BLACK CREEK DISTRICT#7..

Extended To Jan. 2nd. 1935

11	11	Jan. 20 1936
12	12	" 10 1938
13	13	JUNE 12 1940
14	14	MAR. 10 1942
15	15	MAR. 23 1943
16	16	MAR. 31 1945
17	17	JAN. 7 1946
18	18	APR. 25 1947
19	19	" 23 1948
20	20	NOV. 17 1948
21	21	OCT. 10 1949
22	22	MAY 2 1951
23	23	ISKANDER 24 MAY 1952

..ISKANDER..24 JUNE 1976

JEDDO No 7
GAMMA VEIN

Scale 1"=100 May 1924
JEDDO-HIGHLAND COAL
JEDDO PA

LEGEND

- Indicates Top Split.
- Indicates Middle Split.
- Indicates Bottom Split.