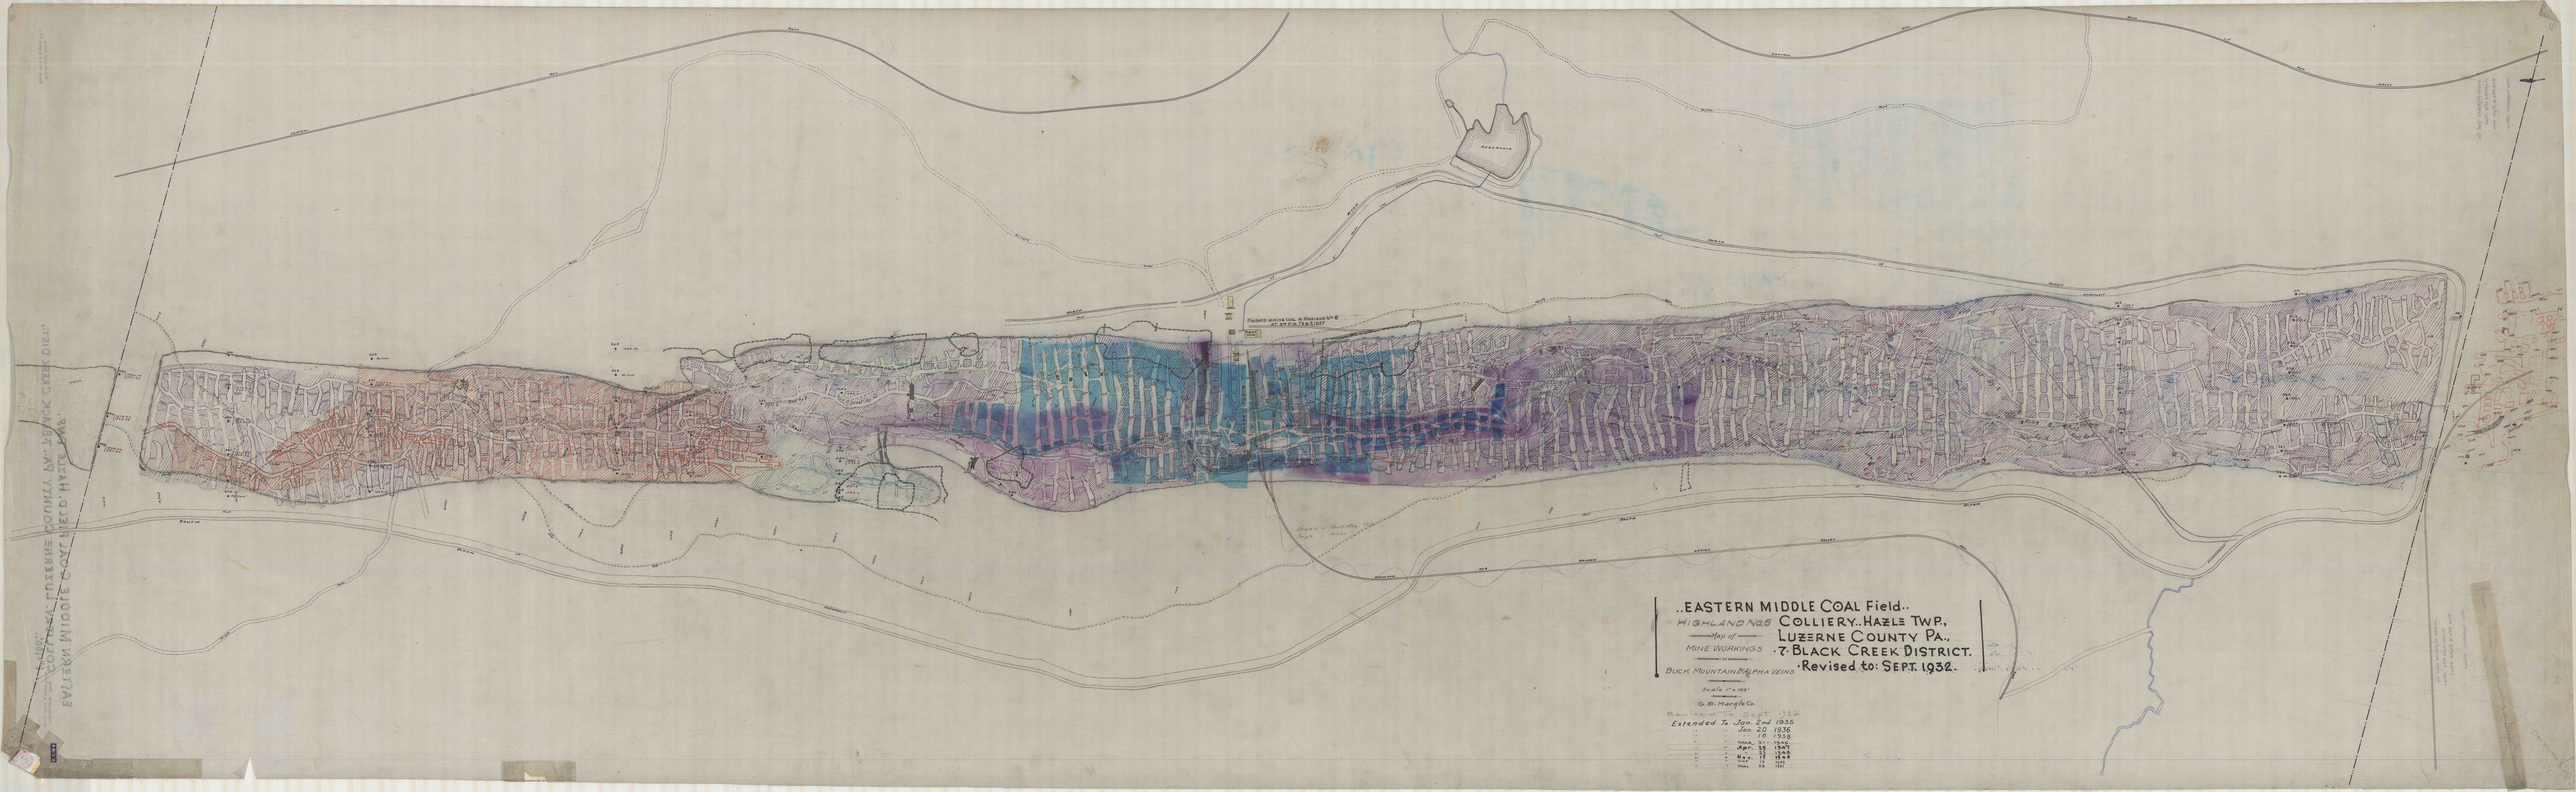

CENTRAL RAIL ROAD of NEW JERSEY
Private Road
RESERVOIR
DITCH
Embankment
4" Water Line
North Foot of DITCH Embankment
North Edge
Stable
Supply Store
Engine House
SLOPE No. 6
TUNNEL
Gangway
Shaft
SHAFT
Airshaft
No Coal
South Foot of DITCH Embankment
LEHIGH VALLEY RAIL ROAD
HIGHLAND No. 6 BRANCH

FINISHED MINING COAL IN HIGHLAND No. 6
AT 3rd P.M. FEB. 5, 1937

Green = Buck Mtn. Vein
Purple = Alpha " "

..EASTERN MIDDLE COAL Field..
HIGHLAND No. 6 COLLIERY.. HAZLE TWP.,
Map of LUZERNE COUNTY PA.,
MINE WORKINGS ·7· BLACK CREEK DISTRICT.
IN ·Revised to: SEPT. 1932.
BUCK MOUNTAIN & ALPHA VEINS

Scale 1" = 100'

G.B. Markle Co.

Revised To Sept 1932

Extended To Jan. 2nd. 1935
" " Jan. 20 1936
" " " 10 1938
" " Mar. 31 - 1945
" " Apr. 25 1947
" " " 23 1948
" " Nov. 17 1948
" " Oct 10 1949
" " May 28 1951