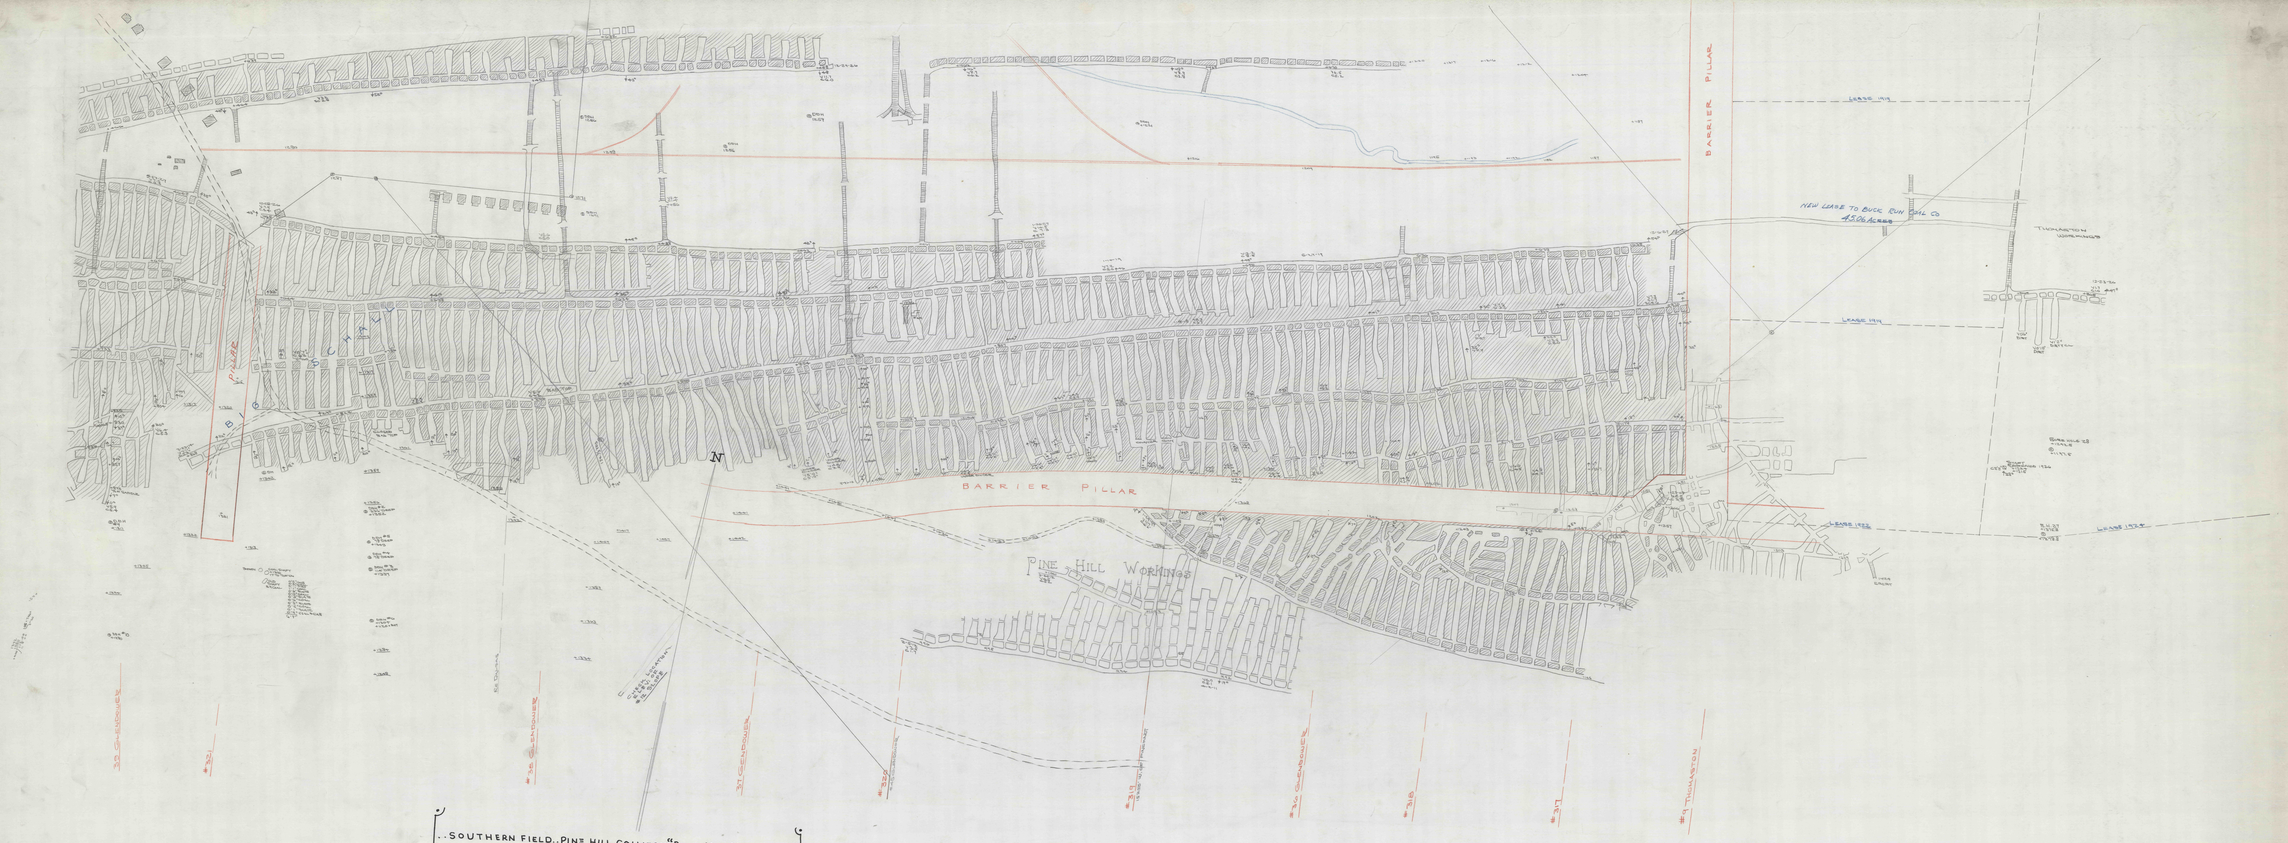

LEASE 1919
BARRIER PILLAR
NEW LEASE TO BUCK RUN COAL CO
45.06 ACRES
THOMASTON WORKINGS
12-6-27
12-23-26
LEASE 1919
BIG SHAFT PILLAR
N
BARRIER PILLAR
PINE HILL WORKINGS
LEASE 1924
LEASE 1924
30 GLENDOWER
#321
#35 GLENDOWER
31 GLENDOWER
#320
#319
#310 GLENDOWER
#318
#317
#9 THOMASTON

..SOUTHERN FIELD..PINE HILL COLLIERY "BUCK MTN., VEIN, 1"=100'
CASS TWP., SCHUYLKILL COUNTY PA., 15·W. SCHUYLKILL DISTRICT.

READING ANTHRACITE COLLIERIES.
WITH BUCK RUN & THOMASON WORKINGS.