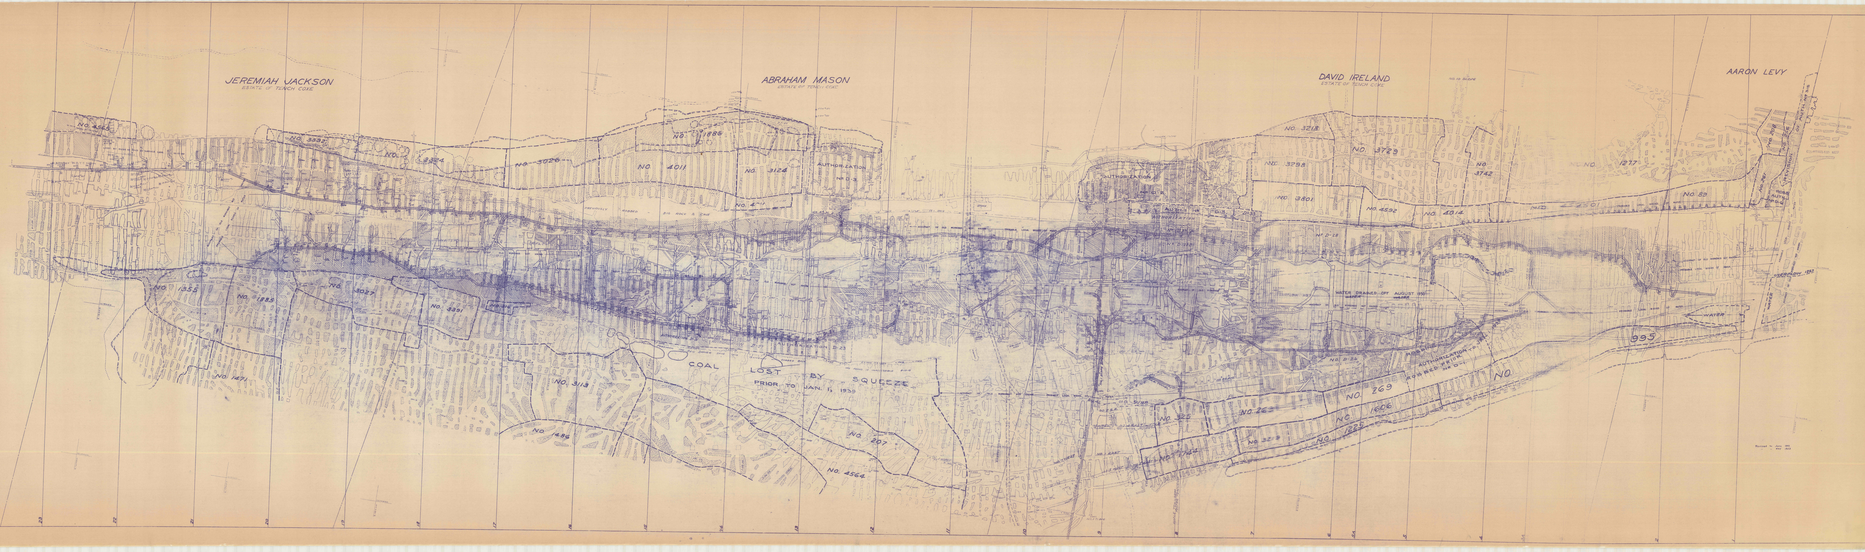

MINE INSPECTOR - BUCK MTN. VEIN - EAST END - 1" = 100'

8

8

JEREMIAH JACKSON
ESTATE OF TENCH COXE
ABRAHAM MASON
ESTATE OF TENCH COXE
DAVID IRELAND
ESTATE OF TENCH COXE
AARON LEVY
NO. 10 SLOPE
TENCH SLOPE
NO. 4565
NO. 3392
NO. 3324
NO. 3026
NO. 1888
NO. 4011
NO. 3124
AUTHORIZATION
No D-3
NO. 4011
PREVIOUSLY ROBBED - BIG ROCK & CAVE
STORE
AUTHORIZATION
No D-2
NO. 3218
NO. 3729
NO. 3298
NO 3742
NO. 1277
NO. 3801
NO. 4592
NO. 4014
NO 4501
NO 89
NO. 208
NO. 256
REVISION OF AUTH. No 315
NO. 261
ROBB AUTH. No D-4
AUTH. No D-5
D-33
AUTHORIZATION
No D-28
ACCURACY OF OLD WORKINGS NOT KNOWN
PROBABLE LOCAL BODIES OF WATER
WATER DRAINED OFF AUGUST 1950
WATER
OVERFLOW 1253
NO. 1355
NO. 1885
NO. 3027
NO. 3391
NO. 1316
NO. 1471
NO. 3113
NO. 1486
NO. 207
NO. 4564
AUTHORIZATION D-31
AUTHORIZATION D-27
AUTHORIZATION D-23
COAL LOST BY SQUEEZE
PRIOR TO JAN. 1, 1939
NO. D-26
ROBBING AUTHORIZATION TO JAN 1953
ROBBED PRIOR No D-1
995
NO
NO. 269
NO. 263
NO. 325
NO. 1606
NO. 1225
NO. 3219
NO. 1744
OLD SUMP
NO. 1 WEST
NO. 1 EAST
NO. 1 SLOPE
Revised to June 1951
" " May 1953
23
22
21
20
19
18
17
16
15
14
13
12
11
10
9
8
7
6
5A
5
4
3A
2
1