


62.9

BLISS COLLY. TWIN VN.

62.9

Northern Coal Field
BLISS COLLY. 1"=100'
TWIN VN. HANOVER TWP.
LUZERNE COUNTY W-BPA
GLEN ALDEN COAL CO.
4 W-BARRE DISTRICT

MF
SEP 21 1973
...4-of-4...

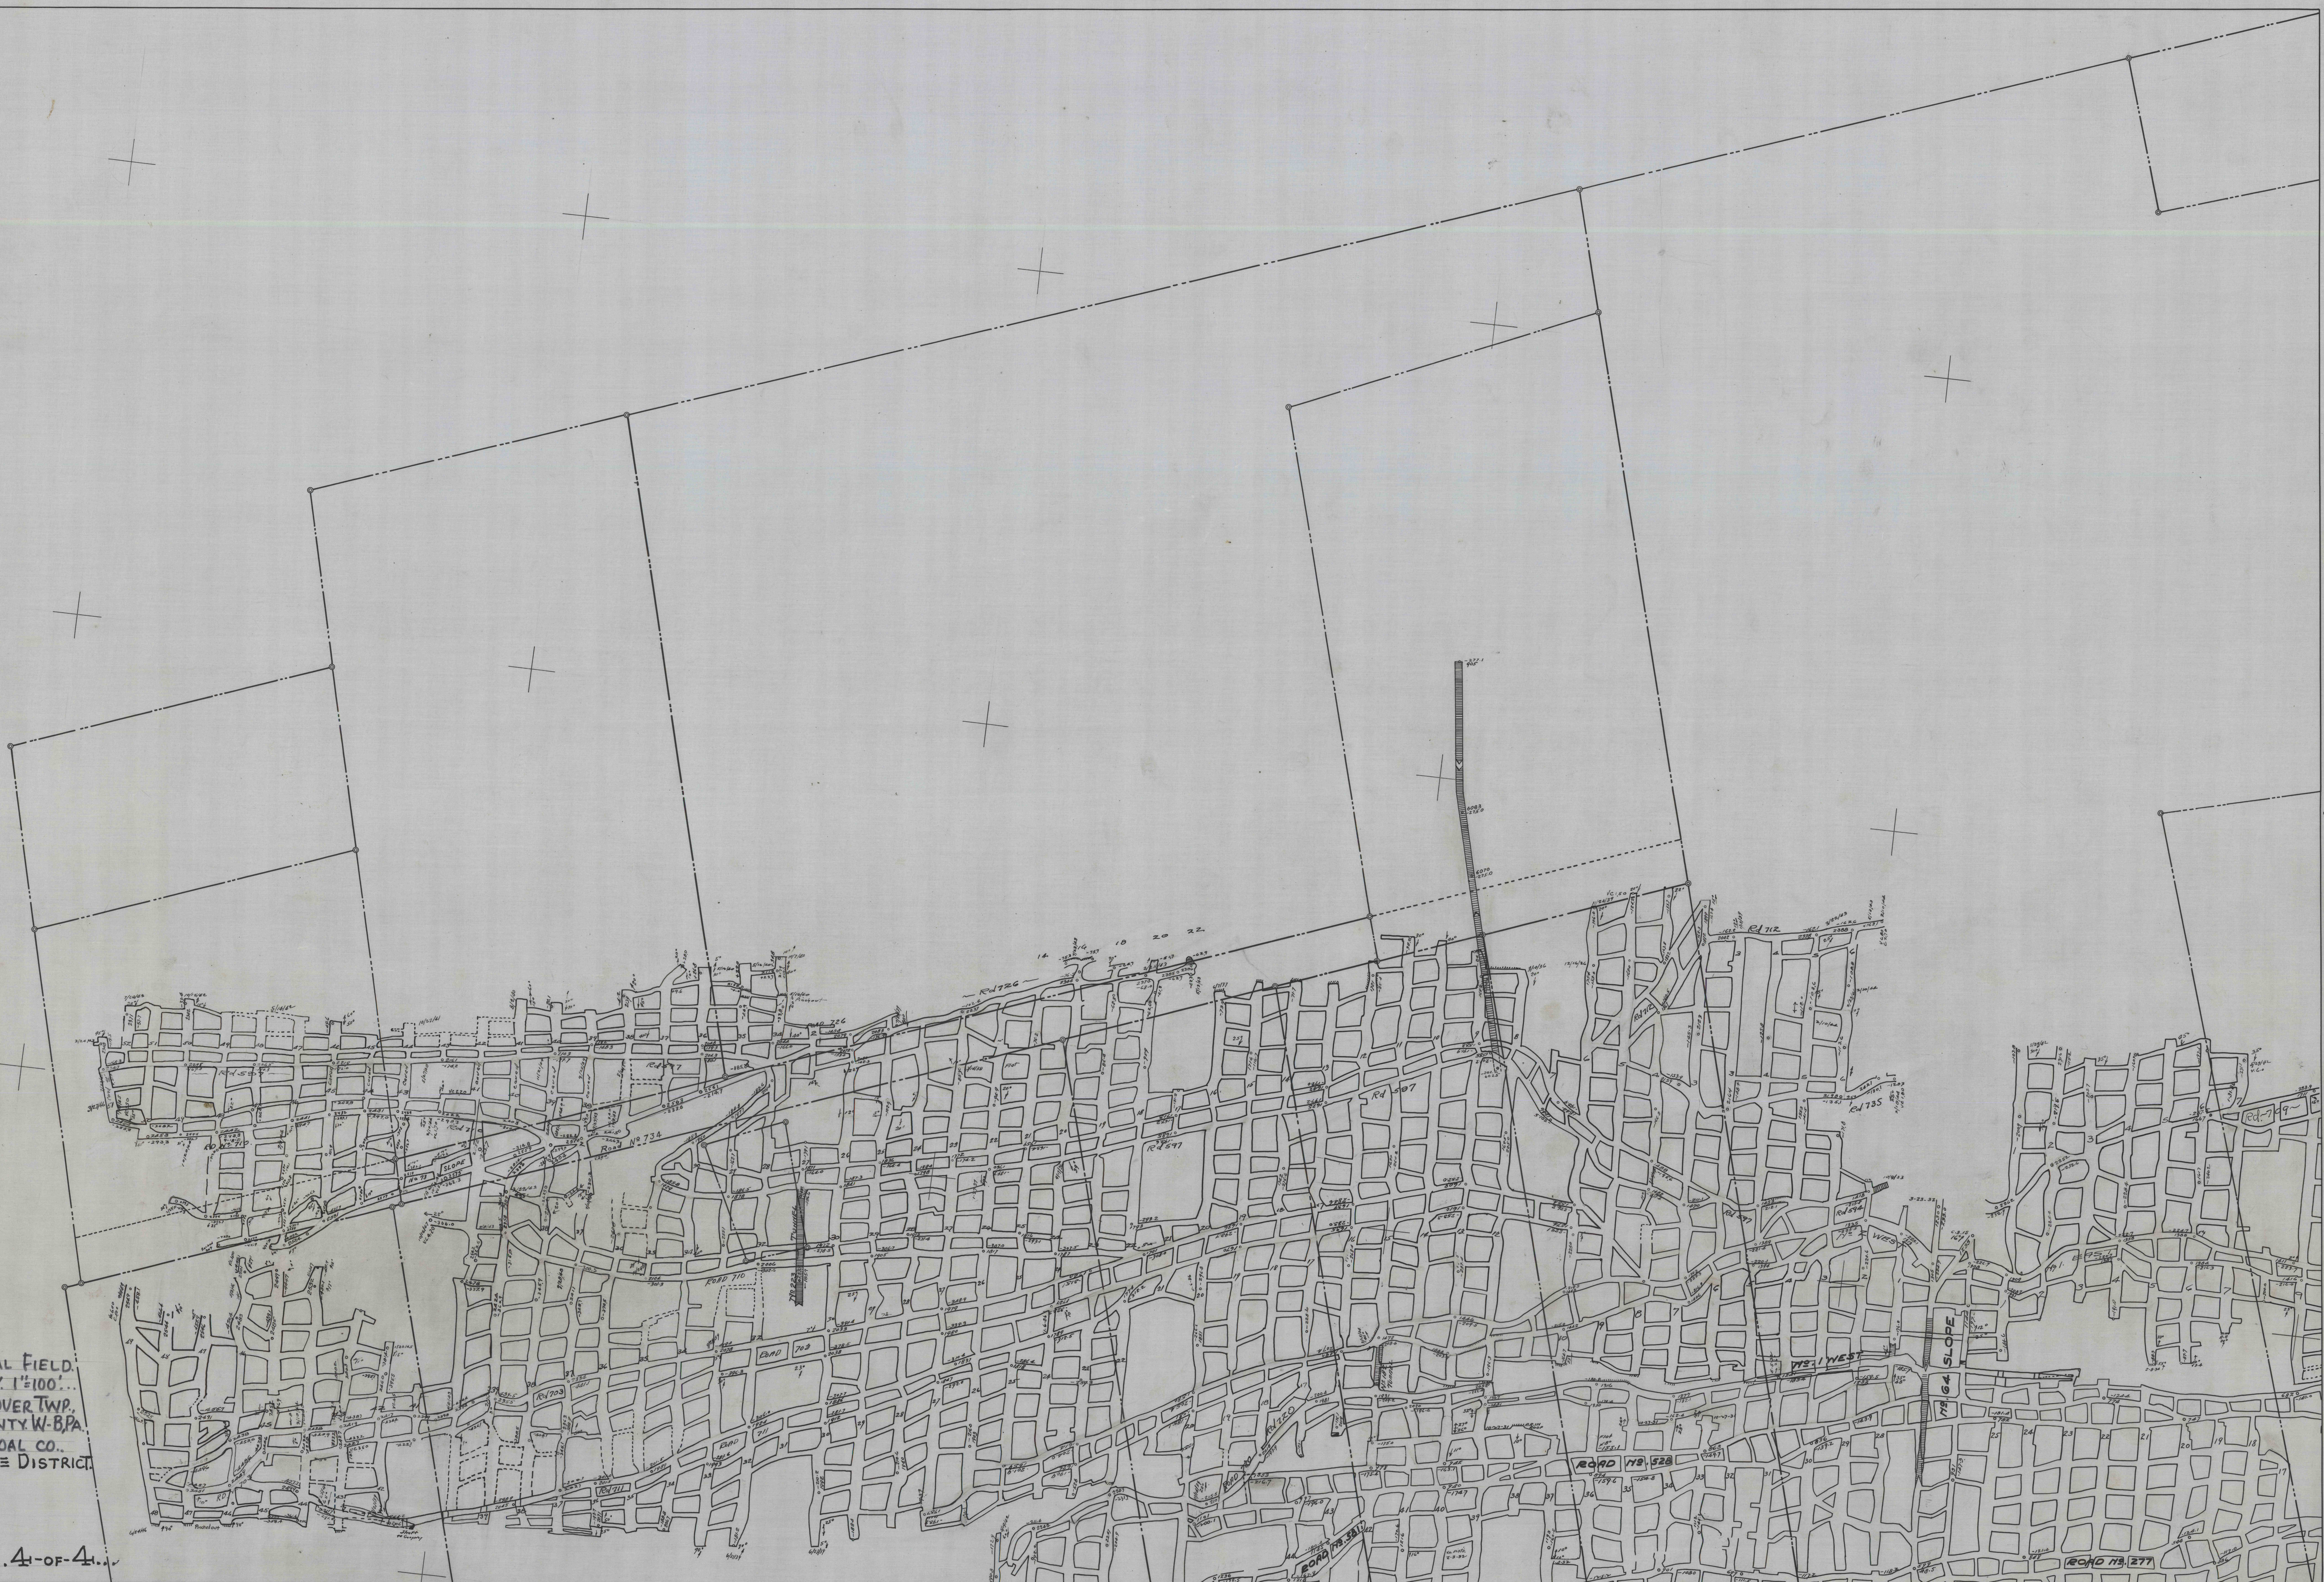

62.9

BLISS COLLY. TWIN VN.

62.9

SEP 21 1973 MF