
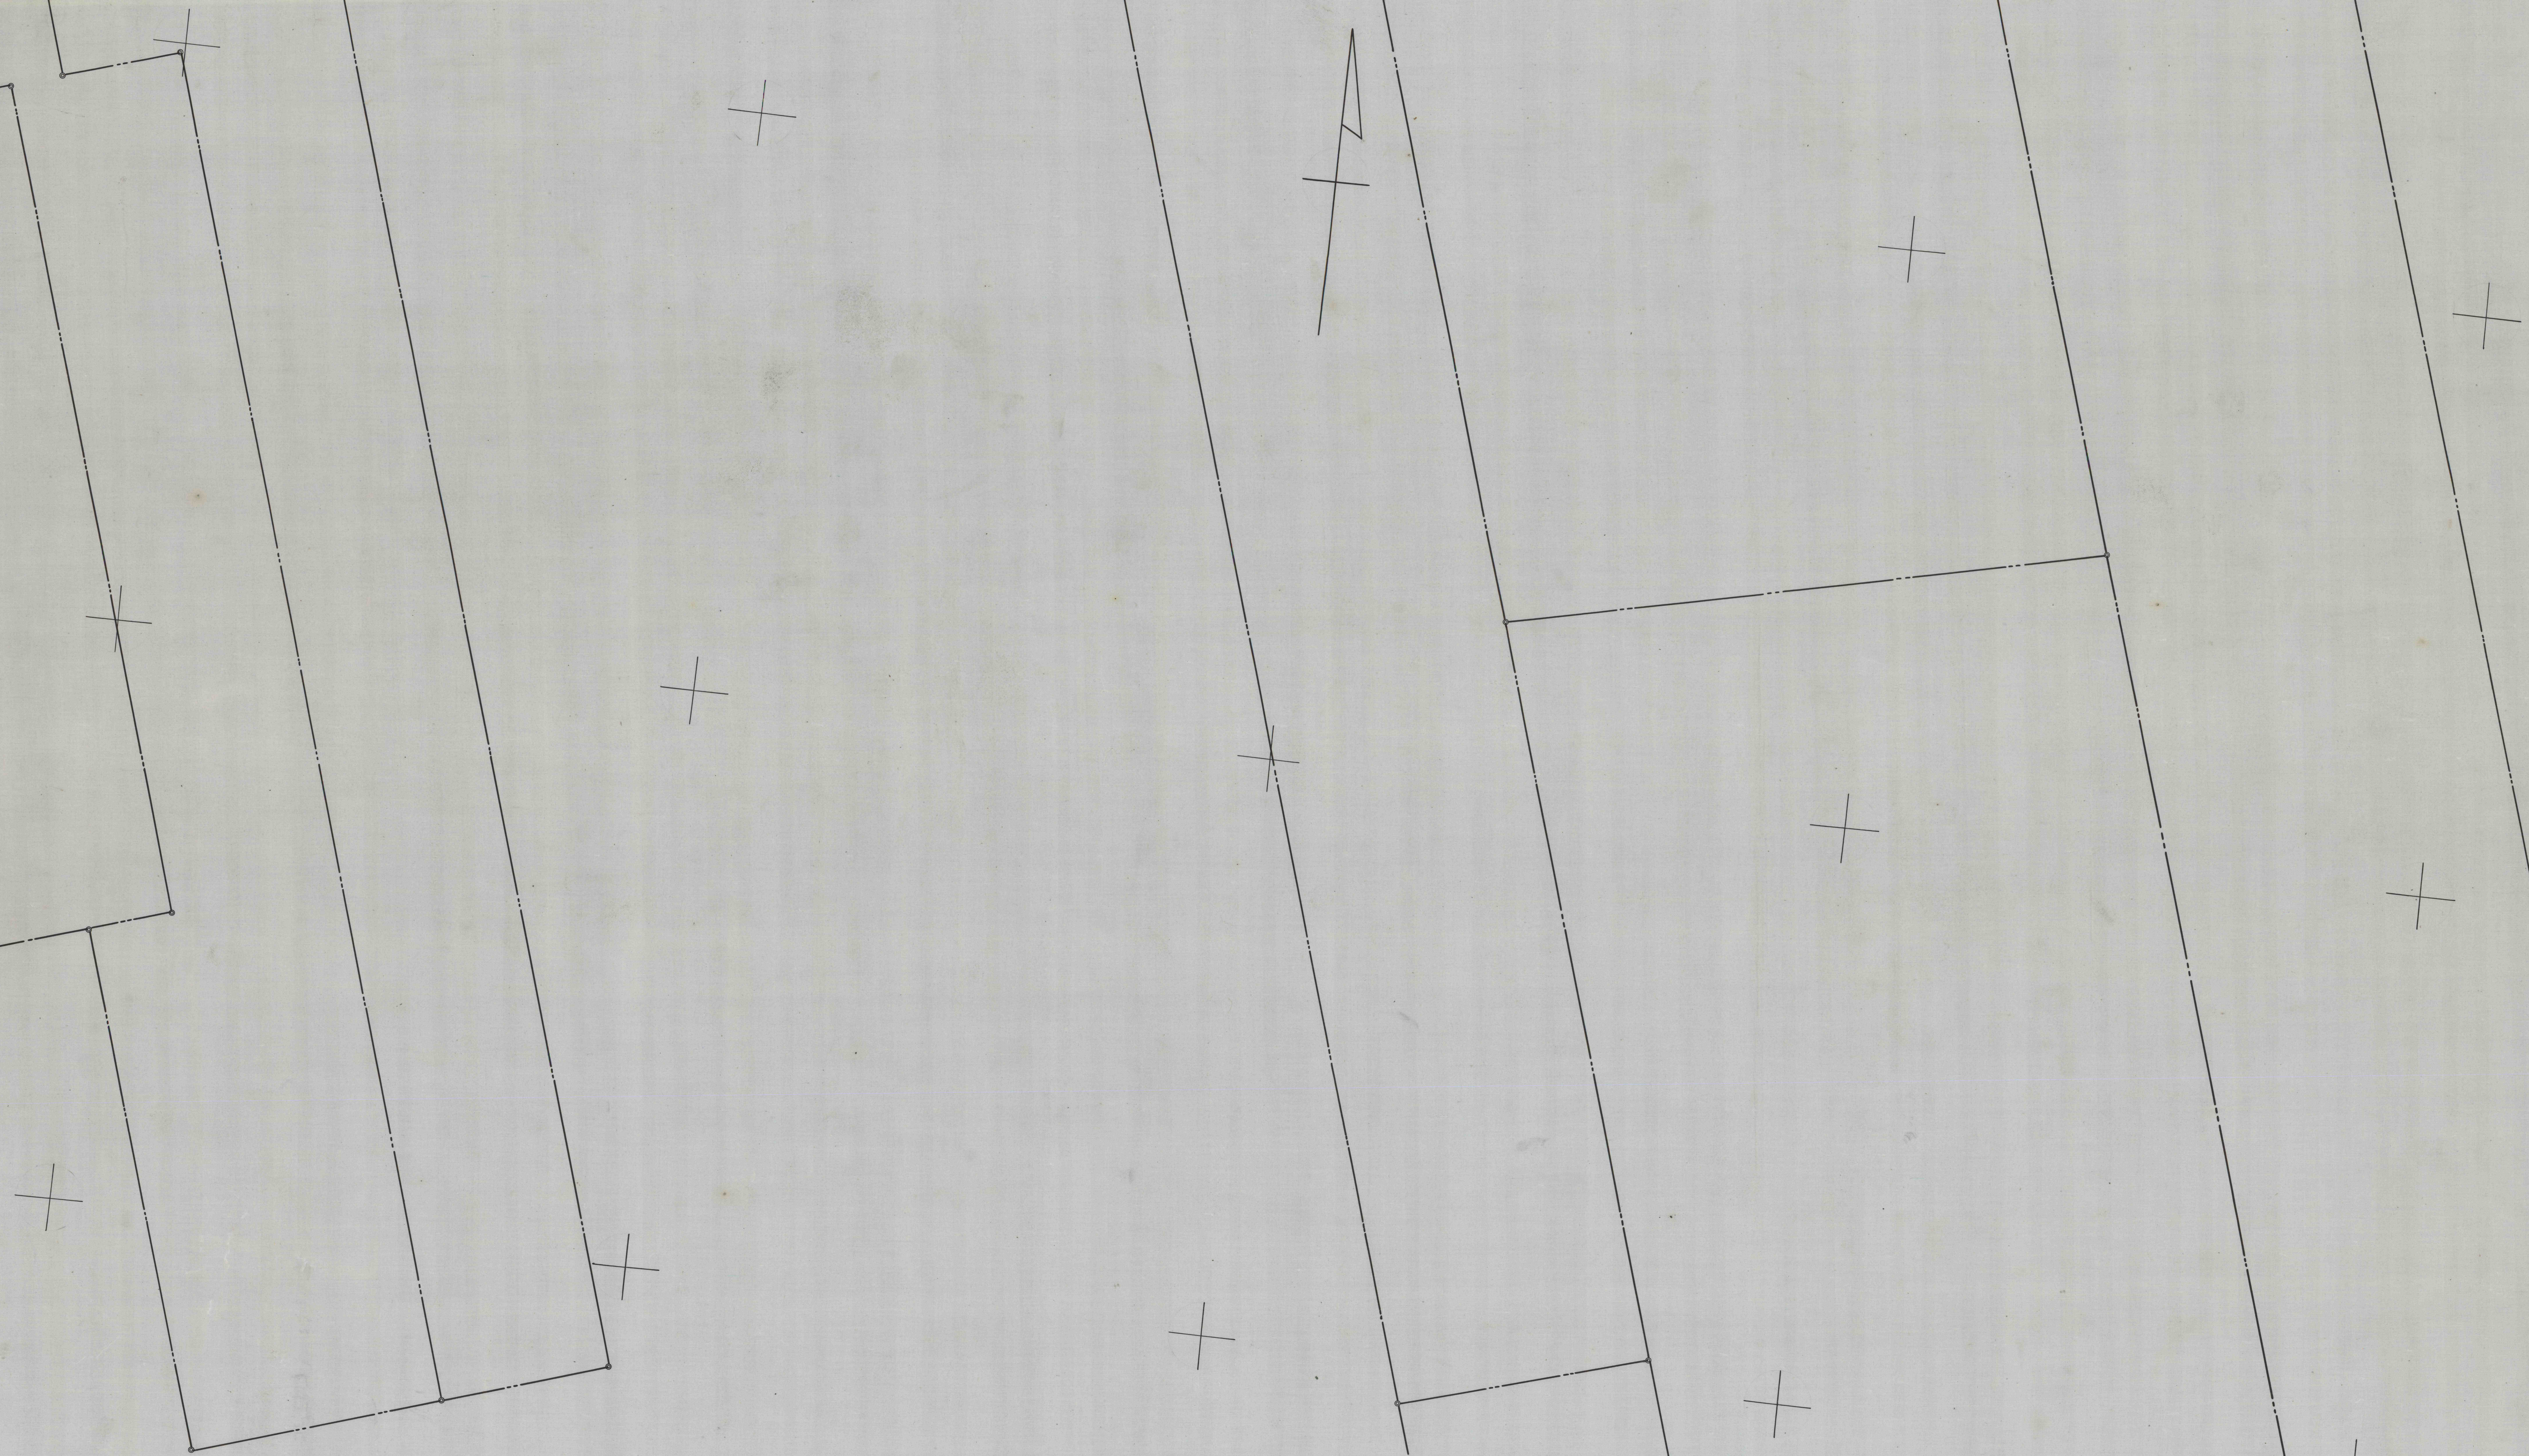


FITTING LINE 14-10

FITTING LINE 14-10

VEIN GEORGE BLISS

BLISS GEORGE VEIN
M-8, 1A

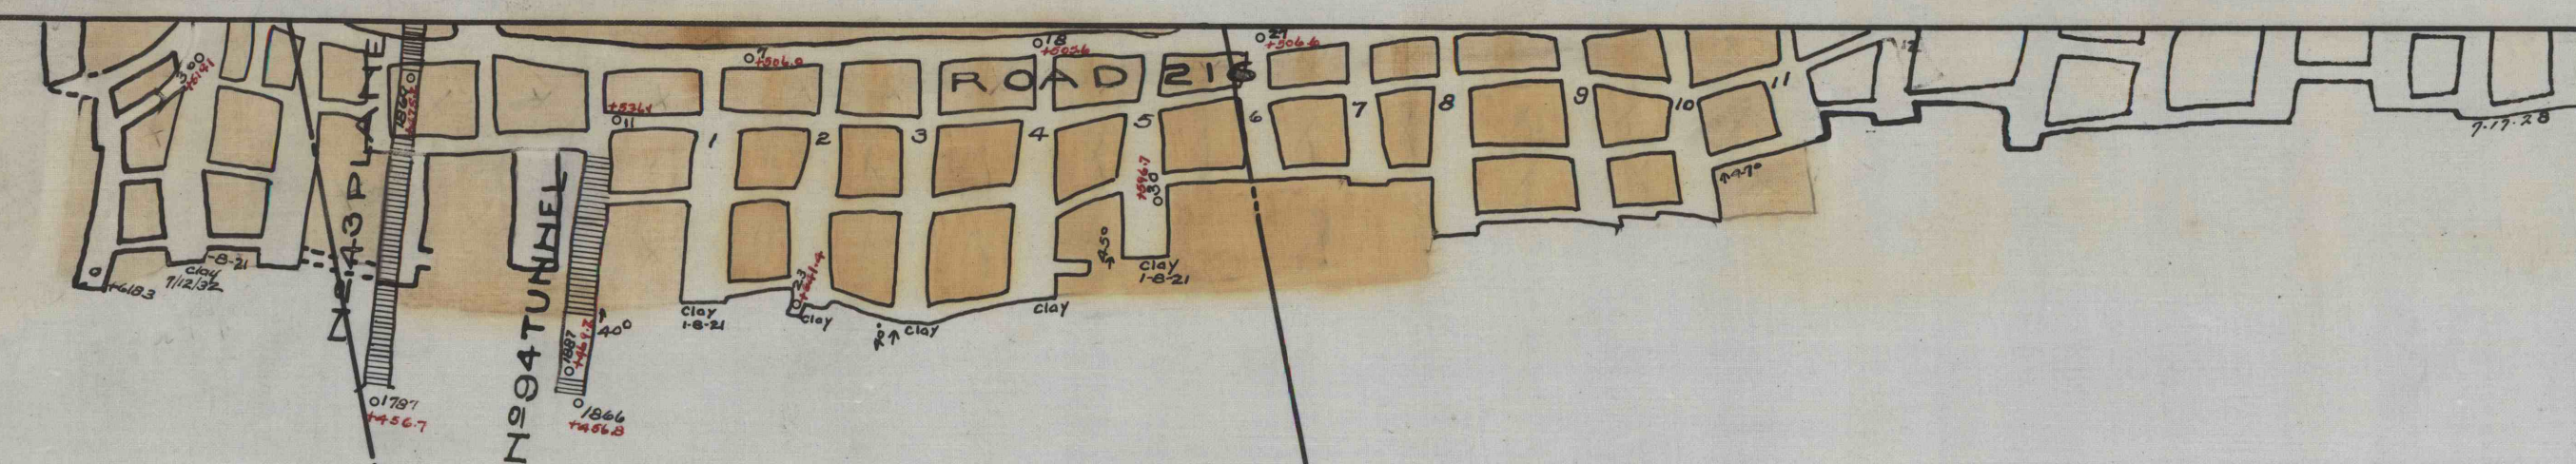

MF
SEP 21 1973

MF
SEP 21 1973