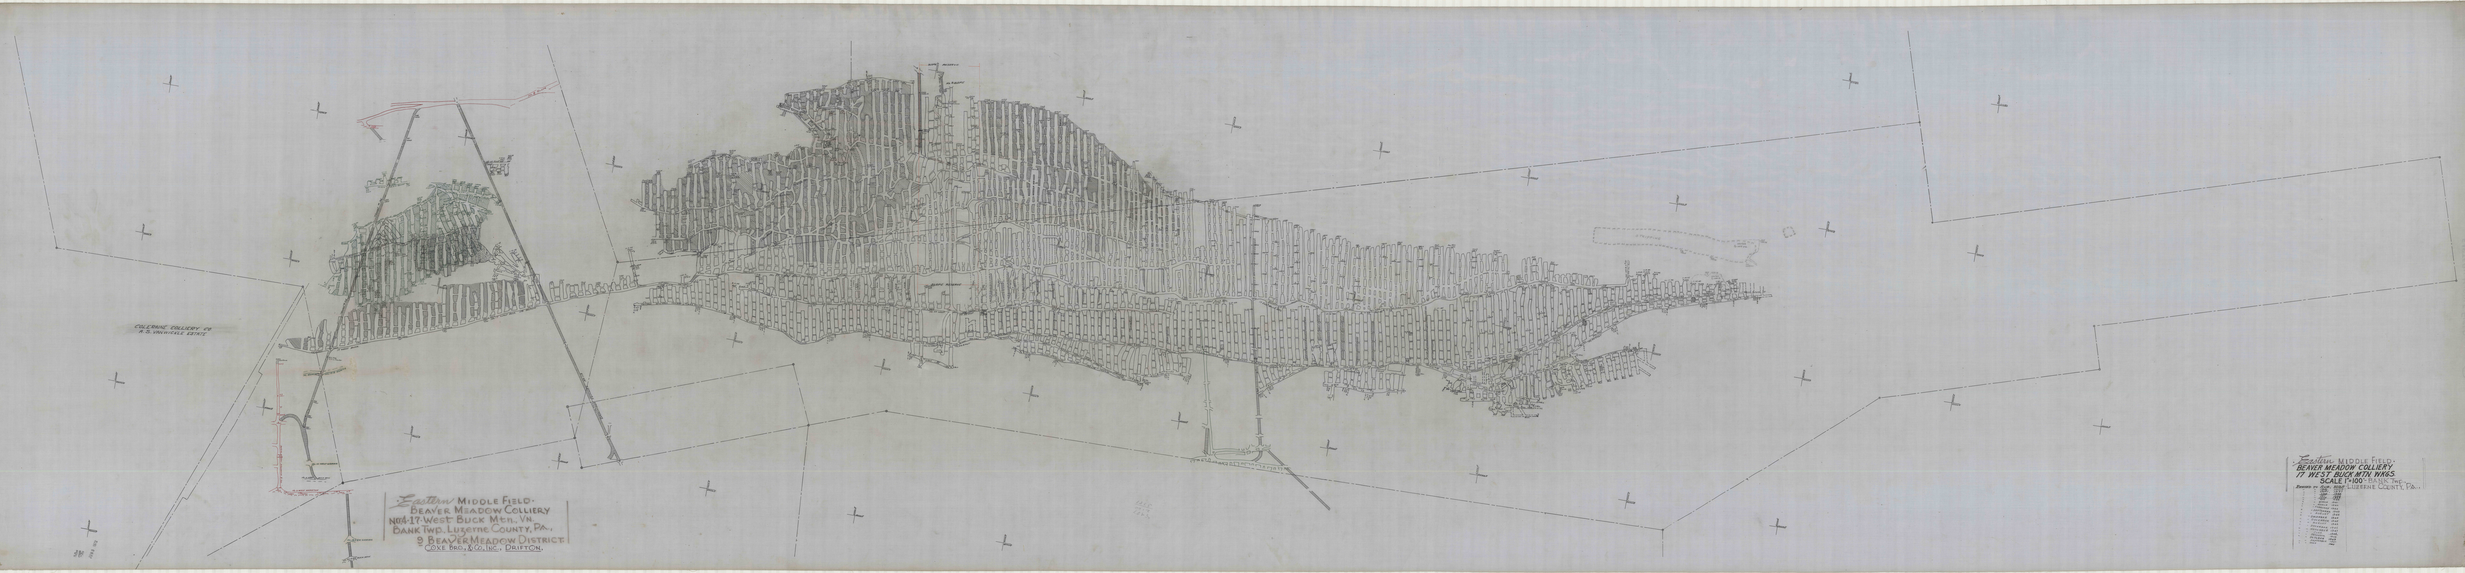

Eastern Middle Field
Beaver Meadow Colliery
No6-17 West Buck Mtn.
Bank Twp. Luzerne County, Pa.
& Beaver Meadow District
Coxe Bros. & Co. Inc. Drifton.
Eastern Middle Field
Beaver Meadow Colliery
17 West Buck Mtn Mines
Scale 1"=100'
Luzerne County, Pa.