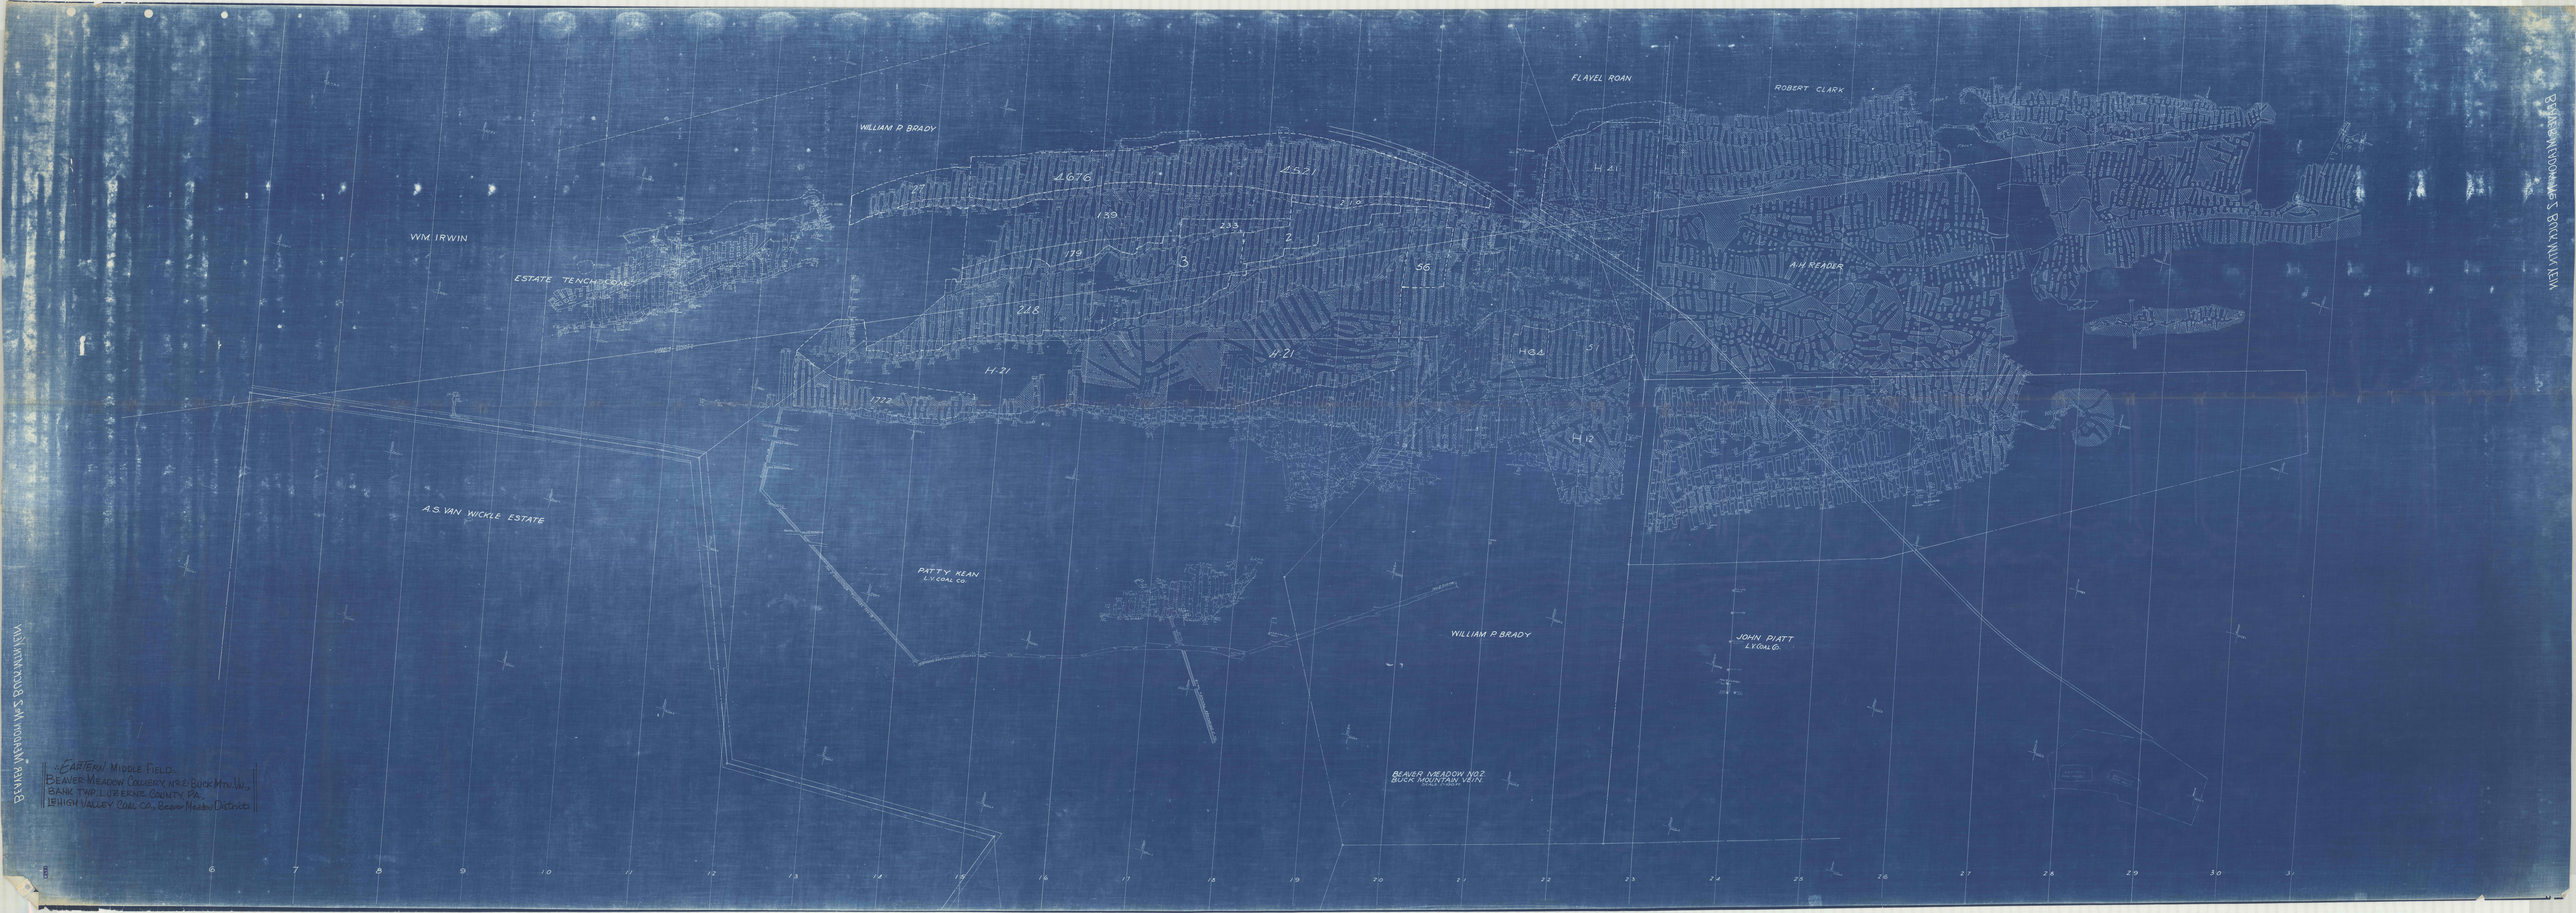

WILLIAM P. BRADY
FLAVEL ROAN
ROBERT CLARK
WM. IRWIN
ESTATE TENCH COAL
A.S. VAN WICKLE ESTATE
PATTY KEAN
L.V. COAL CO.
WILLIAM P. BRADY
JOHN PIATT
L.V. COAL CO.
A.H. READER
BEAVER MEADOW NO2
BUCK MOUNTAIN VEIN
4676
4521
139
233
218
56
H-21
H-41
H-12
1772
EASTERN MIDDLE FIELD
BEAVER MEADOW COLLIERY N.W.& BUCK MTN. VEINS
BANK TWP. LUZERNE COUNTY PA.
LEHIGH VALLEY COAL CO., Beaver Meadow Districts