


(30)

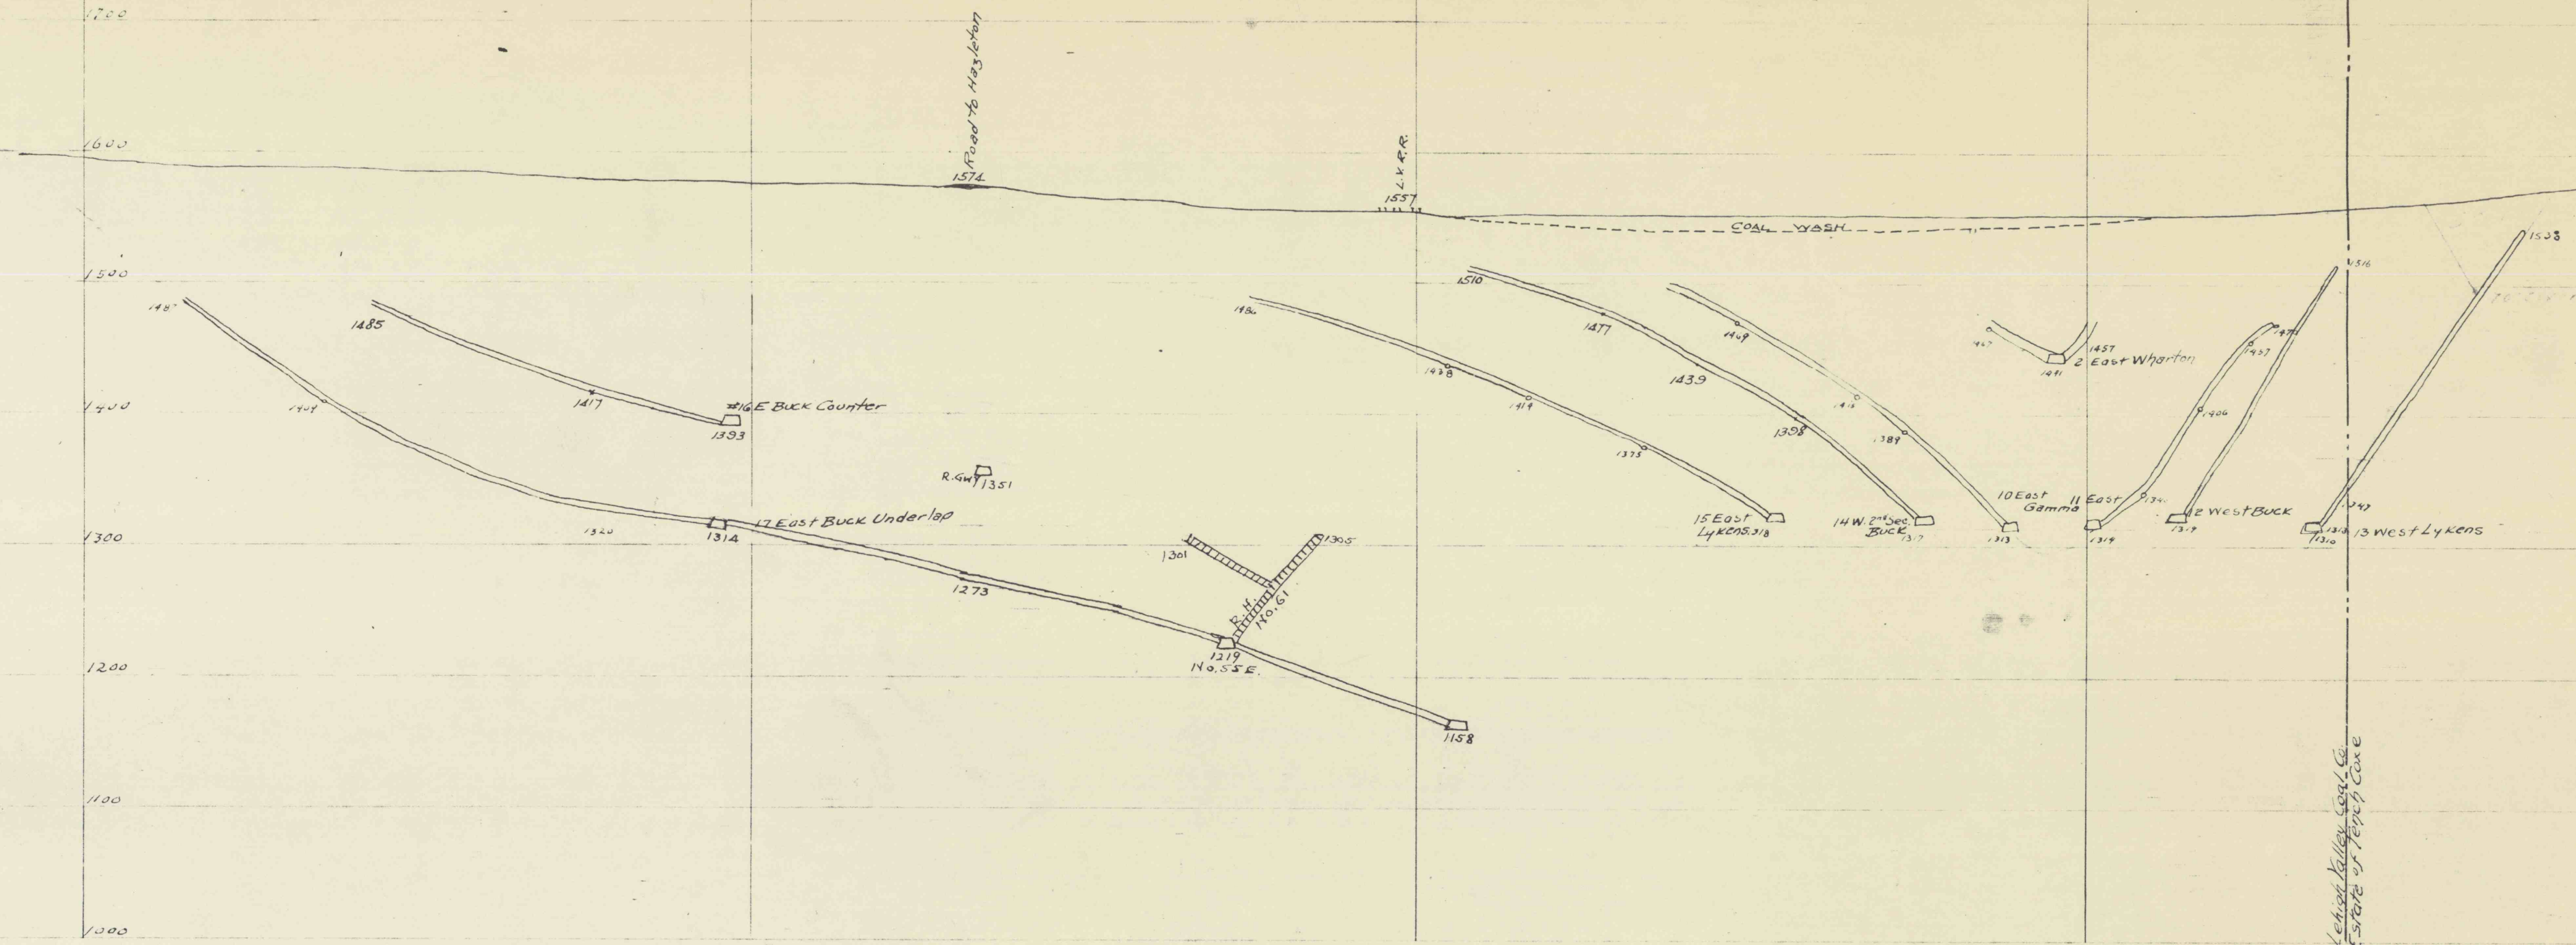

(2)

BM
4-1