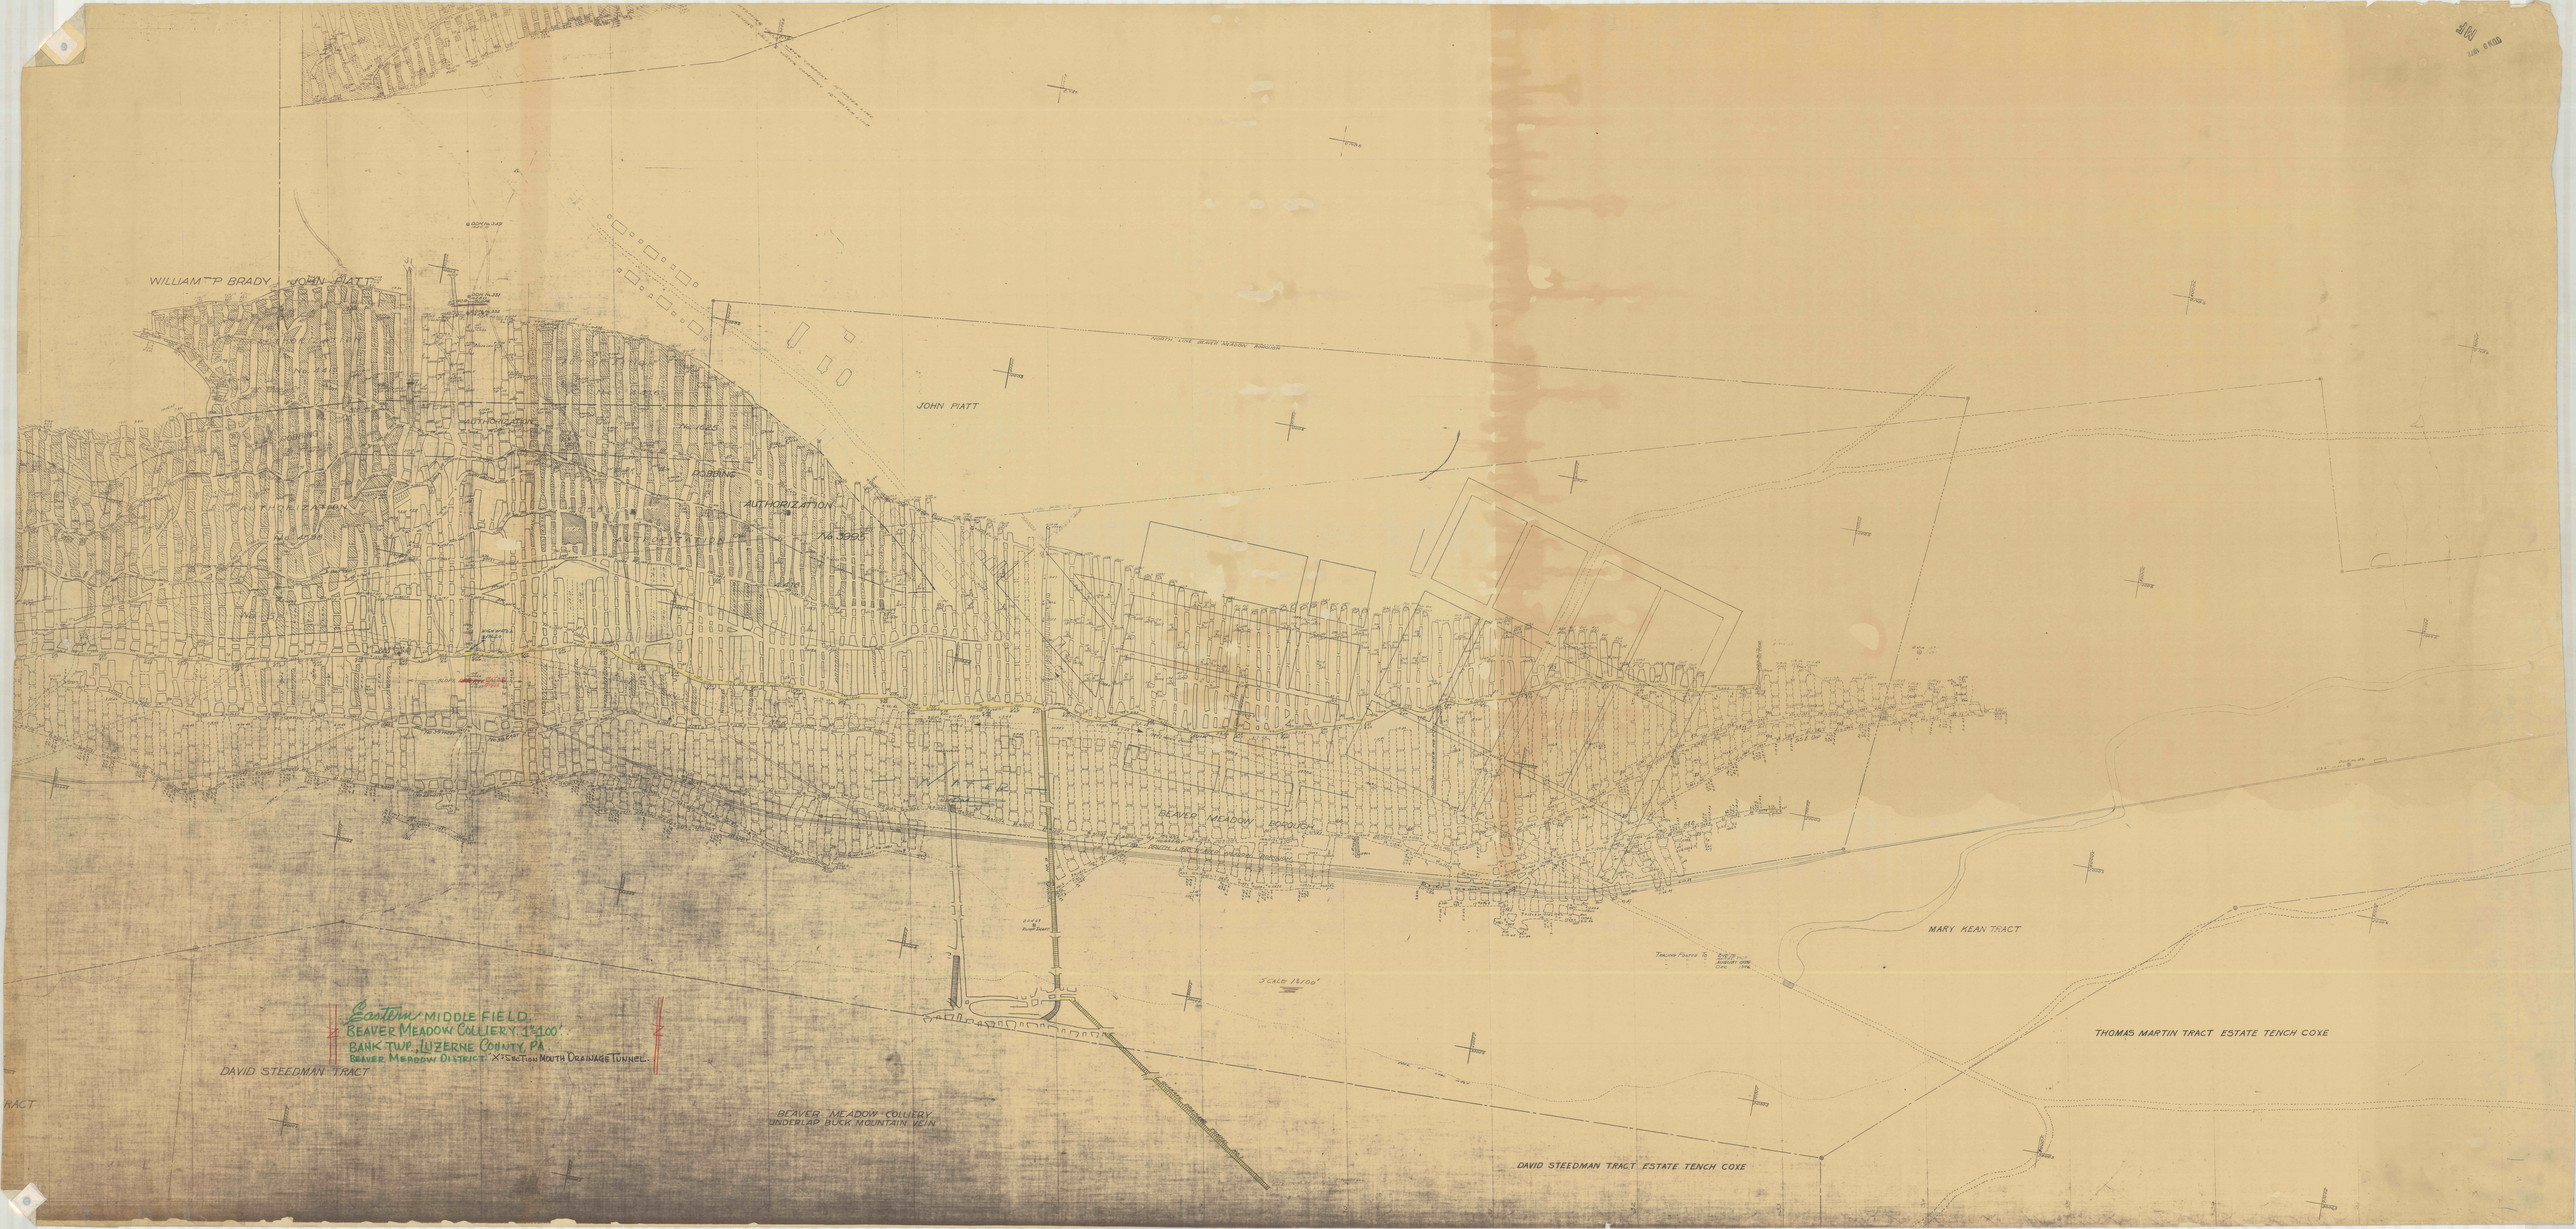
WILLIAM P BRADY
JOHN PIATT
JOHN PIATT
AUTHORIZATION
No. 3925
BEAVER MEADOW BOROUGH
MARY KEAN TRACT
THOMAS MARTIN TRACT ESTATE TENCH COXE
DAVID STEEDMAN TRACT ESTATE TENCH COXE
DAVID STEEDMAN TRACT
BEAVER MEADOW COLLIERY
UNDERLAP BUCK MOUNTAIN VEIN
Scale 1:100'
Eastern MIDDLE FIELD.
BEAVER MEADOW COLLIERY. 1"=100'.
BANK TWP., LUZERNE COUNTY, PA.
BEAVER MEADOW DISTRICT. X-SECTION MOUTH DRAINAGE TUNNEL.