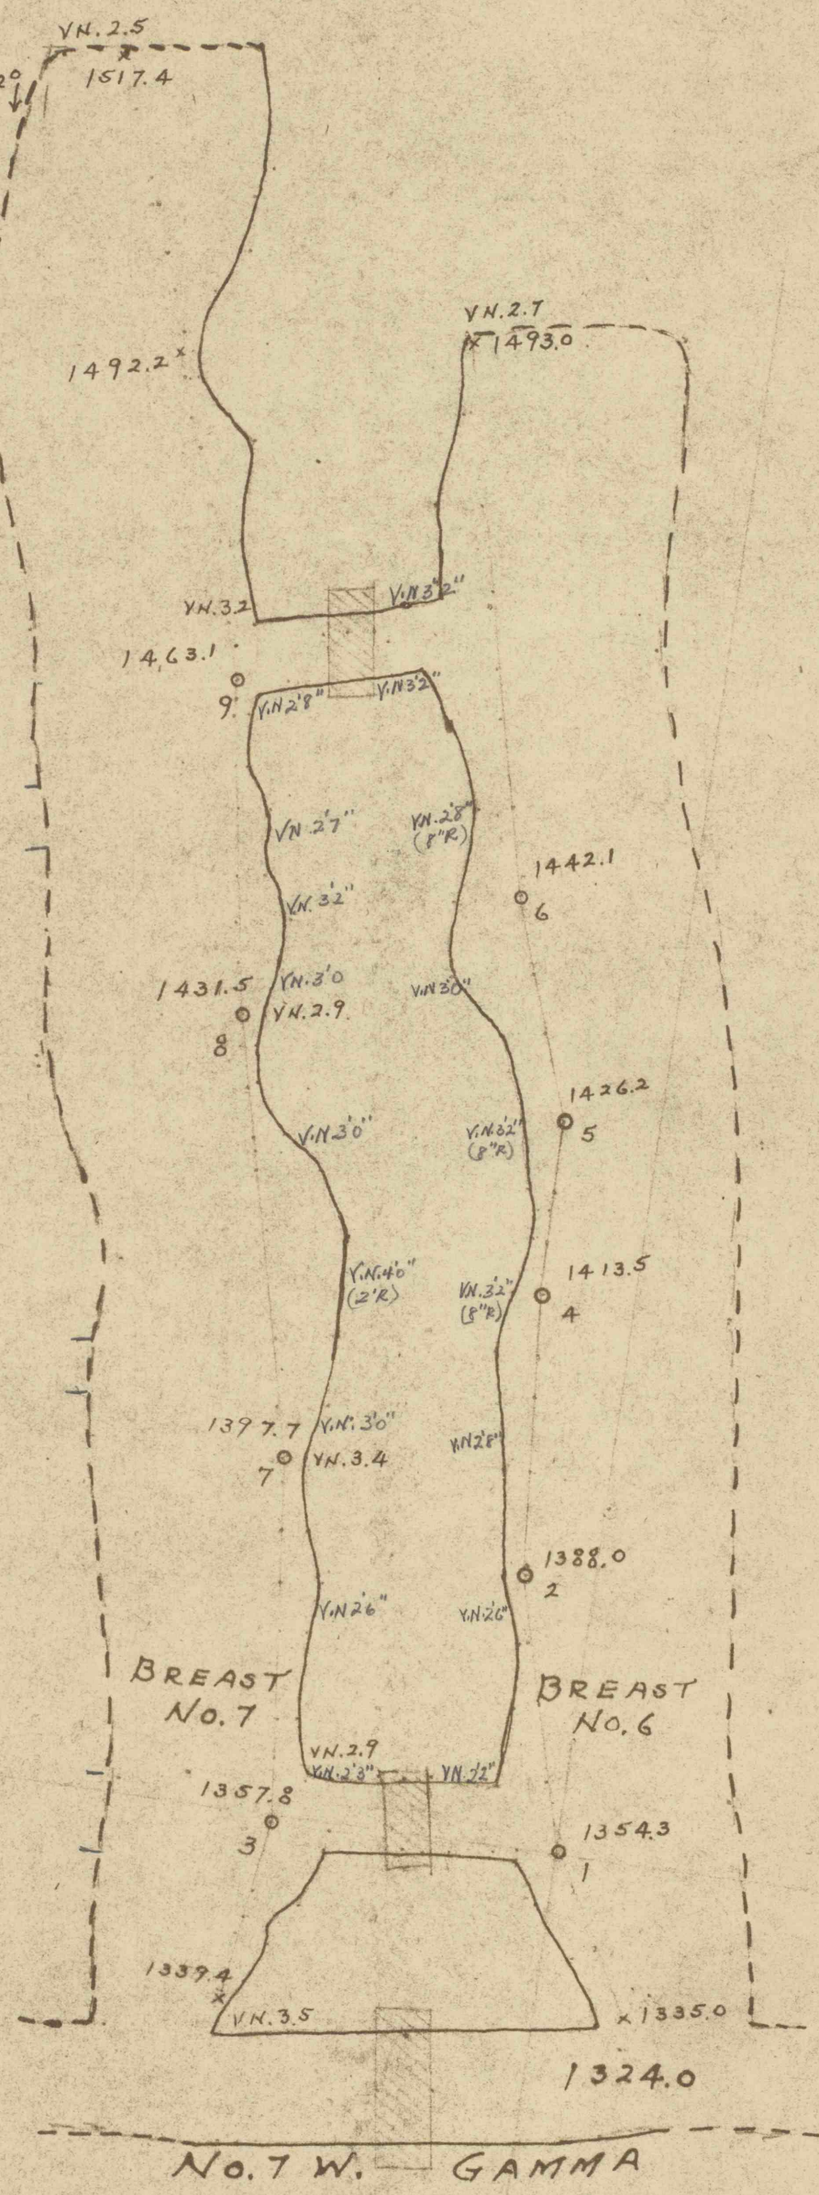

EASTERN MIDDLE FIELD

BEAVER MEADOW COLLIERY

BANK Twp., LUZERNE COUNTY, PA.,

NO. 7 WEST GAMMA PILLAR NO. 6½ FOR PROPOSED

BRICK DAMS. SCALE: 1" = 20'. OCTOBER 7 - 1947

9. BEAVER MEADOW DISTRICT.

SHEET: 3 OF 3.