


BEAVER MEADOW #2 COLLIERIES
STATE VILLAGE INSPECTOR

MF
JUN 9 1972

4
C

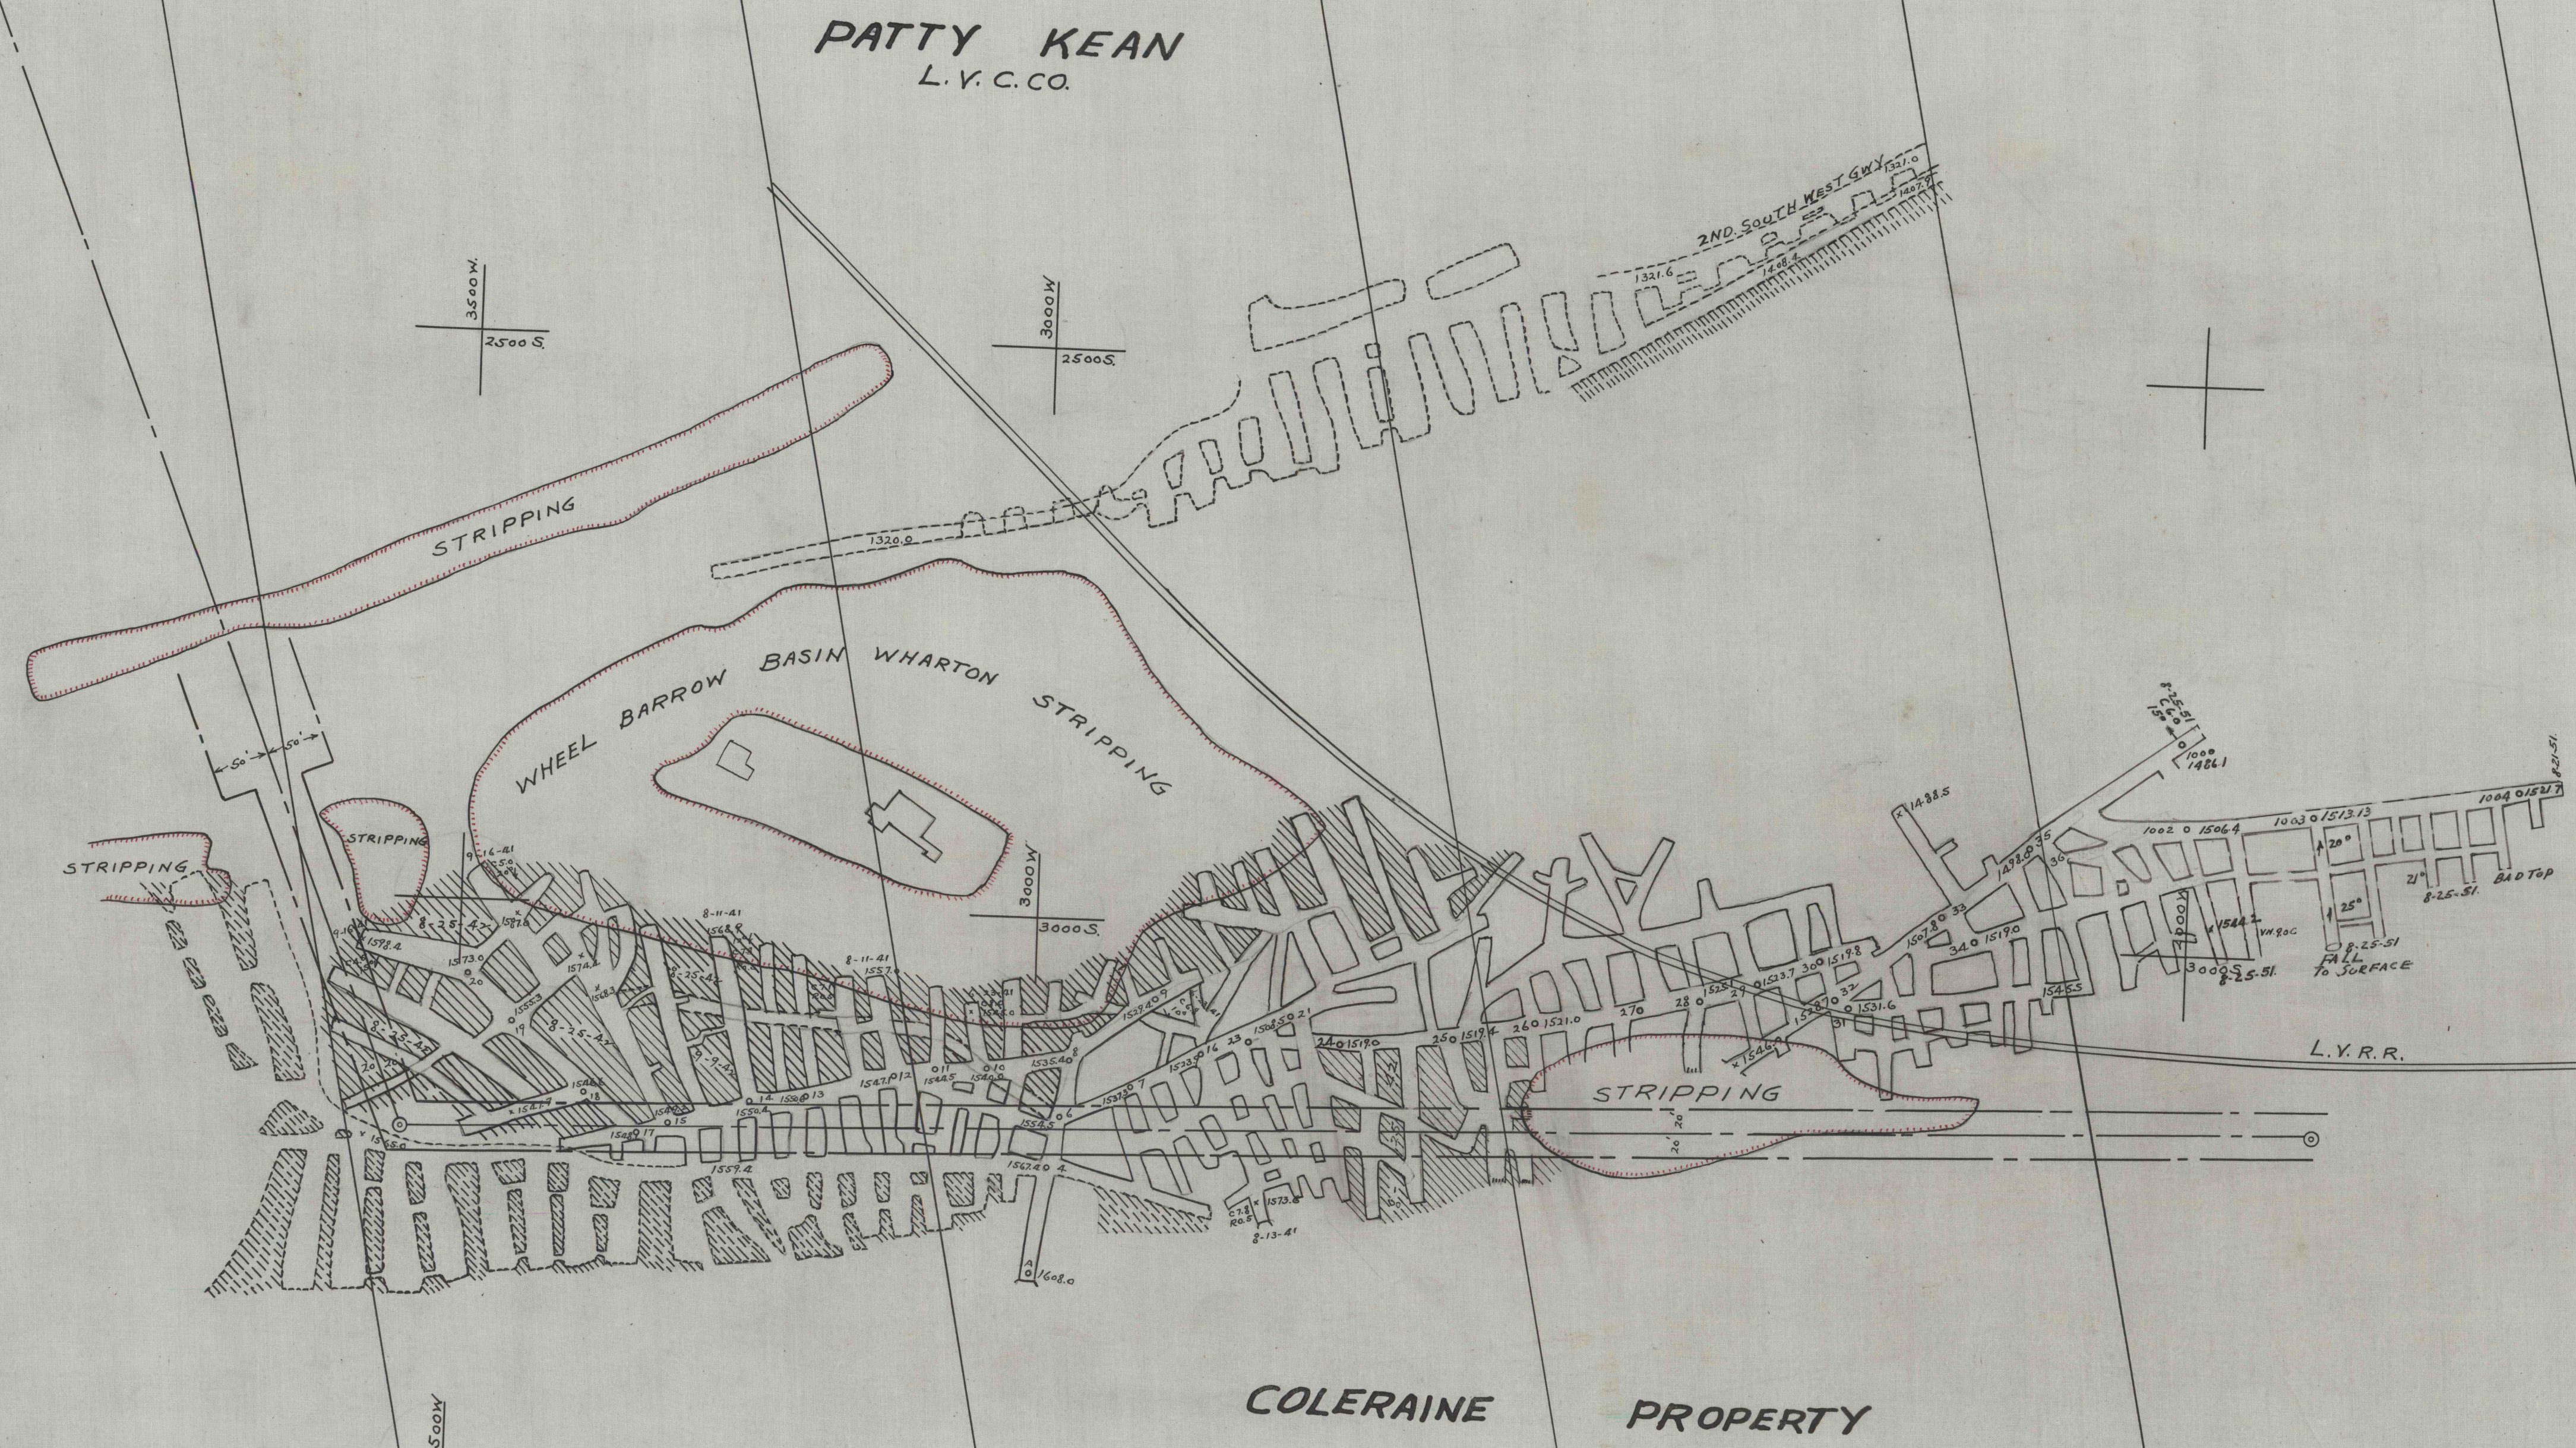

Eastern Middle Field:
BEAVER MEADOW #2 Colliery.
Wharton Vn. 1-100. BANK Twp.,
LUZERNE COUNTY, PA, DRIFTON.

- REVISED TO MARCH 1942
- " FEBRUARY 1943
 - " SEPTEMBER 1943
 - " AUGUST 1944
 - " DECEMBER 1944
 - " DECEMBER 1945
 - " AUGUST 1946
 - " DECEMBER 1946
 - " NOVEMBER 1947
 - " JUNE 1948
 - " DECEMBER 1948
 - " OCTOBER 1949
 - " AUGUST 1951.