
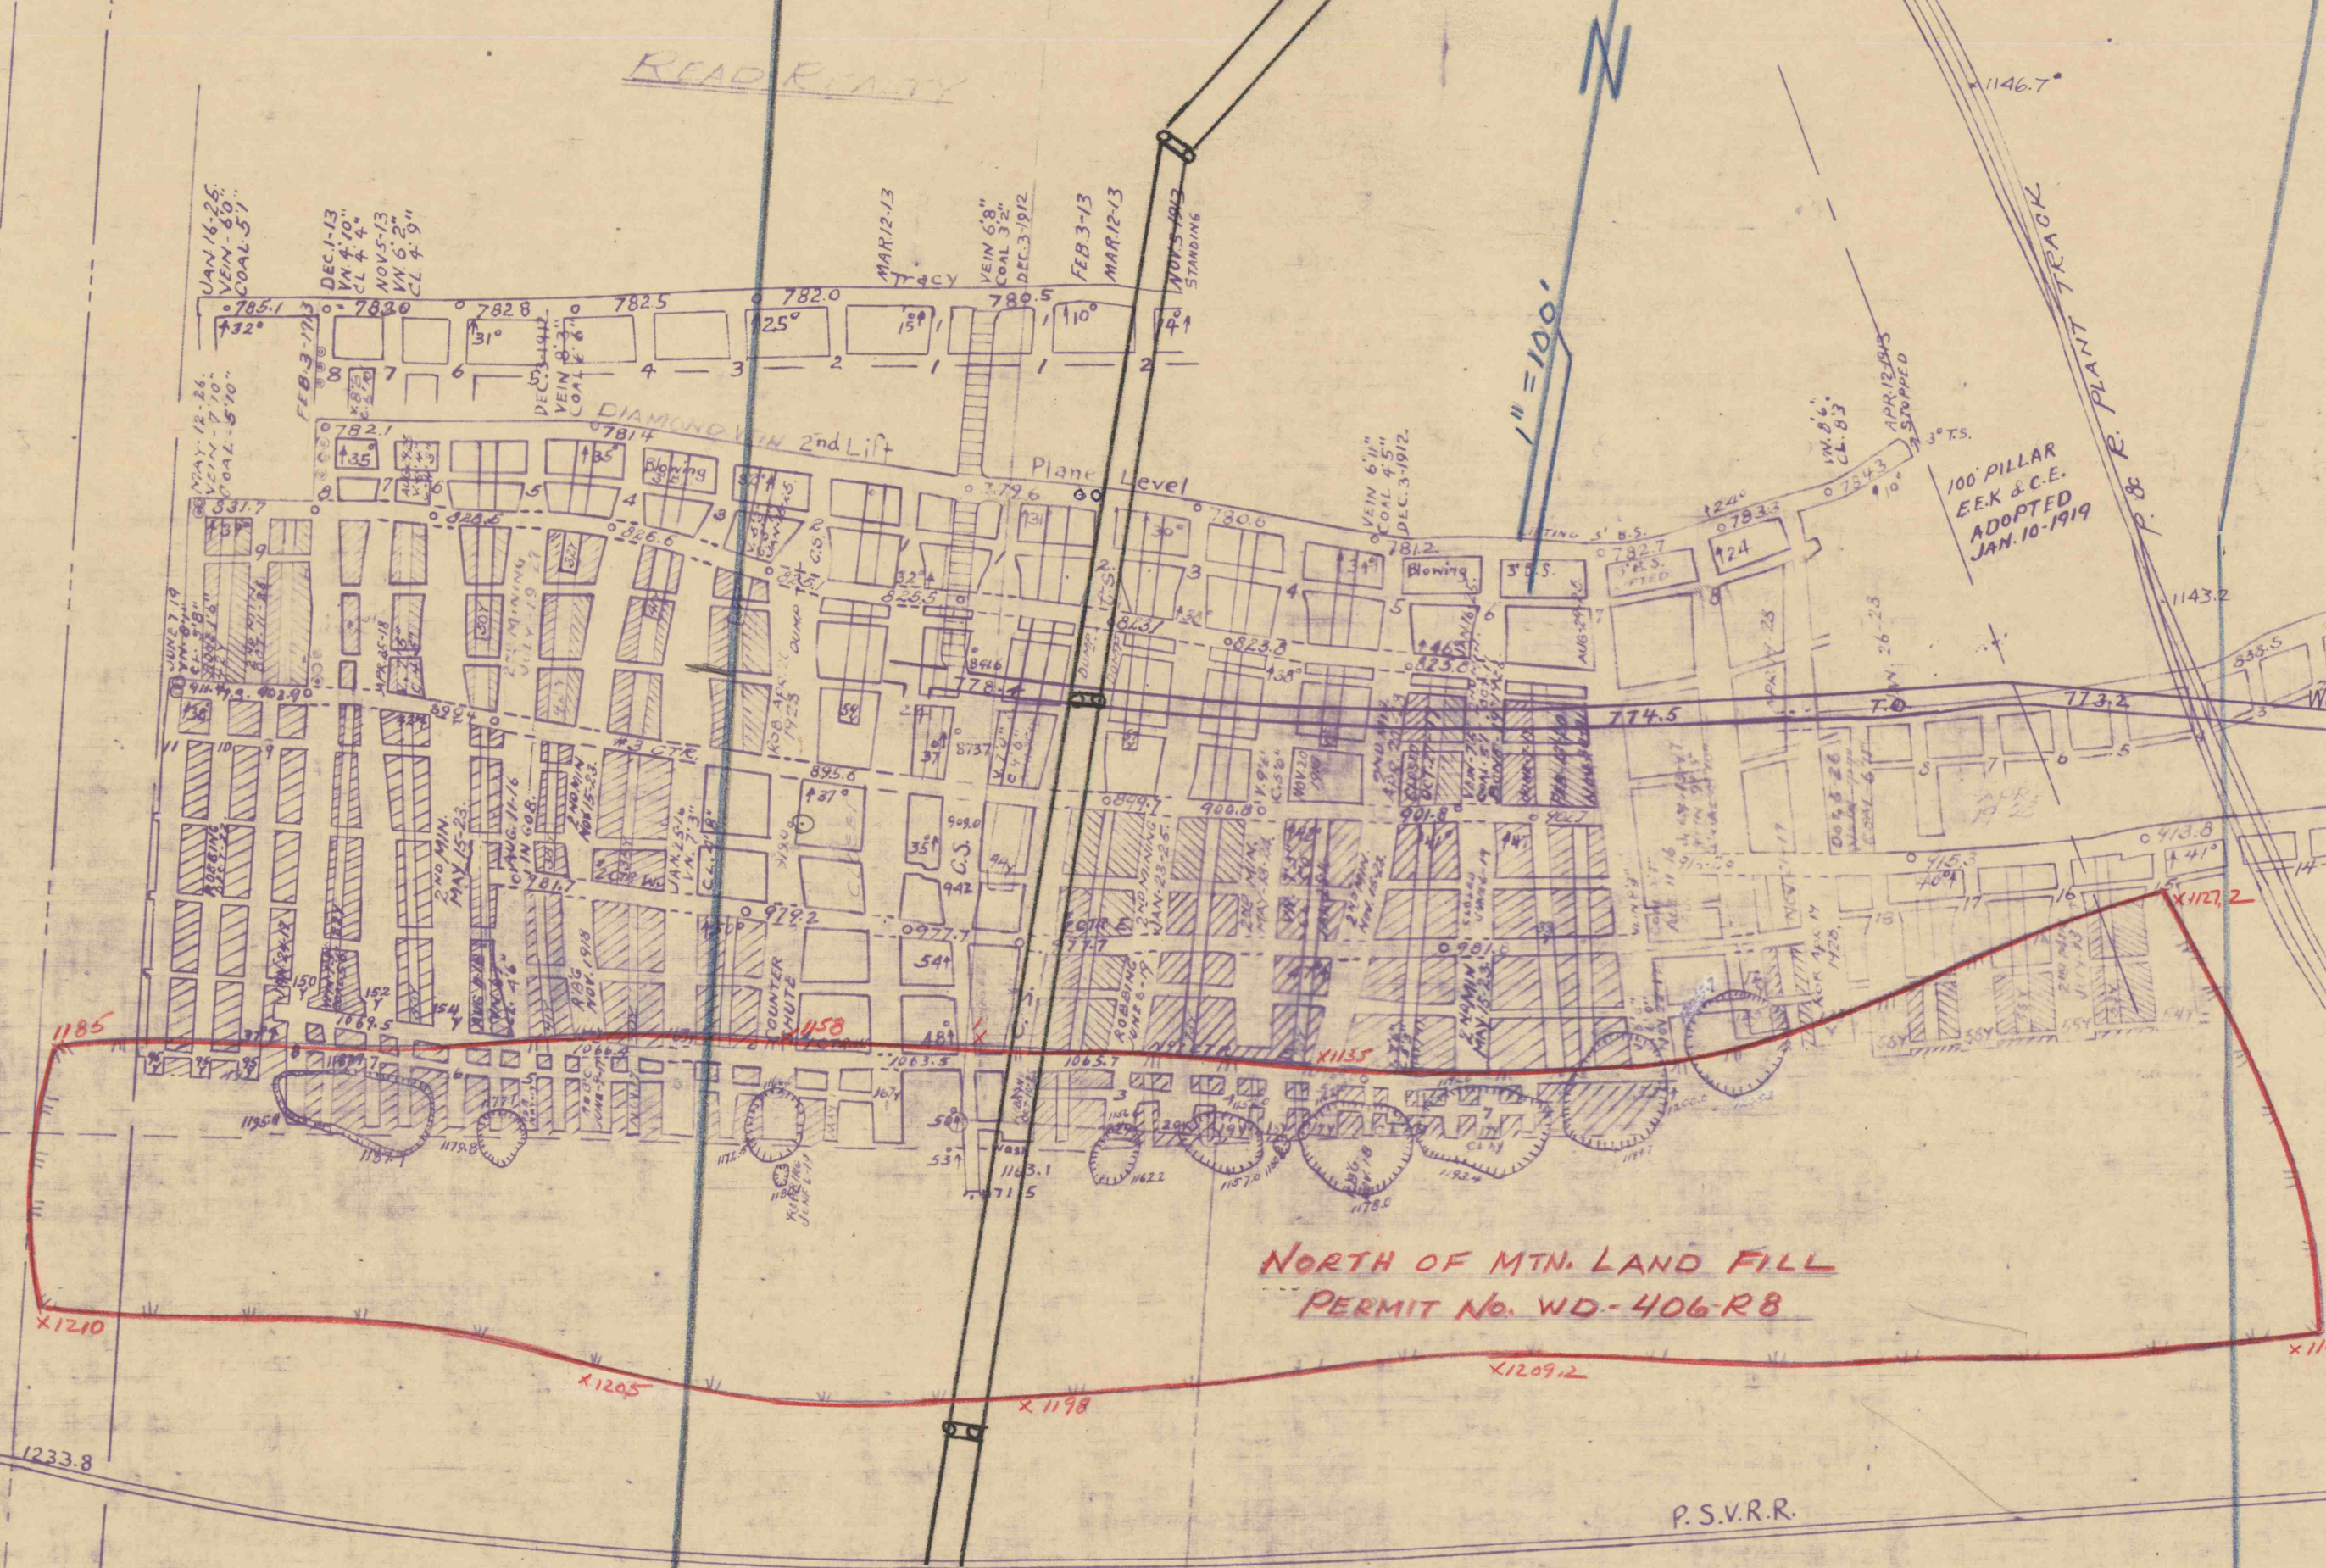


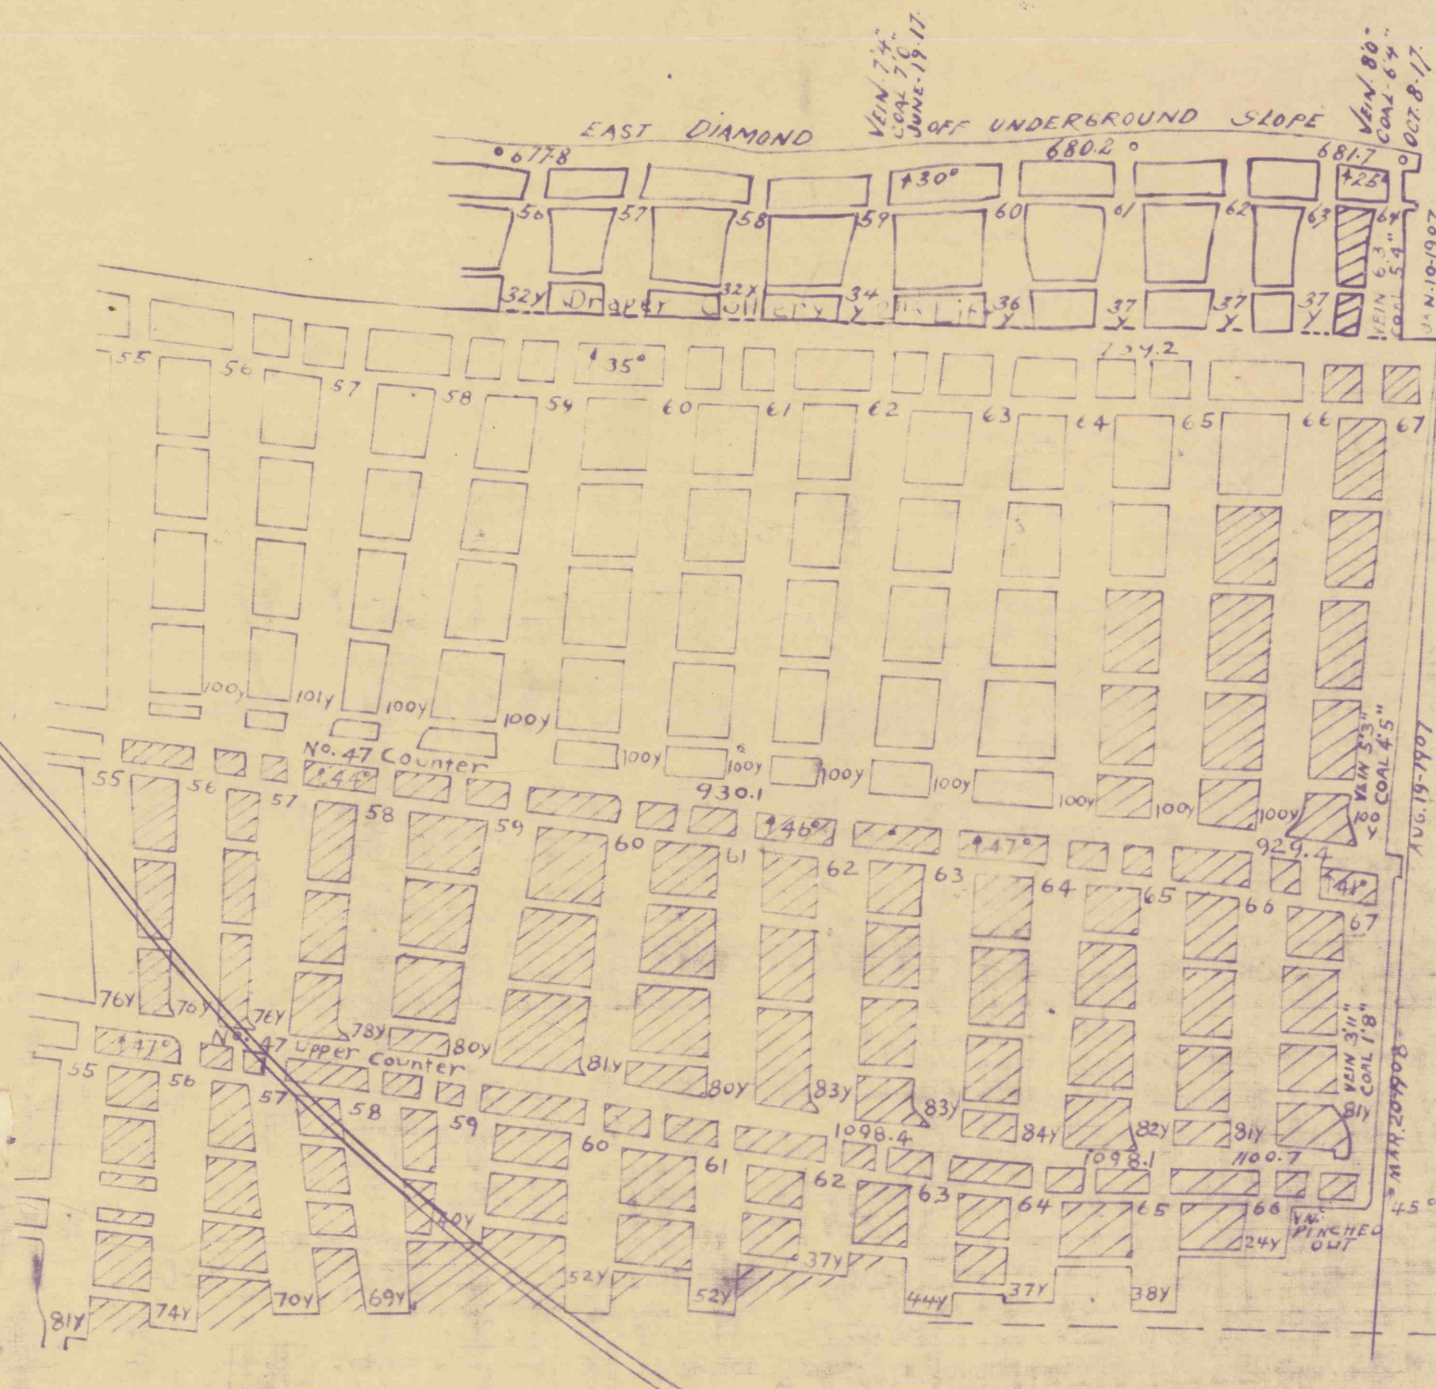

Western Middle Field.
BOSTON RUN COLLIERY
WEST DIAMOND VEIN NO. 11 W. MAHANoy
MAHANoy TWP. DISTRICT # 240.
Mahanoy City, Pa. Feb. 1917. Scale 1"=100' J. Van Buren Division Engineer.

.. 2- of 4..PRINT.

#294
MAR 18 1918
RECEIVED