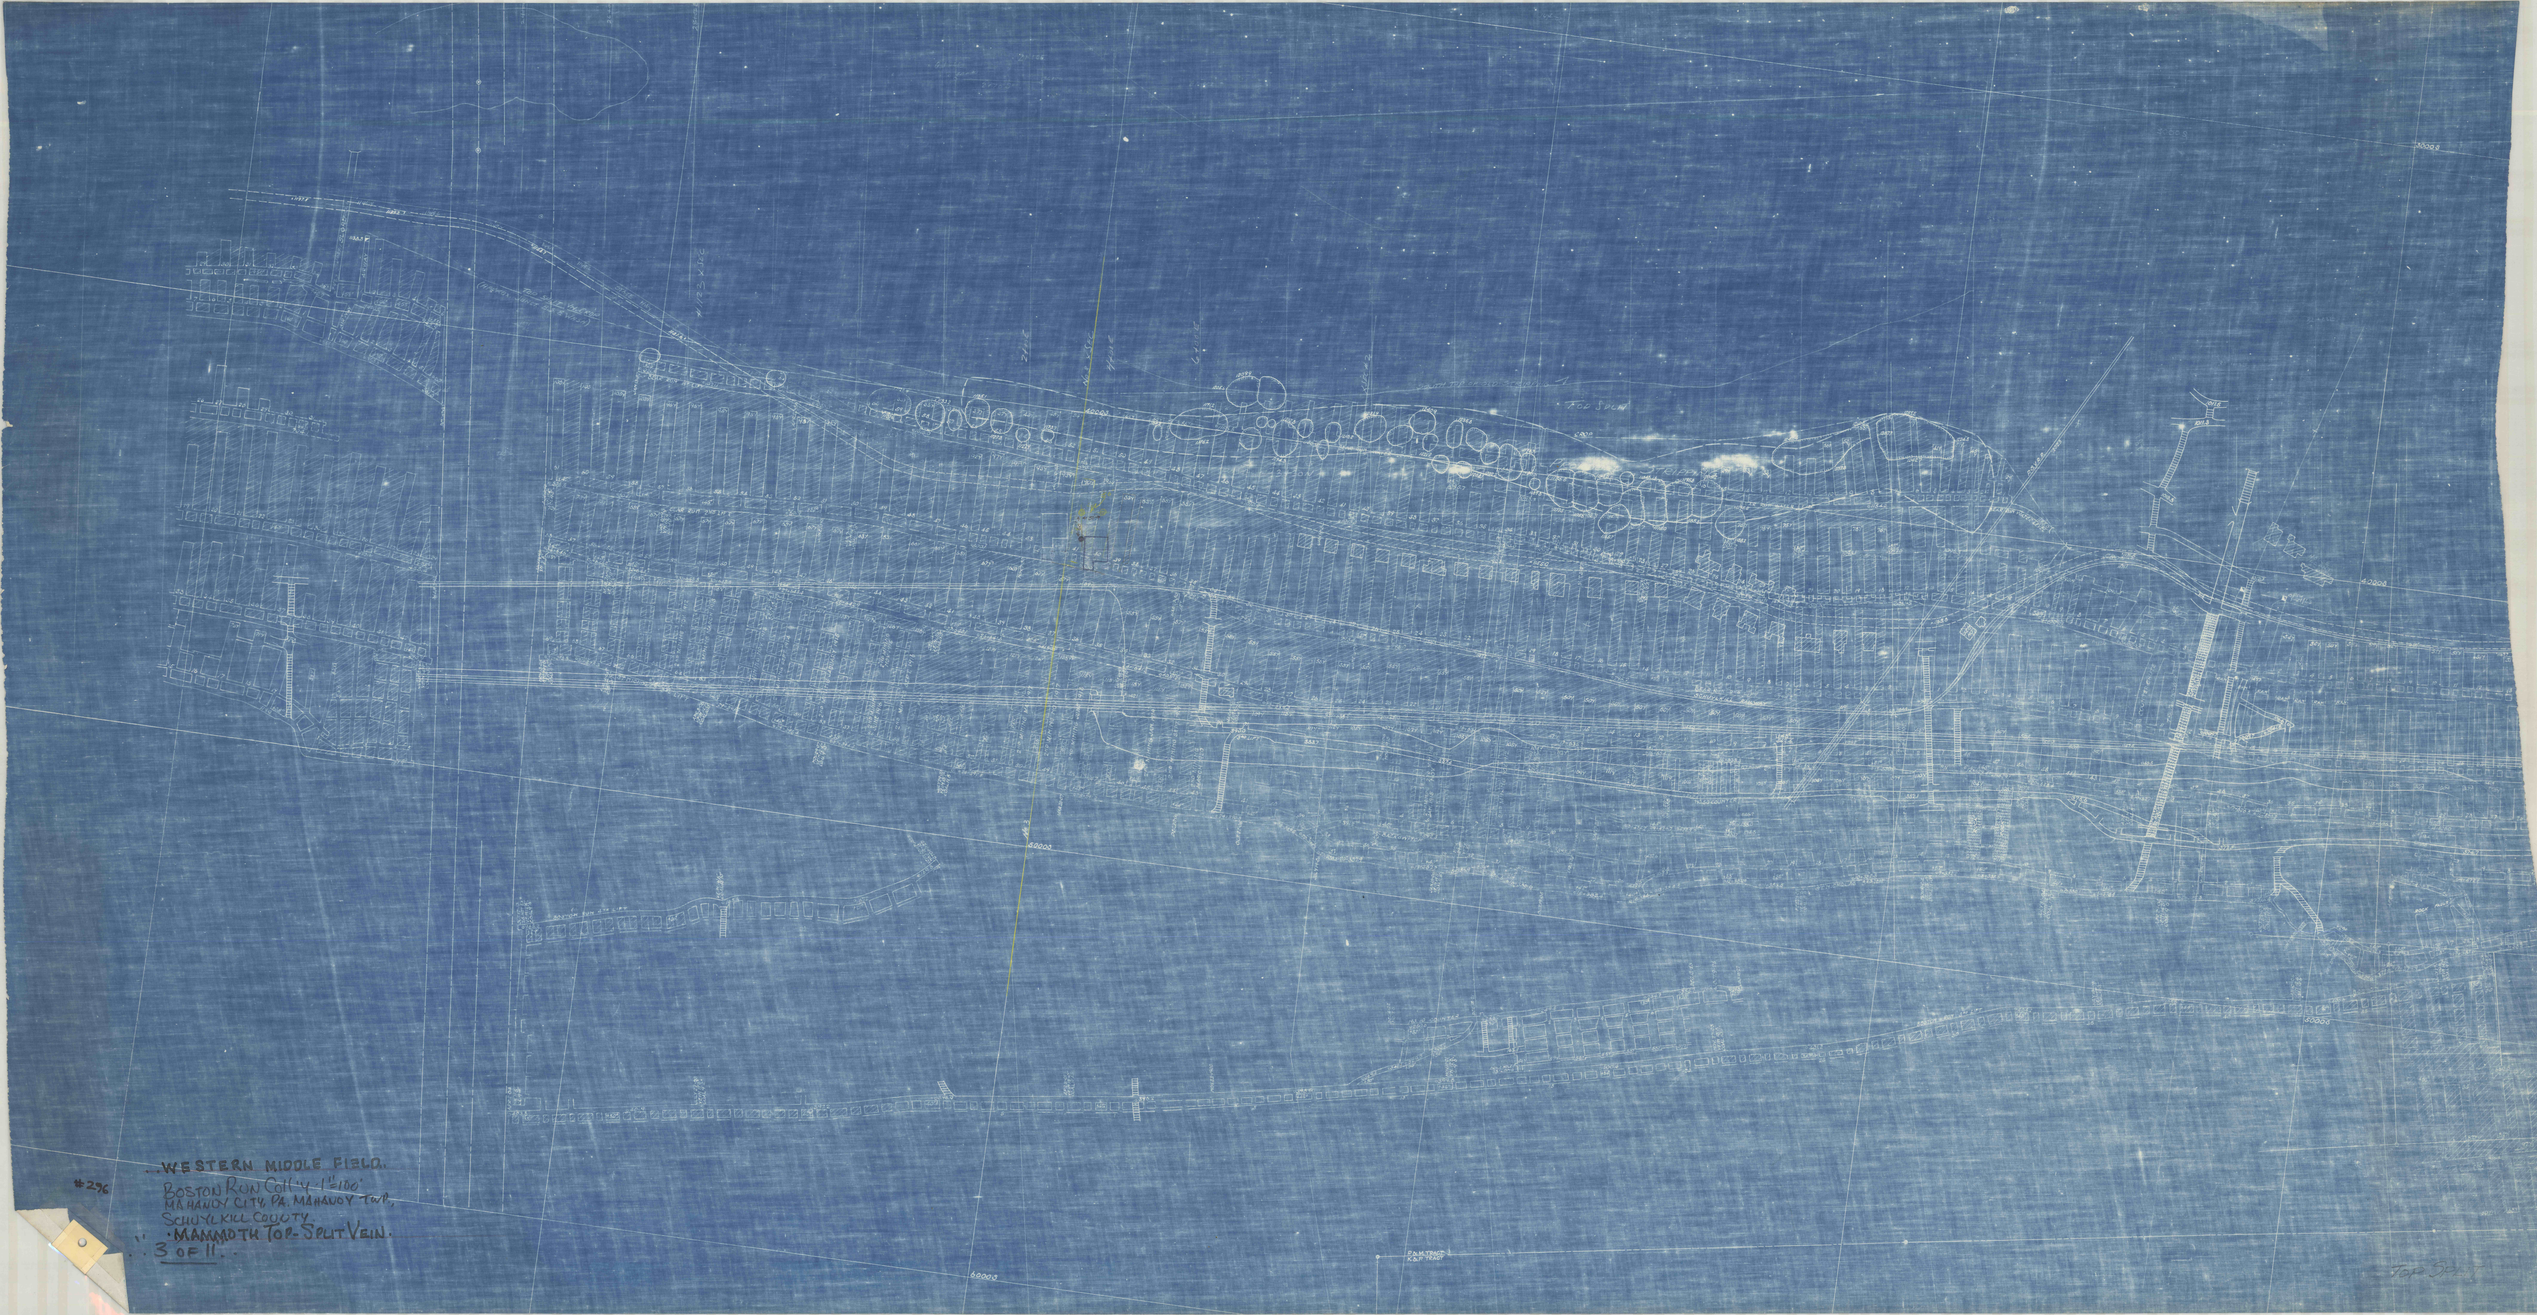


WESTERN MIDDLE FIELD.
BOSTON RUN COAL CO. 1" = 100'
MAHANOY CITY, PA. MAHANOY TWP.
SCHUYLKILL COUNTY
MAMMOTH TOP SPLIT VEIN.
3 OF 11

#296