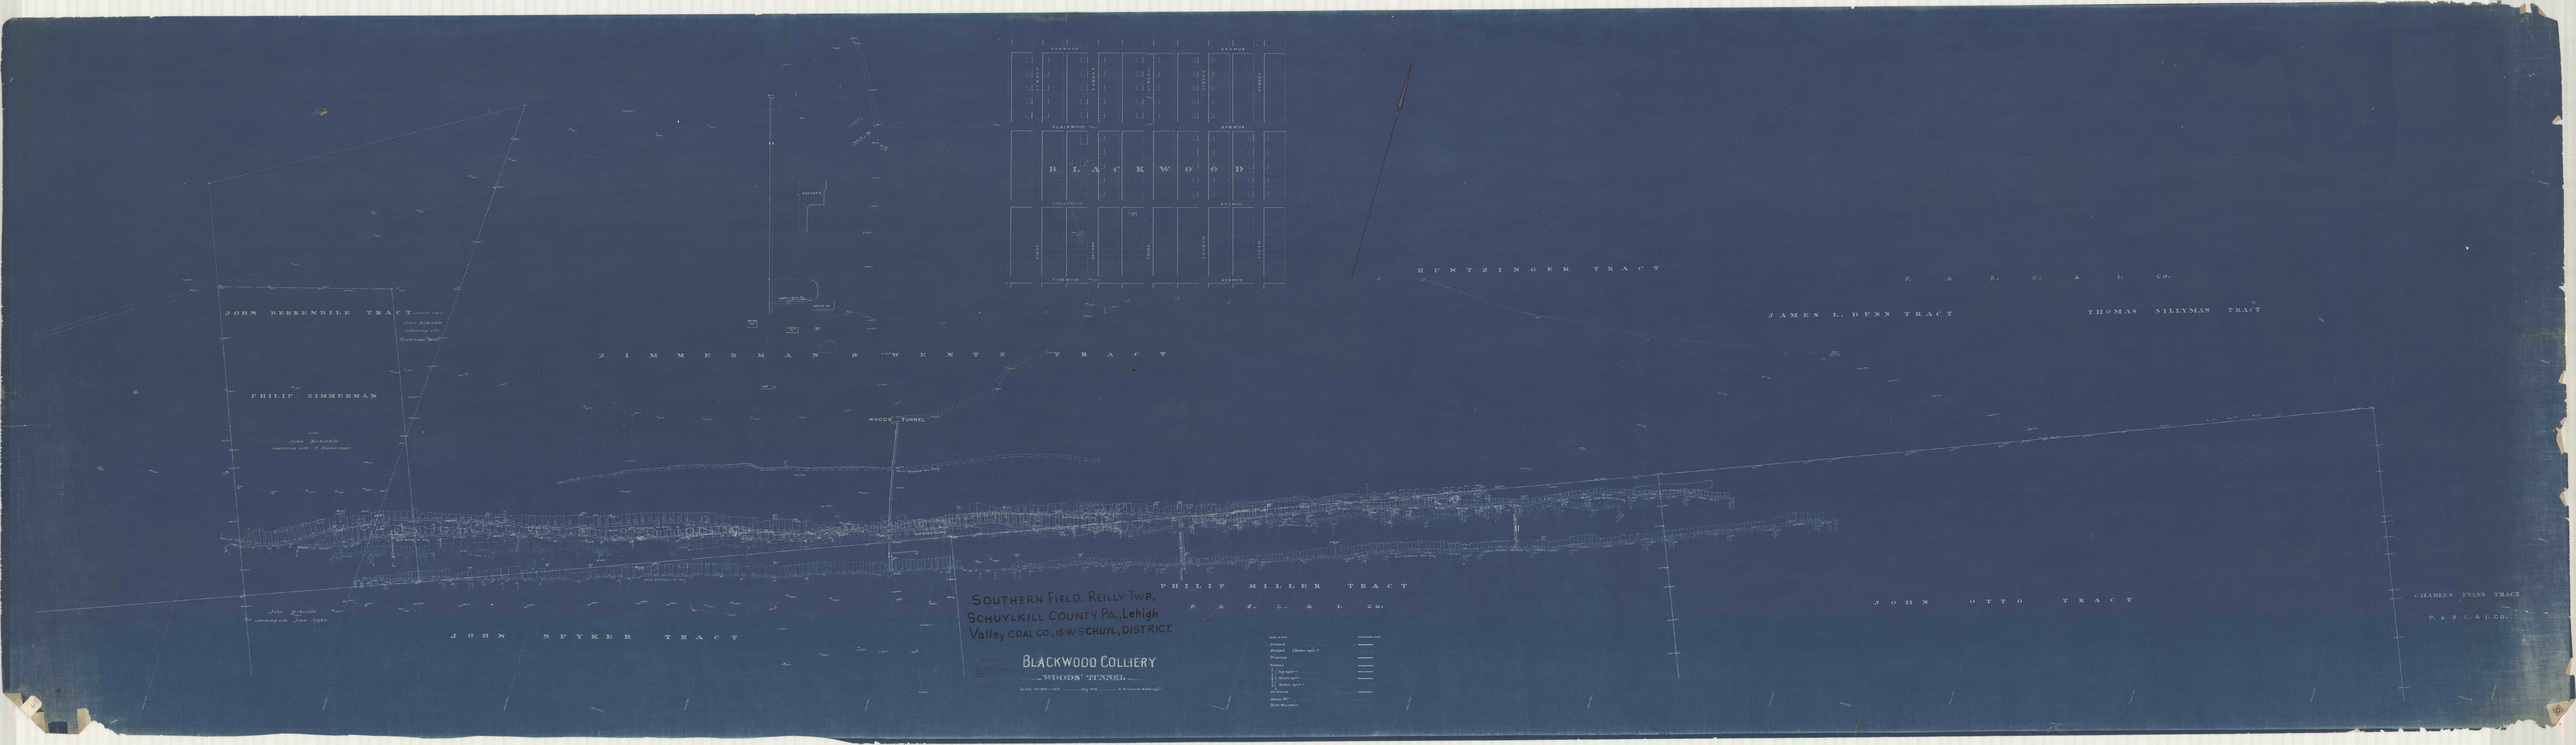
PARKWOOD AVENUE
PLAINWOOD AVENUE
GIRLWOOD AVENUE
PINEWOOD AVENUE
B L A C K W O O D
JOHN BERKENBILE TRACT
PHILIP ZIMMERMAN
Z I M M E R M A N & W E N T Z T R A C T
WOODS' TUNNEL
JOHN STYKER TRACT
PHILIP MILLER TRACT
P. & R. C. & I. CO.
HUNTZINGER TRACT
P. & R. C. & I. CO.
JAMES L. DUNN TRACT
THOMAS SILLYMAN TRACT
JOHN OTTO TRACT
CHARLES EVANS TRACT
P. & R. C. & I. CO.
SOUTHERN FIELD. REILLY Twp,
SCHUYLKILL COUNTY PA. LEHIGH
VALLEY COAL CO., 15 W. SCHUYL. DISTRICT
BLACKWOOD COLLIERY
WOODS' TUNNEL