


Western Middle Field:
Big Mtn., Colliery #2 & T.V.N.S.
Coal Twp. Northumberland Co. Pa.,
Shamokin District No: 1.
Reading Anthracite Collieries

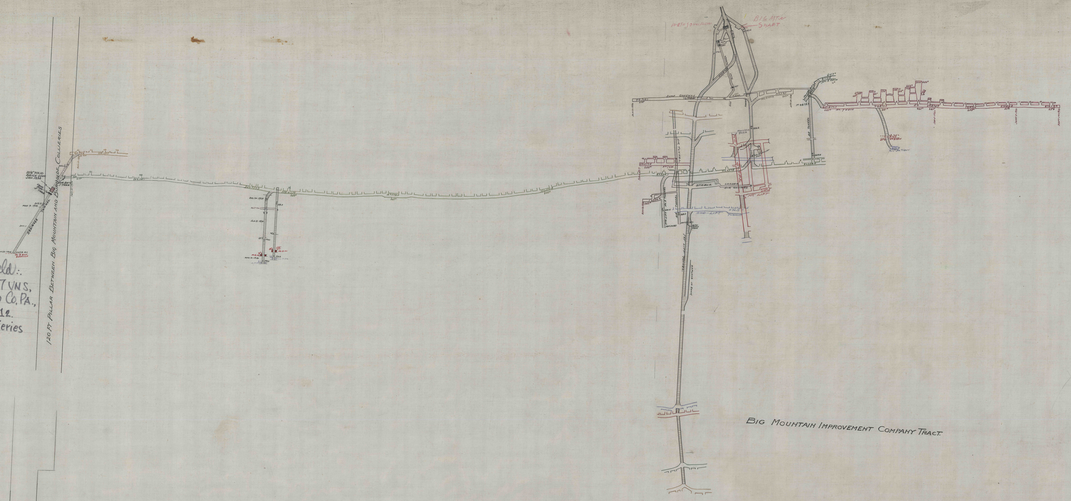

Big Mountain Improvement Company Tract.

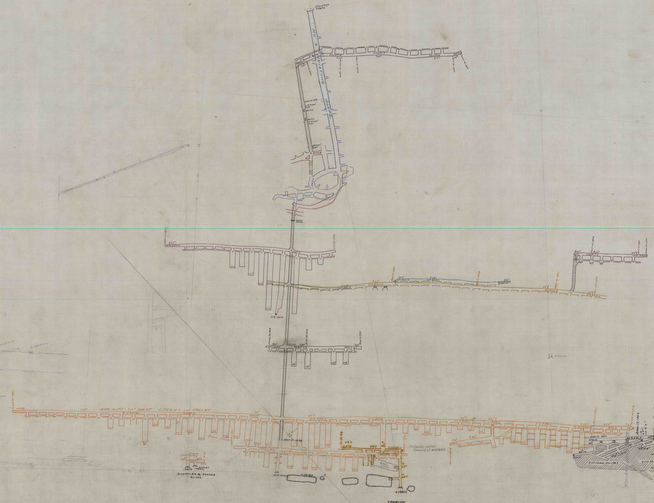

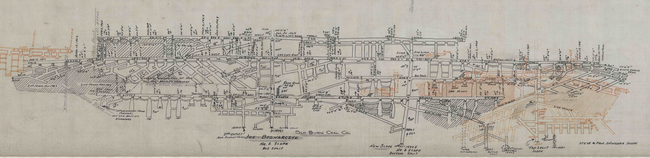



Western Middle Field - Big Mtn. Colliery #2 & T.V.N.S.
Coal Twp. Northumberland Co. Pa.
Shamokin District