


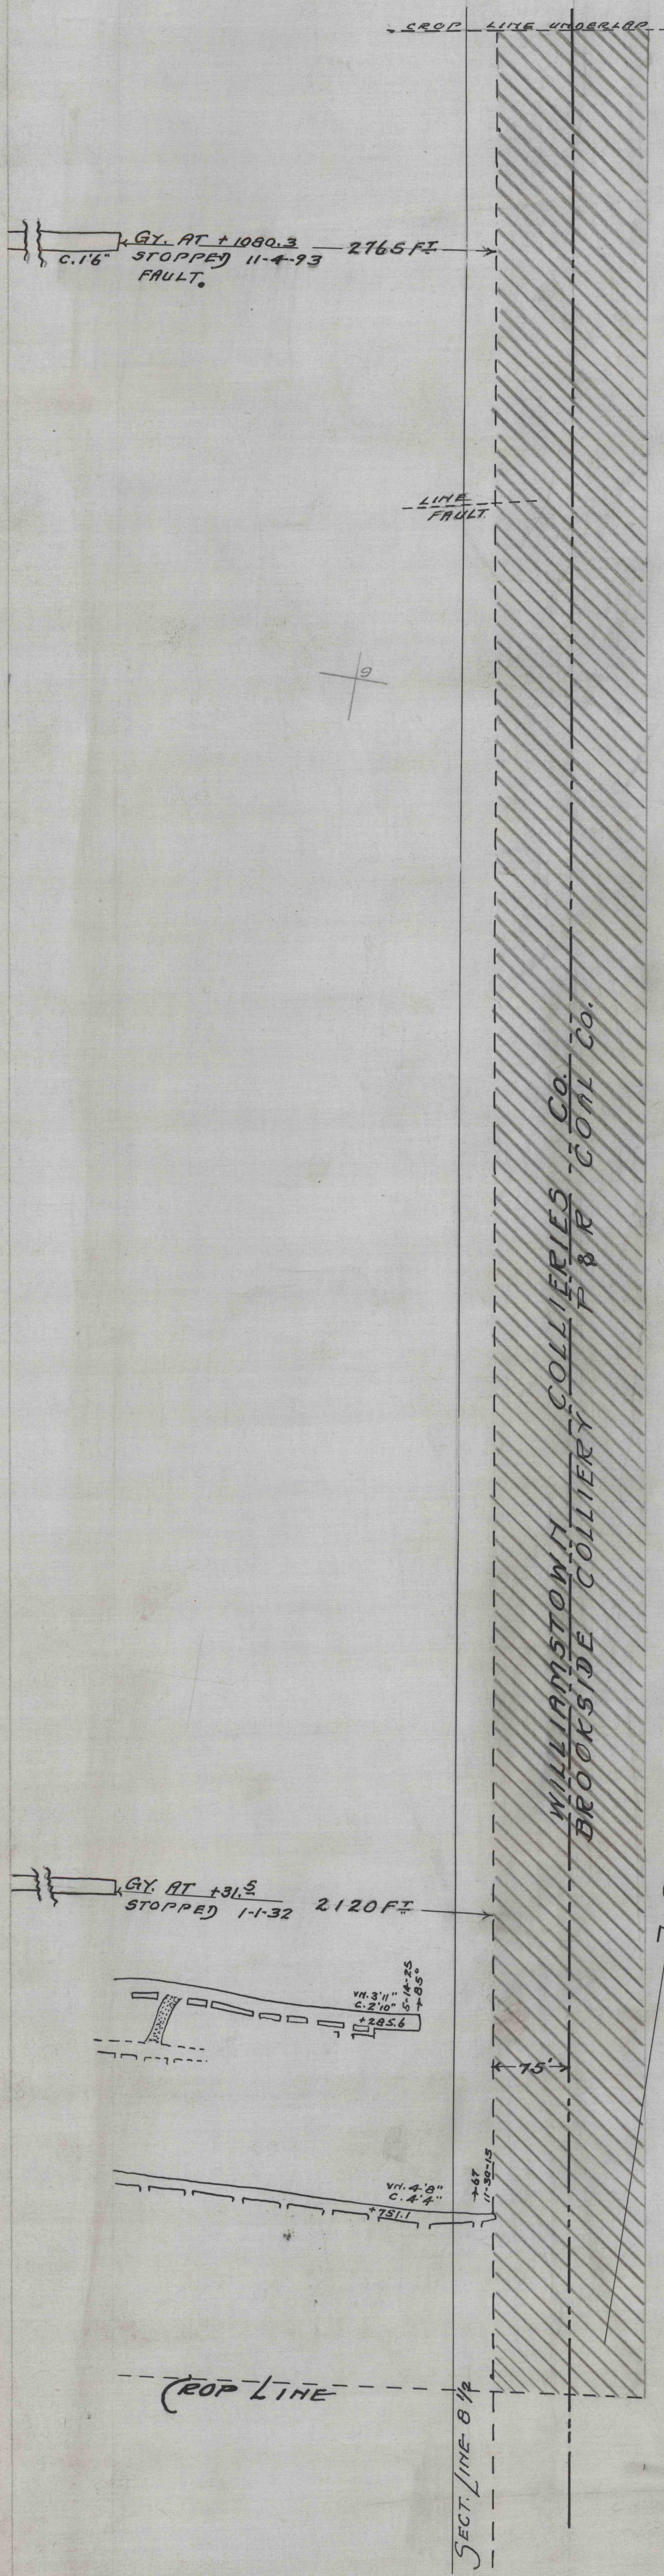

SOUTHERN COAL FIELD:
 BROOKSIDE-WILLIAMSTOWN COLLIERIES..PORTER TWP,
 DAUPHIN-SCHUYLKILL COUNTIES..17. LYKENS VALLEY DISTRICT.

..NO. 9 VEIN..
 SCALE: 1" = 100'