


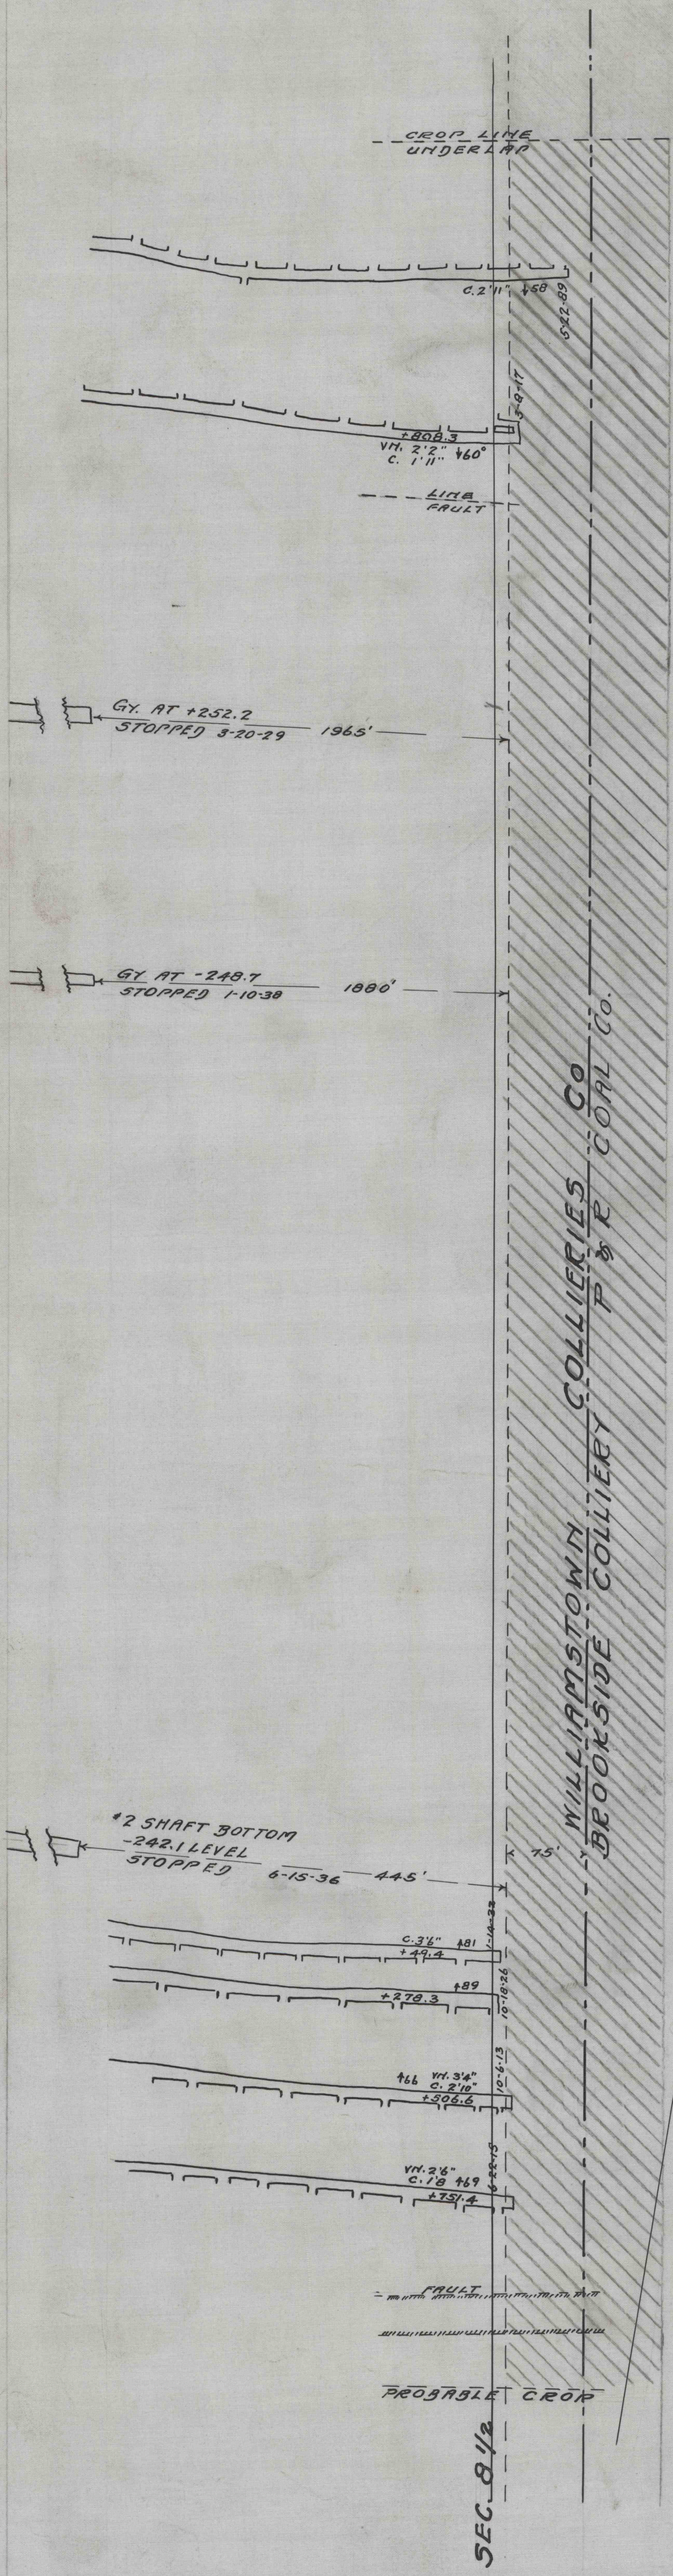

..SOUTHERN COAL FIELD..
 BROOKSIDE-WMS'TOWN COLLIERIES..PORTER TWP.,
 DAUPHIN-SCHUYLKILL COUNTIES..17 LYKENS VALLEY DISTRICT.

No: 11 VEIN
 SCALE: 1"=100'

JUN 1972