


...SOUTHERN FIELD..Brookside & Wms'town Collieries
 ..BIG VEIN..1"-100'..Porter Twp..Schuylkill-Dauphin Counties,
 17. LYKEN VALLEY DISTRICT.

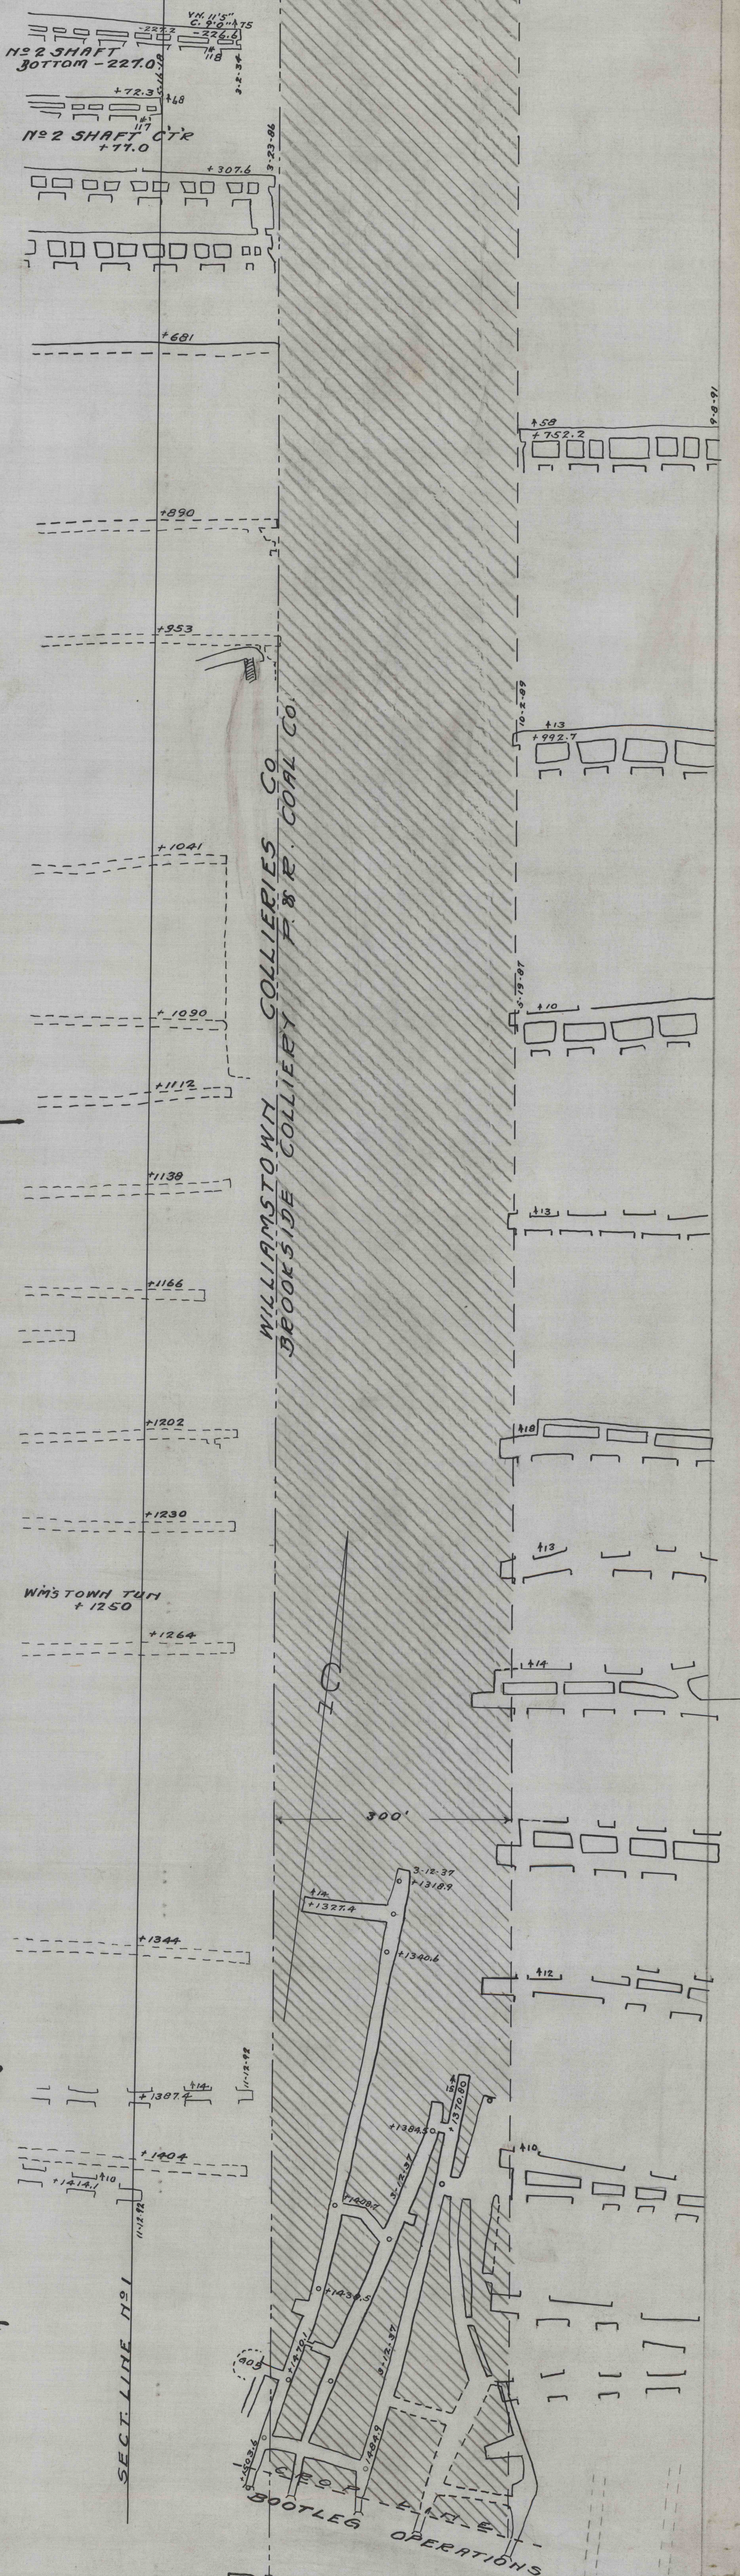

BIG VEIN
(LYKENS VALLEY)

SCALE 1" = 100'

MF
JUN 9 1972

#312

