


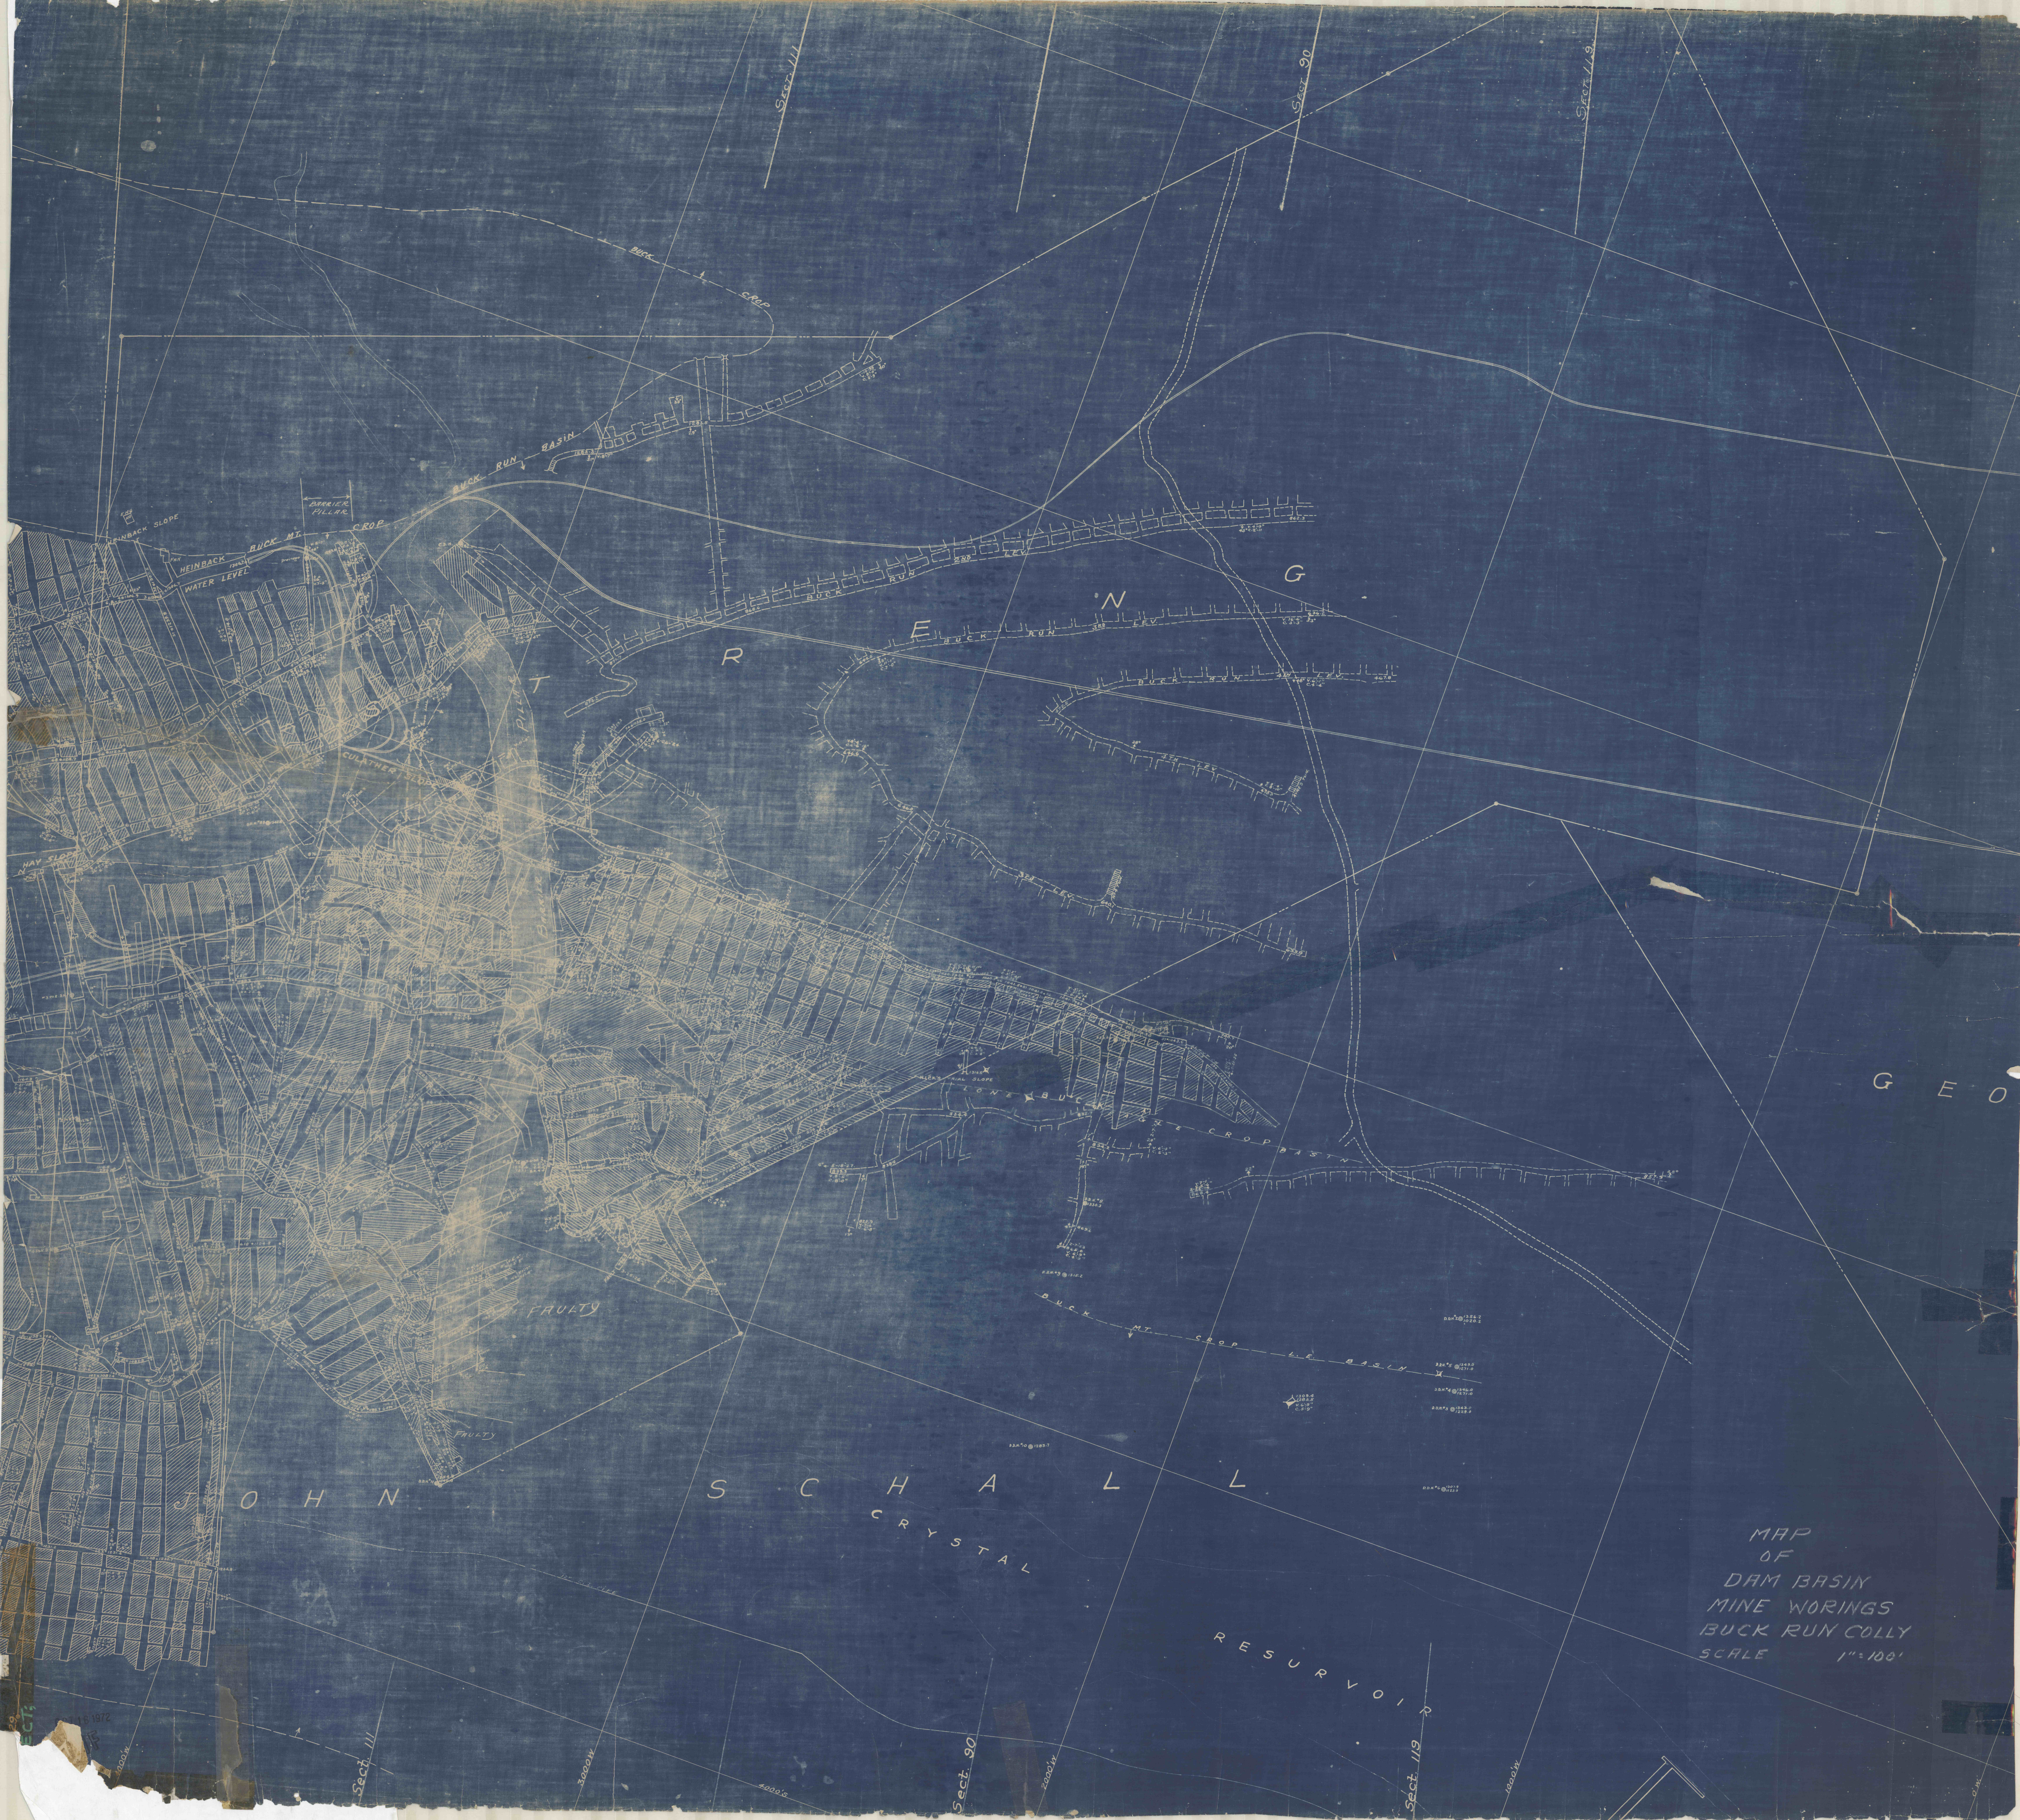

MAP
OF
DAM BASIN
MINE WORKINGS
BUCK RUN COLLY
SCALE 1"=100'