NOTTINGHAM (PARRISH) BALTIMORE VEIN

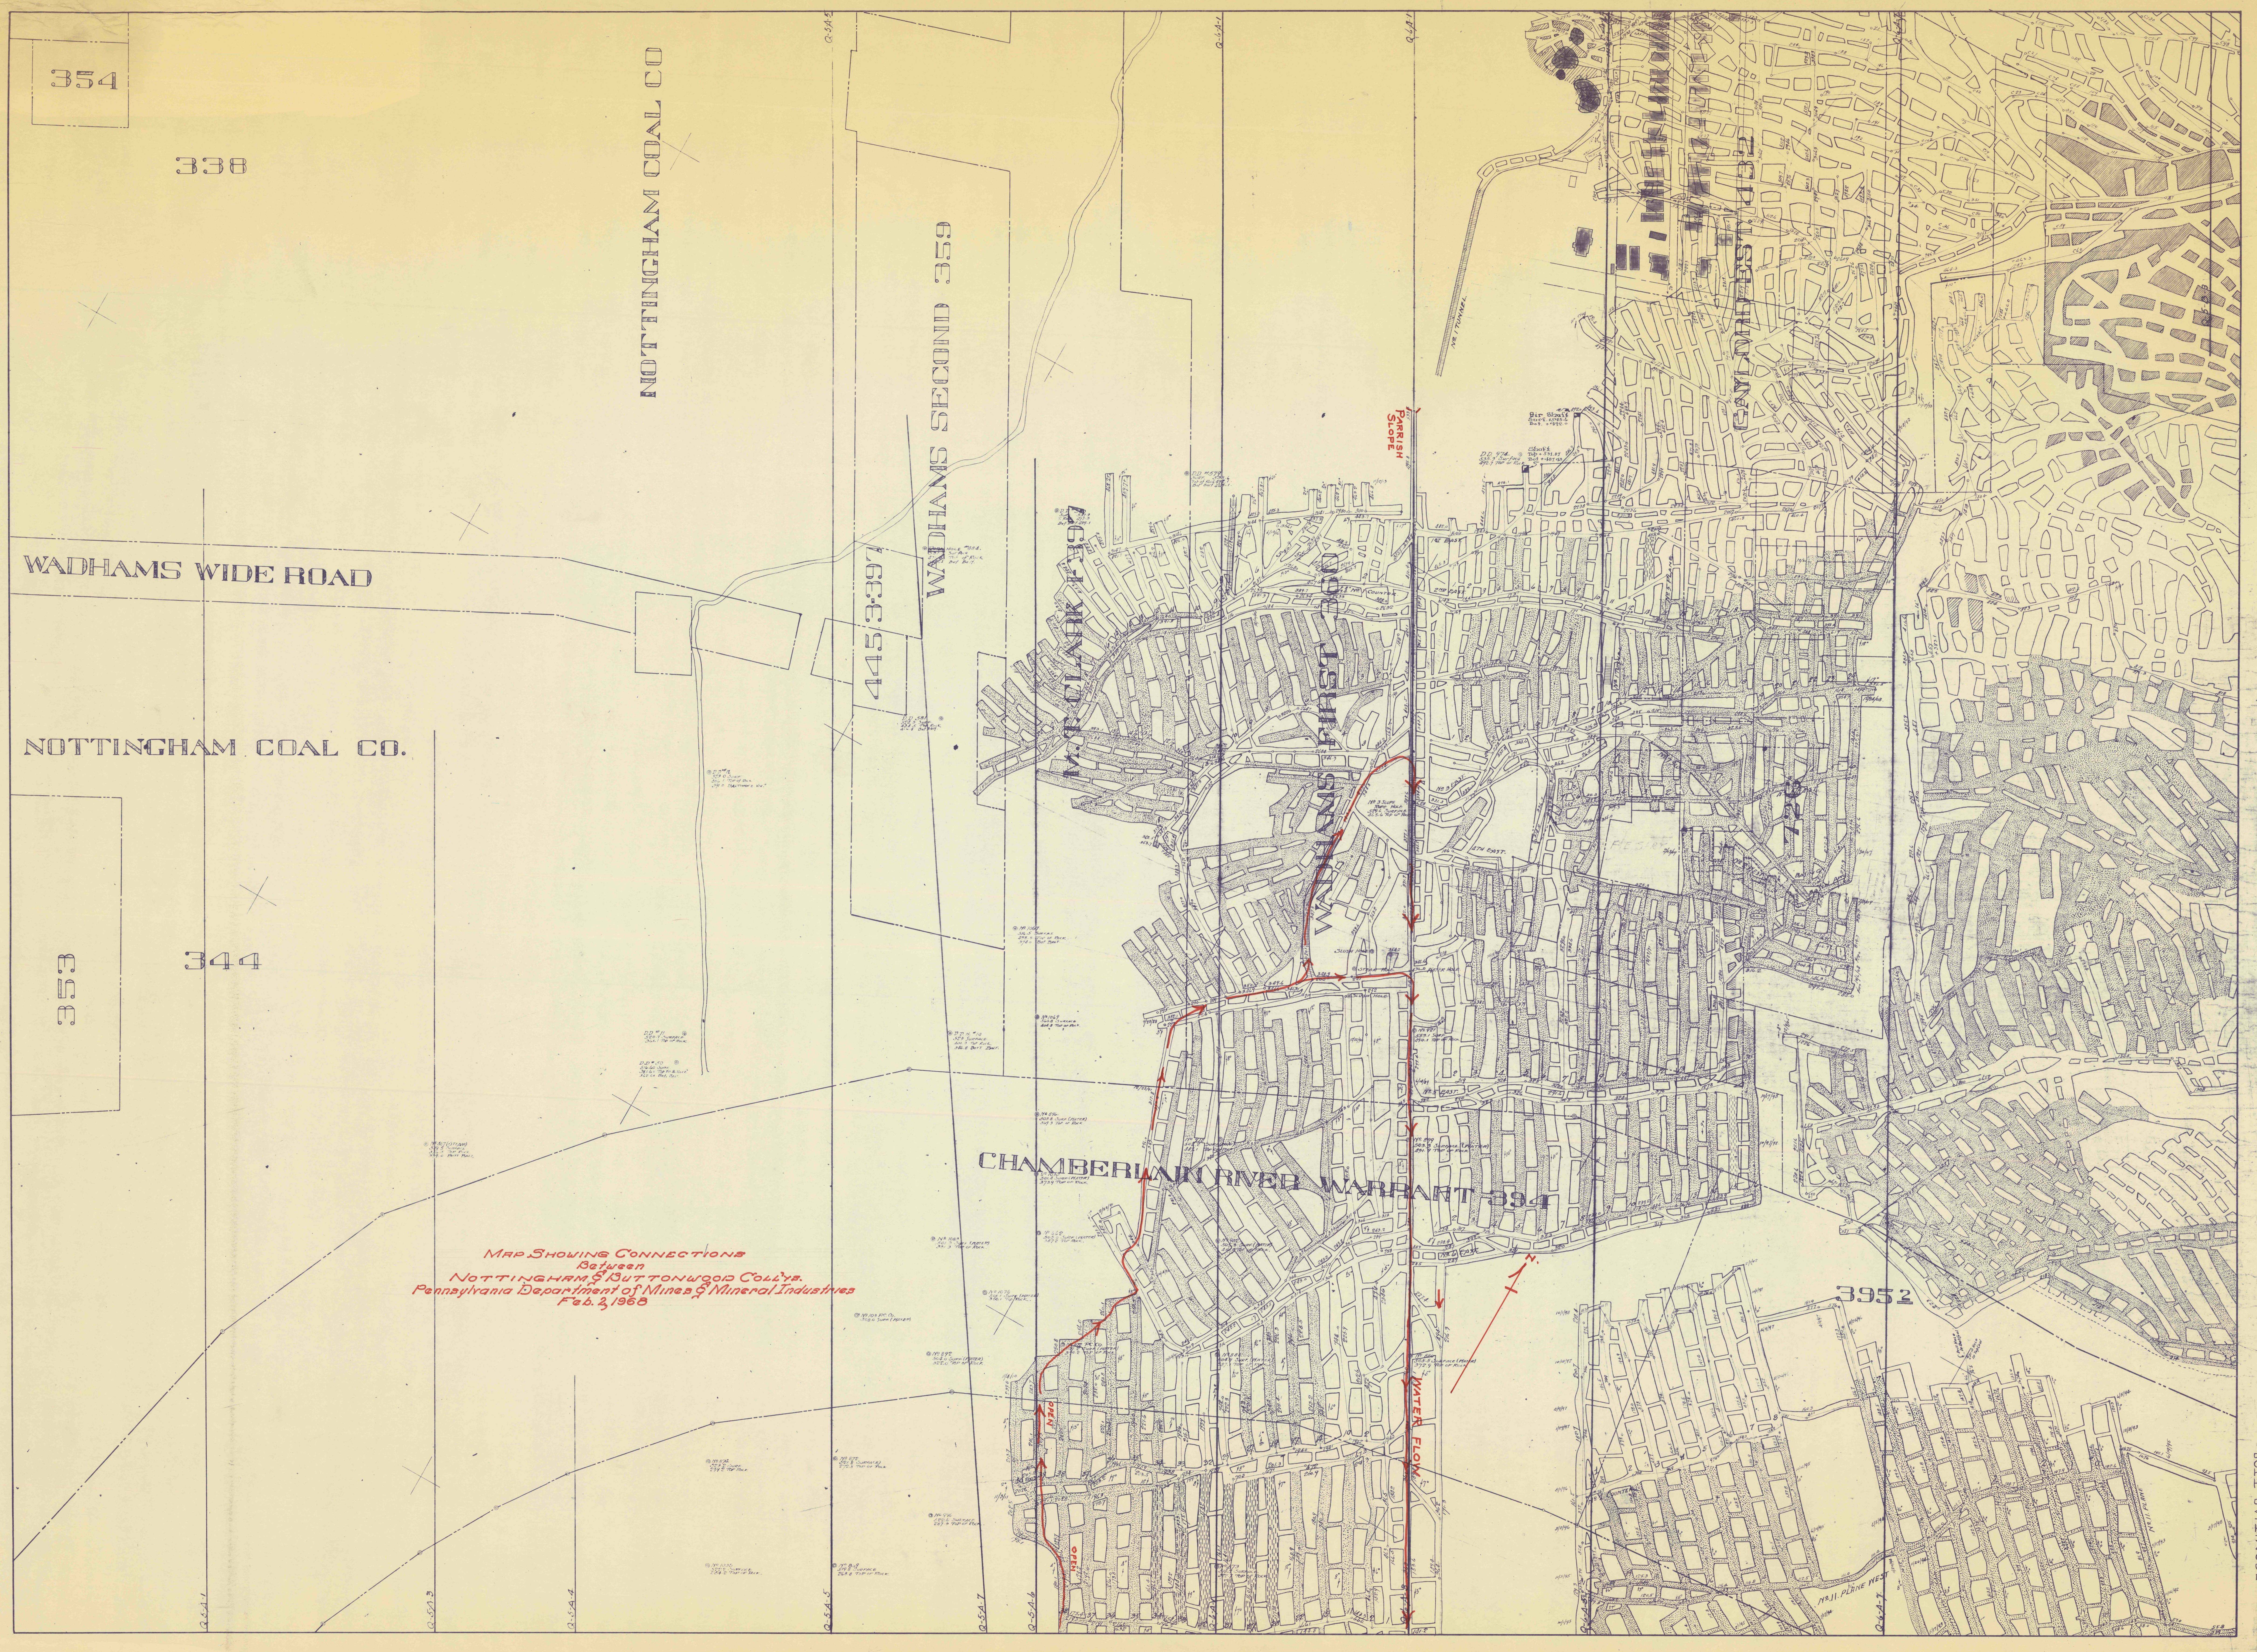
Map Showing Connections
Between
Nottingham & Buttonwood Coll'ys.
Pennsylvania Department of Mines & Mineral Industries
Feb. 2, 1968

NOTTINGHAM (PARRISH) BALTIMORE VEIN

BOTT BALTIMORE