
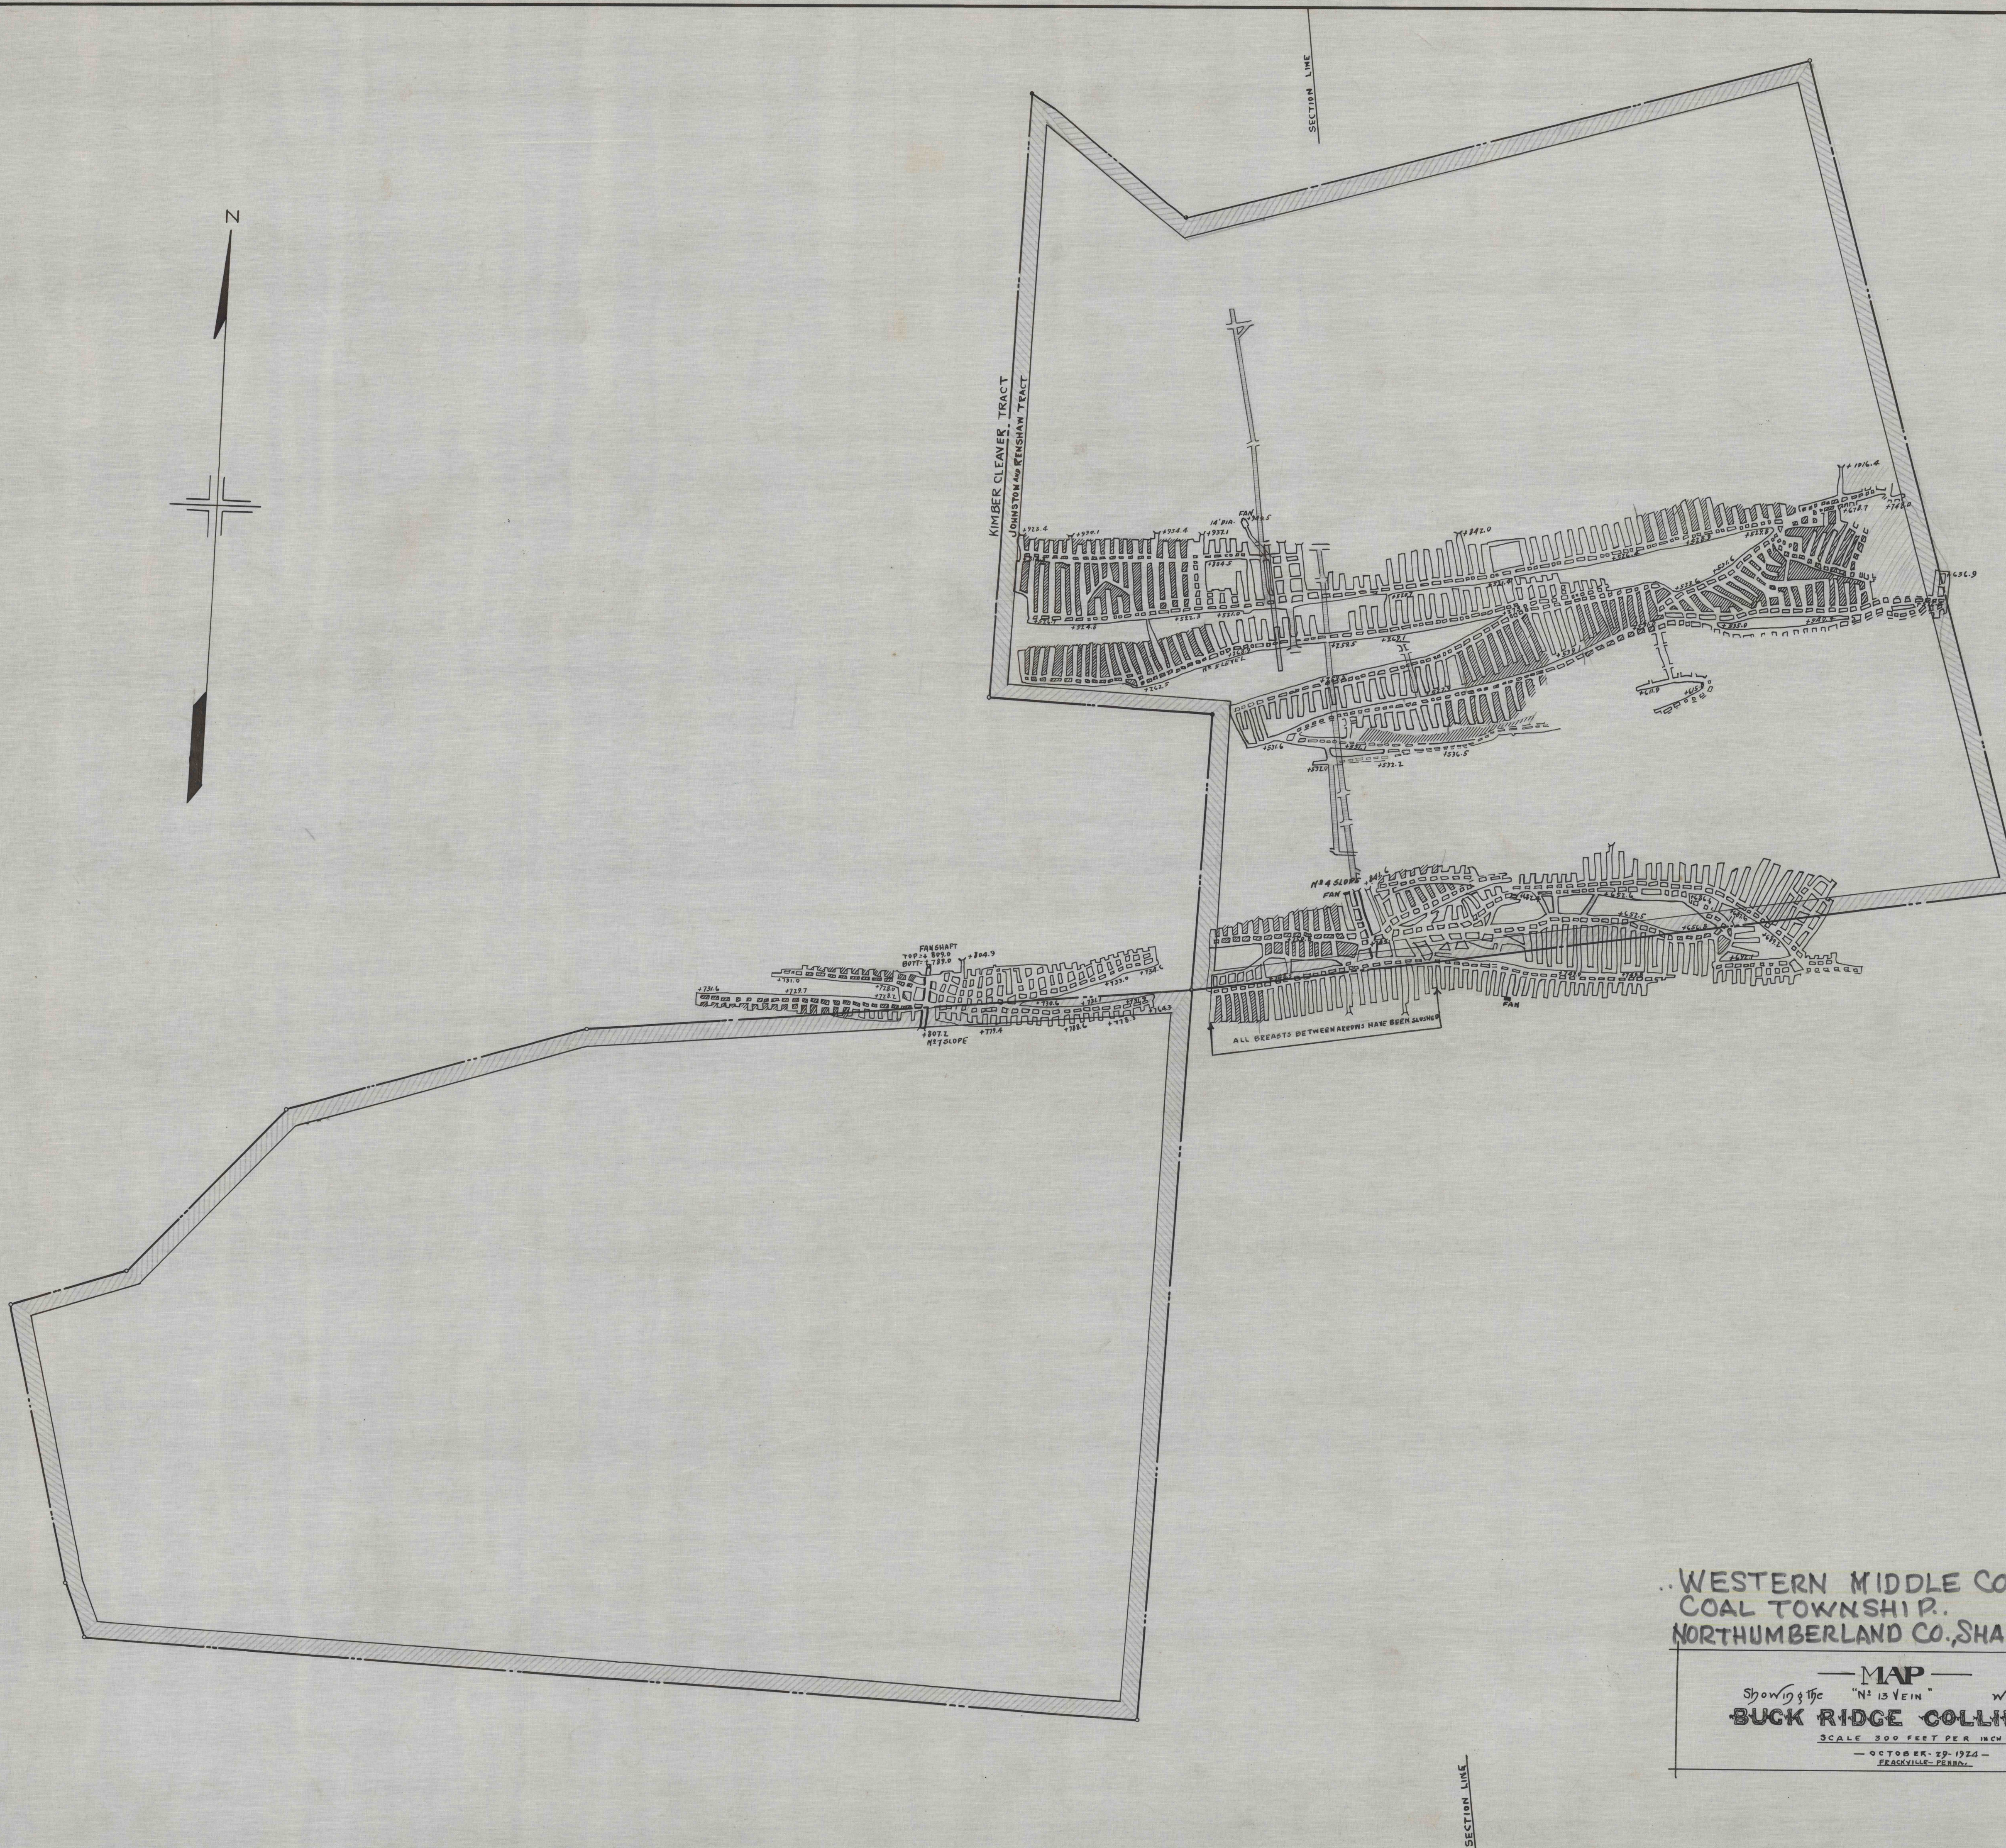


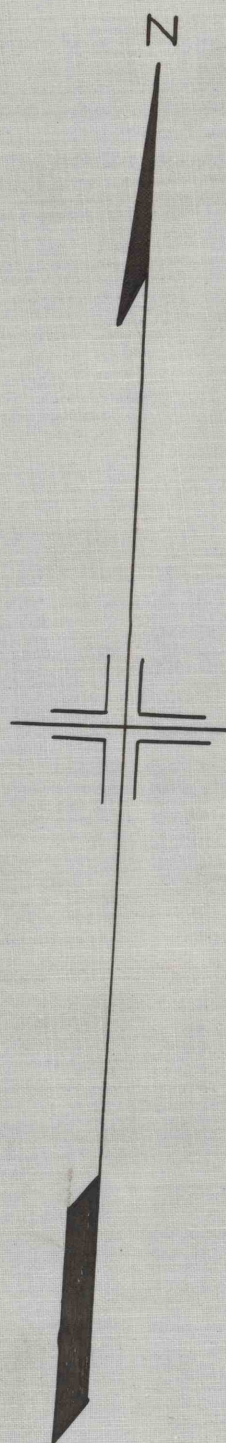

WESTERN MIDDLE COAL FIELD.
COAL TOWNSHIP.
NORTHUMBERLAND CO., SHAMOKIN, PA.

Showing the "N^o 13 VEIN" Working 65

BUCK RIDGE COLLIERY

SCALE 300 FEET PER INCH

— OCTOBER - 29 - 1974 —
FRACKVILLE - PENNSA.