


LOOKING WEST.

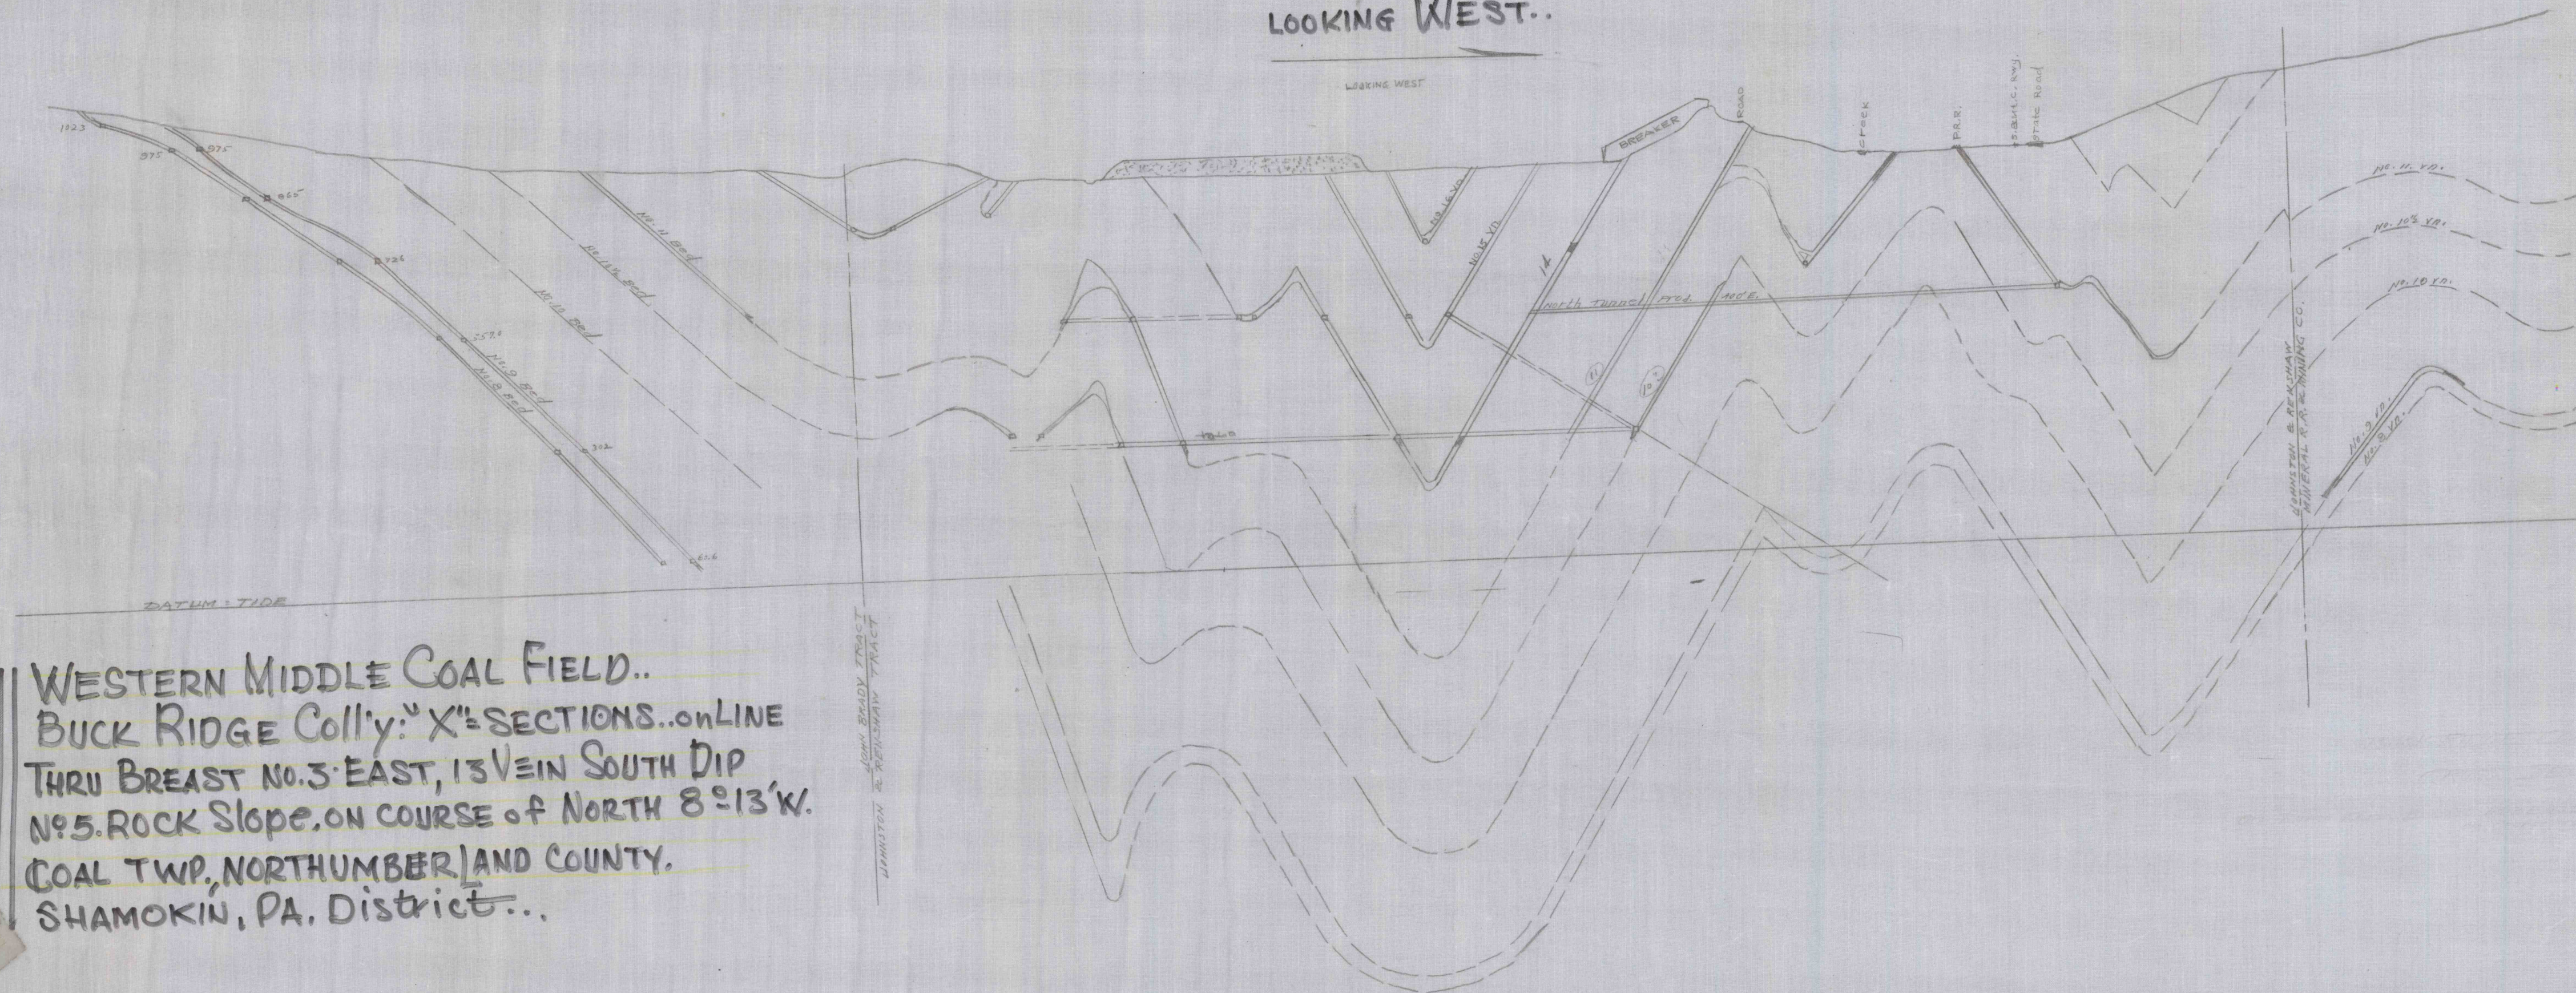

WESTERN MIDDLE COAL FIELD..
 BUCK RIDGE Coll'y. "X" SECTIONS..on LINE
 THRU BREAST NO. 3 EAST, 13 VEIN SOUTH DIP
 NO. 5. ROCK Slope, ON COURSE OF NORTH 8° 13' W.
 COAL TWP. NORTHUMBERLAND COUNTY.
 SHAMOKIN, PA. District..

#395

B

1 of 1